
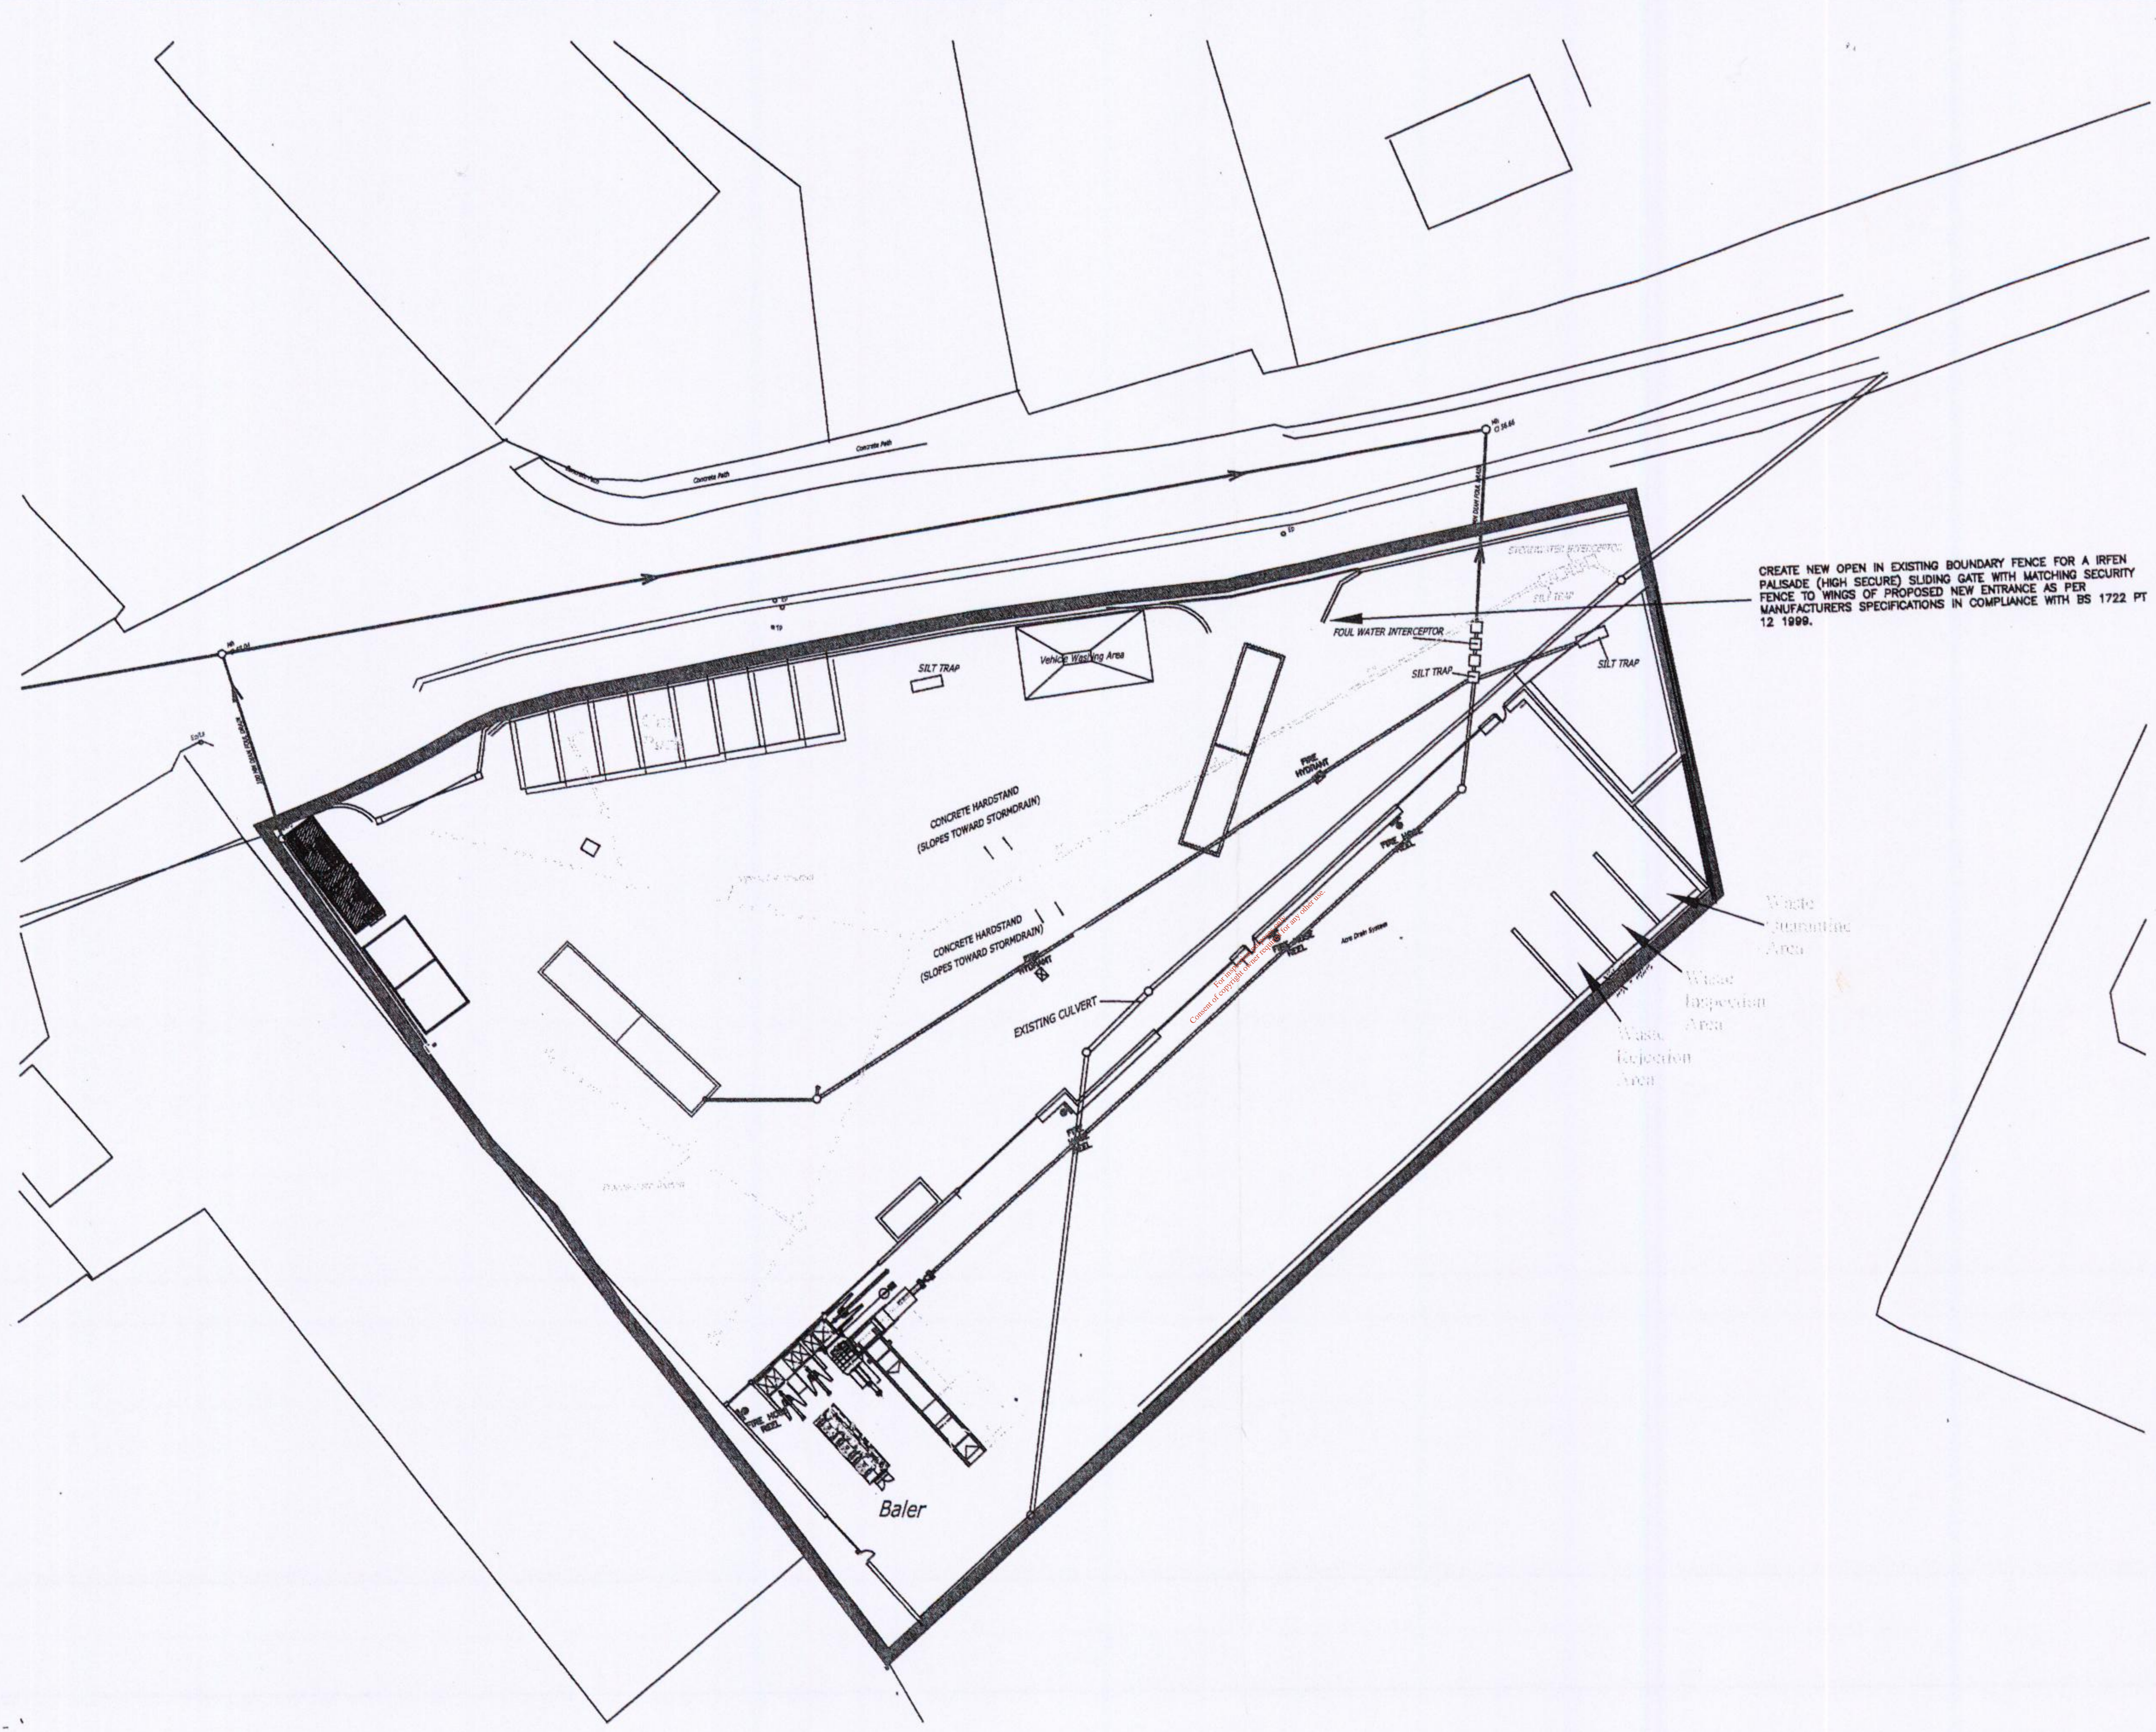


**APPENDIX 2:**  
**List of Drawings**  
**Drawing No. D.1: Site Infrastructure**

Consent of copyright owner required for any other use.  
For inspection purposes only.

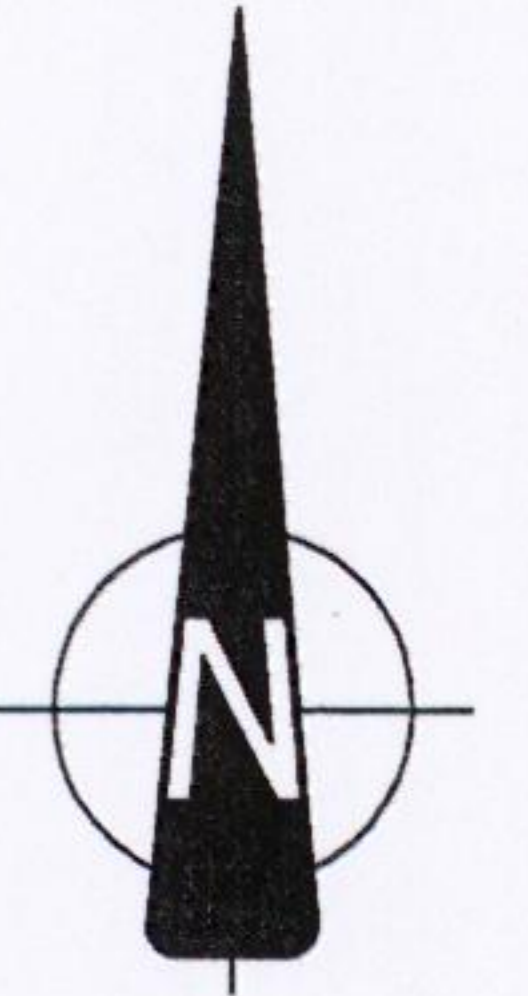

**LEGEND**

- Indicates Site Boundary
- Existing Weighbridge
- Proposed Weighbridge
- Surface Water Drainage
- Foul Sewer Drainage
- Existing Surface Water Culvert
- Existing Entrance
- Proposed Entrance

Rev.	DESCRIPTION	DATE

**BORD NA MÓNA**

**BORD NA MÓNA ENVIRONMENTAL LIMITED**

Main St, Newbridge, Co. Kildare  
 Phone 045 431201 Fax 045 432312  
 www.bnm.ie/environmental  
 Email: ed.info@bnm.ie

© Copyright Bord na Móna Environmental Ltd.  
 \*Copyright and ownership of this drawing is vested in Bord na Móna Environmental Ltd. whose prior written consent is required for its use, reproduction or for publication to a third party. All rights reserved by the law of copyright and by international copyright conventions are reserved to Bord na Móna Environmental Ltd. and may be protected by court proceedings for damages and/or injunctions and costs.

Project **Waste Licence Review Application**

Client **Oxygen Environmental Ltd.**

Drawing Title **Site Infrastructure**

Date	Scale	Drawn by	Checked by	Approved by
Sept 2004	1:500	DOQ	GL	NC

Status	FOR APPROVAL <input type="checkbox"/>	FOR CONSTRUCTION <input type="checkbox"/>	Dwg. No.  <b>D.1</b>
PLANNING <input type="checkbox"/>	AS BUILT <input checked="" type="checkbox"/>		
TENDER <input type="checkbox"/>			

© Ordnance Survey of Ireland. Government of Ireland  
 Ordnance Survey of Ireland Permit Number 0010502