

**LONGITUDINAL SECTION A - A' ALONG CENTRELINE OF EXISTING ACCESS ROAD**

HORIZONTAL SCALE 1:1000  
VERTICAL SCALE 1:500

**NOTES**

1. FIGURED DIMENSIONS ONLY TO BE TAKEN FROM THIS DRAWING
2. ALL DRAWINGS TO BE CHECKED BY THE CONTRACTOR ON SITE
3. ENGINEER TO BE INFORMED BY THE CONTRACTOR OF ANY DISCREPANCIES BEFORE ANY WORK COMMENCES
4. ALL LEVELS SHOWN RELATE TO ORDNANCE SURVEY DATUM AT MALIN HEAD

Rev	Date	Description	By	Chkd.
E	01-02-09	ISSUED FOR RE-SUBMISSION	VB	MC
D	10-11-08	ISSUED FOR SUBMISSION	VB	MN

Applicant: Shell E&P Ireland Limited  
Corrib House, 52 Leeson Street Lower,  
Dublin 2, Republic of Ireland.

Operator: BORD NA MÓNA

Project: CORRIB ONSHORE PIPELINE DEVELOPMENT

Aspect: SRAHMORE PEAT DEPOSITION SITE

Title: ACCESS ROAD LONGITUDINAL SECTION (As Built)

Scale @ A 1: AS SHOWN

Prepared by: V. Bonney  
Checked: M. Nolan  
Date: Feb 2009

Project Director: S. Finlay



**TOBIN**  
Patrick J. Tobin & Co. Ltd.

TOBIN Consulting Engineers,  
Block 10-4, Blanchardstown Corporate Park,  
Dublin 15, Ireland.  
tel: +353-(0)1-8030406  
fax: +353-(0)1-8030409  
e-mail: dublin@tobin.ie  
www.tobin.ie

Drawing No.: 4903-2032

Revision: E

Consent for inspection purposes only.  
Copyright owner required for any other use.

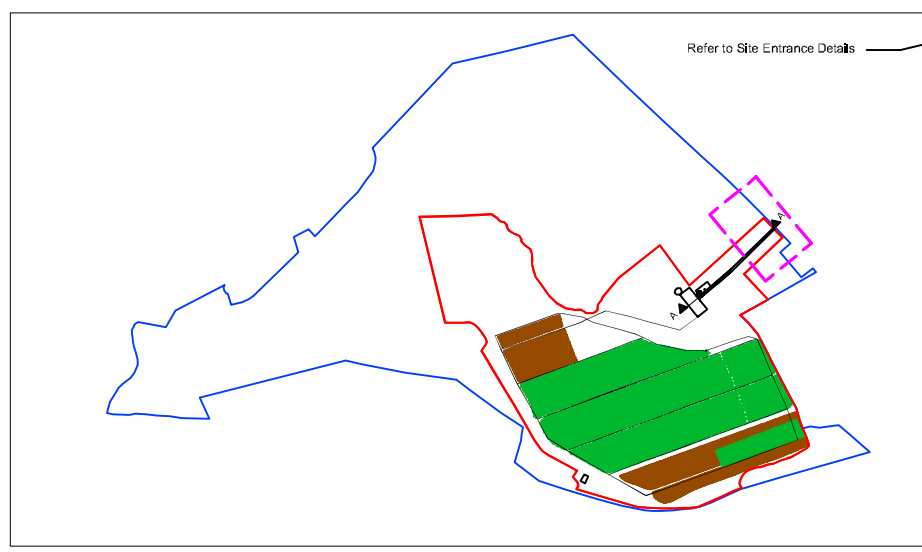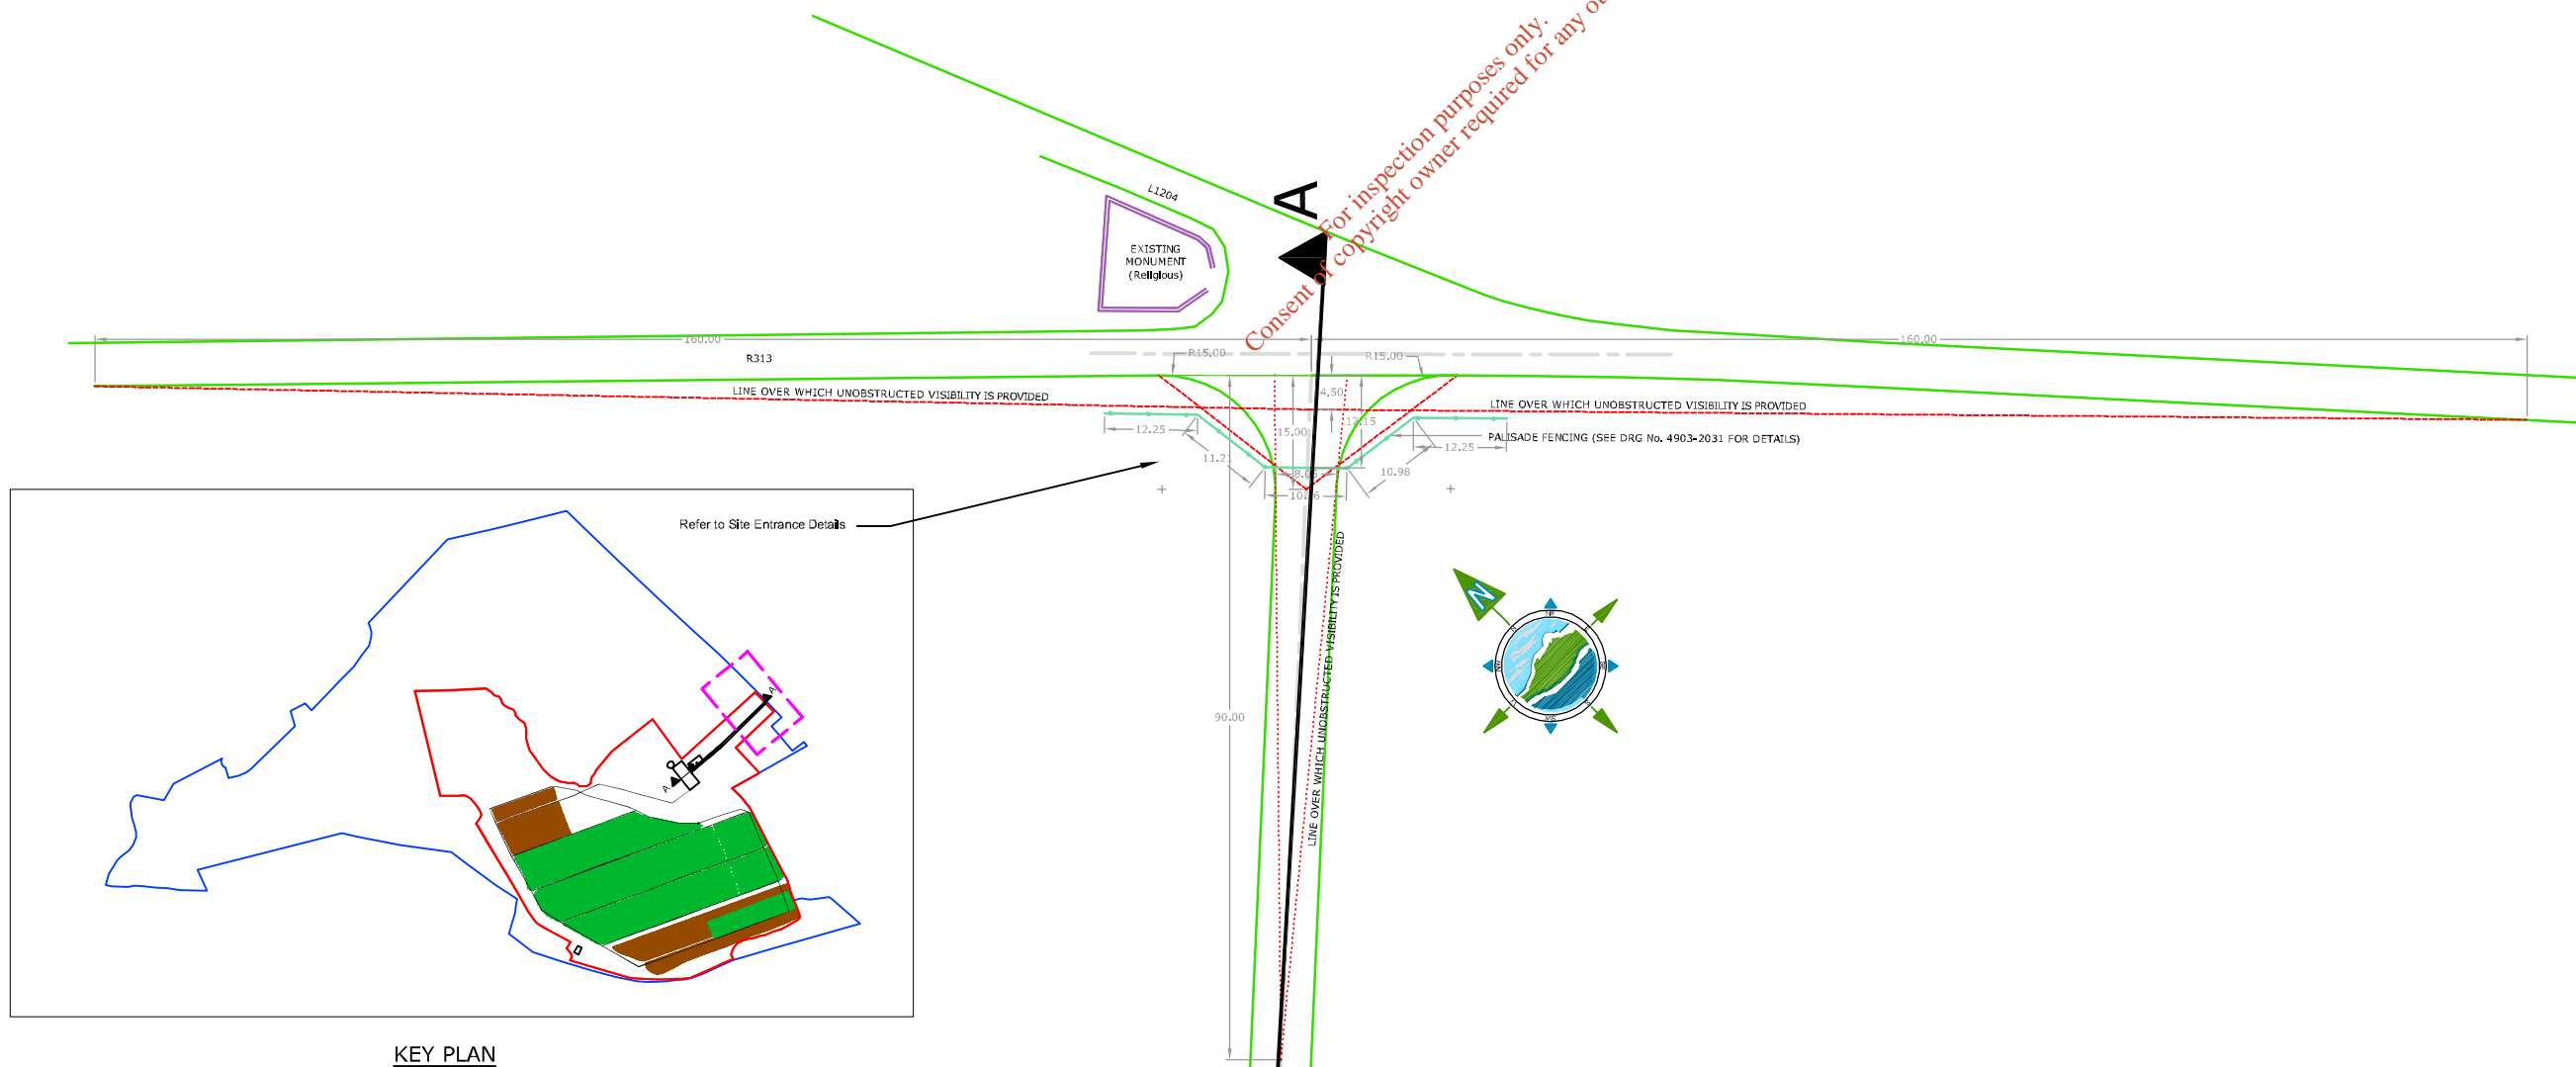

**KEY PLAN**  
N.T.S.

**SITE ENTRANCE DETAILS**  
SCALE 1:500