

Loretta Joyce
Inspector
Environmental Protection Agency
Office of Climate, Licensing & Resource Use
Environmental Licensing Programme
Richview
Clonskeagh Road
Dublin 14

Uisce Éireann
Bosca OP 6000
Baile Átha Cliath 1
Éire

Irish Water
PO Box 6000
Dublin 1
Ireland

T: +353 1 89 25000
F: +353 1 89 25001
www.water.ie

12th September 2014

IW-ER-LT0027

Re: Regulation 18(3)(b) Kilworth Waste Water Discharge Licence Application (D0334-01)

Dear Loretta Joyce,

In response to the Regulation 18(3)(b) request for further information notice dated the 10th of March 2014, please see below relevant information.

Provide an updated agglomeration map to include the waste water treatment plant in the red line boundary


The Kilworth agglomeration map has been revised to incorporate the entire sewer network and the waste water treatment plant site.

Please see attached the revised agglomeration map and a list of the drawing tiles, drawing numbers and any associated revisions.

Best Regards,



Gerry Galvin
Chief Technical Advisor

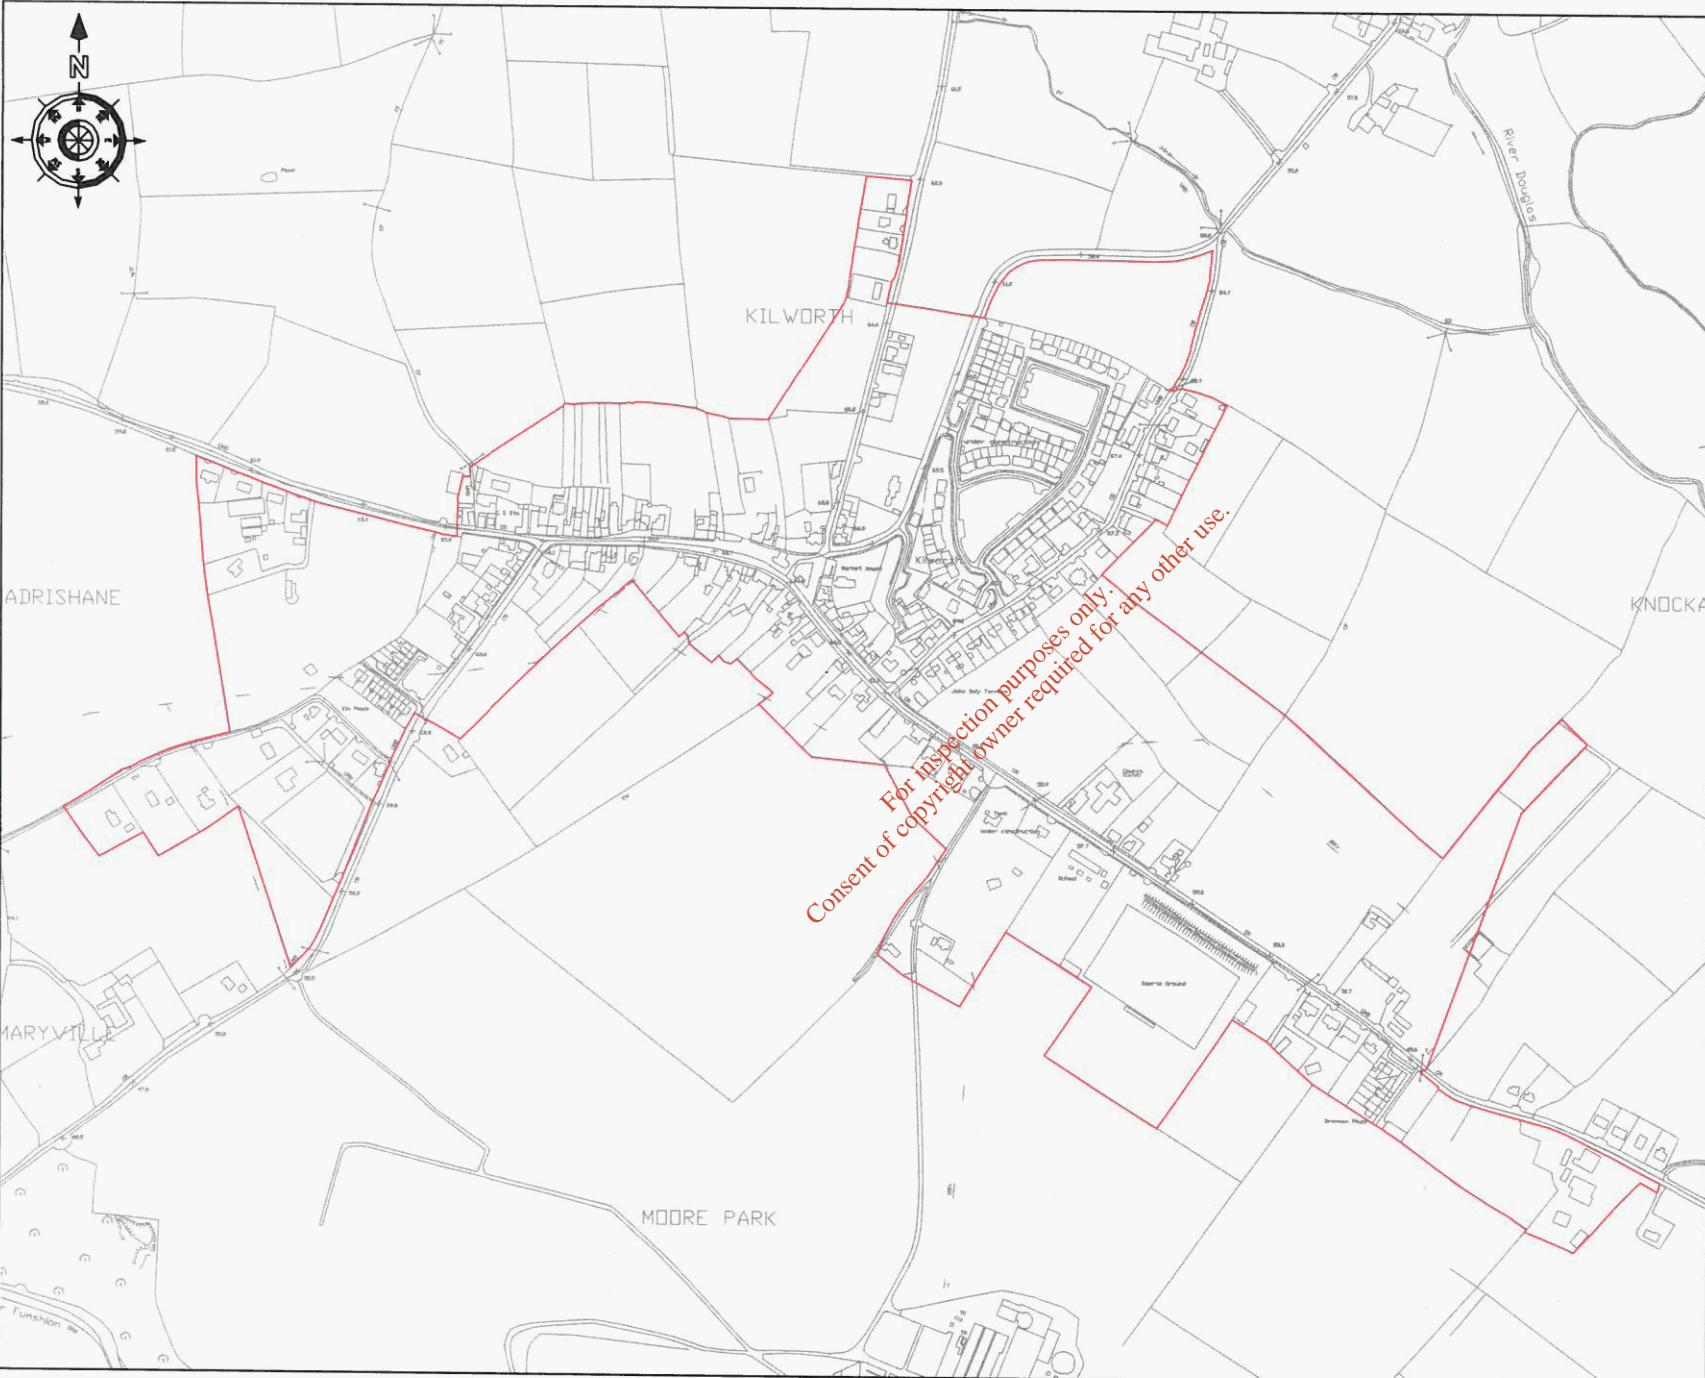

NOTES

1. Dimensions are not to be scaled from drawing. For any discrepancies found consult with the design office.
2. This drawing is to be read in conjunction with the Specification.
3. This drawing is to be read in conjunction with all other contract drawings.

No.	Date	Drawn/Checked	Revision Description
B	08/14	D.L.	2008 Change to Agglomeration Boundary
A	05/14	D.L.	2008 Change to Agglomeration Boundary

**Cork County Council,
Northern Division.**



**N. O'KEEFE, B.E.,
COUNTY ENGINEER,
COUNTY HALL,
CORK.**

Job Title: Kilworth & Environs
Waste Water Discharge
Licence Application

Drawing Title:
Agglomeration Boundary
Attachment B1 - Map 4

Scale: N.T.S	Surveyed by: D.L.	Drawn by: D.L.
Designed by: F.J.	Checked by: F.C.	Date: August 2008

Drawing number: B1 - Map 4	Rev: B
--------------------------------------	------------------