

Comhairle Contae Chorcaí Cork County Council

Environmental Licensing Programme,
Office of Climate, Licensing & Resource Use,
Environmental Protection Agency,
Headquarters, P.O. Box 3000,
Johnstown Castle Estate,
Co. Wexford.

Annabella,
Mala,
Co. Chorcaí.
Fón: (022) 21123 • Faics: (022) 21983
Suíomh Gréasáin: www.corkcoco.ie
Annabella,
Mallow,
Co. Cork.
Tel: (022) 21123 • Fax: (022)21983
Web: www.corkcoco.ie



For Attention of: Ms Loretta Joyce

10th June, 2013

**Re: Licensing Action - Reg 18(3)(b) Notice Sent - 3 for Kildorrery
Licence (D0442-01)**

A Chara,

I refer to correspondence issued on 16/05/2013 in relation to the above. The following addresses the queries which were raised.

REGULATION 16 COMPLIANCE REQUIREMENTS

Question *Provide a revised map of the Agglomeration boundary which shows all areas of the agglomeration located within, and connected by, the red line boundary including the waste water treatment plant.*

Response Revised drawing detailing the boundary of the agglomeration has been prepared and is attached to this letter. (Drawing No. B1 – Map 4, Agglomeration Boundary, Revision A) The revised agglomeration boundary includes all areas of the agglomeration.

Question *Provide primary discharge sampling co-ordinates (6E, 6N grid reference)*

Response Primary Discharge Sampling Co-Ordinates are E 171599, N 110652.

No revisions to the Non-Technical Summary are required consequent to the above information. See also attached, Revised Drawing Schedule for WWDL Application D0442-01.

Is mise le meas,

Denis Beecher.
Executive Engineer.
Waste Water Pumping & Treatment Zone 4,
WATER SERVICES DIRECTORATE


Direct Tel: 022-21123
Email: denis.beecher@corkcoco.ie



Revised Drawing Schedule, Kildorrery WWDL, D0442-01.

Drawing No.	Drawing Title.	Revision.
A1 – Map 1	Location Map Scale 1:50,000 Attachment A1 – Map 1	-
A1 – Map 2	Site Locations of WWTP & Pumping Station Attachment A1 – Map 2	-
A1 – Map 3	Waste Water Treatment Plant Site Layout Attachment A1 – Map 3	-
B1 – Map 4	Agglomeration Boundary Attachment B1 – Map 4	A
B2 – Map 5	Wastewater Treatment Plant Site Layout Attachment B2 – Map 5	-
B3 – Map 6	Location of Primary Discharge Point SW01 – CLON Attachment B3 – Map 6	-
B3 – Map 7	Locations of Sampling Points Attachment B3 – Map 7	-
B8 – Map 8	Location of Site Notice Attachment B8 – Map 8	-
C1 – Map 9	Wastewater Treatment Plant Site Layout Attachment C1 – Map 9	-
C1- Drawing 1	Schematic showing Existing Treatment Plant Process Attachment C1 – Drawing 1	-

For inspection purposes only.
Consent of copyright owner required for any other use.

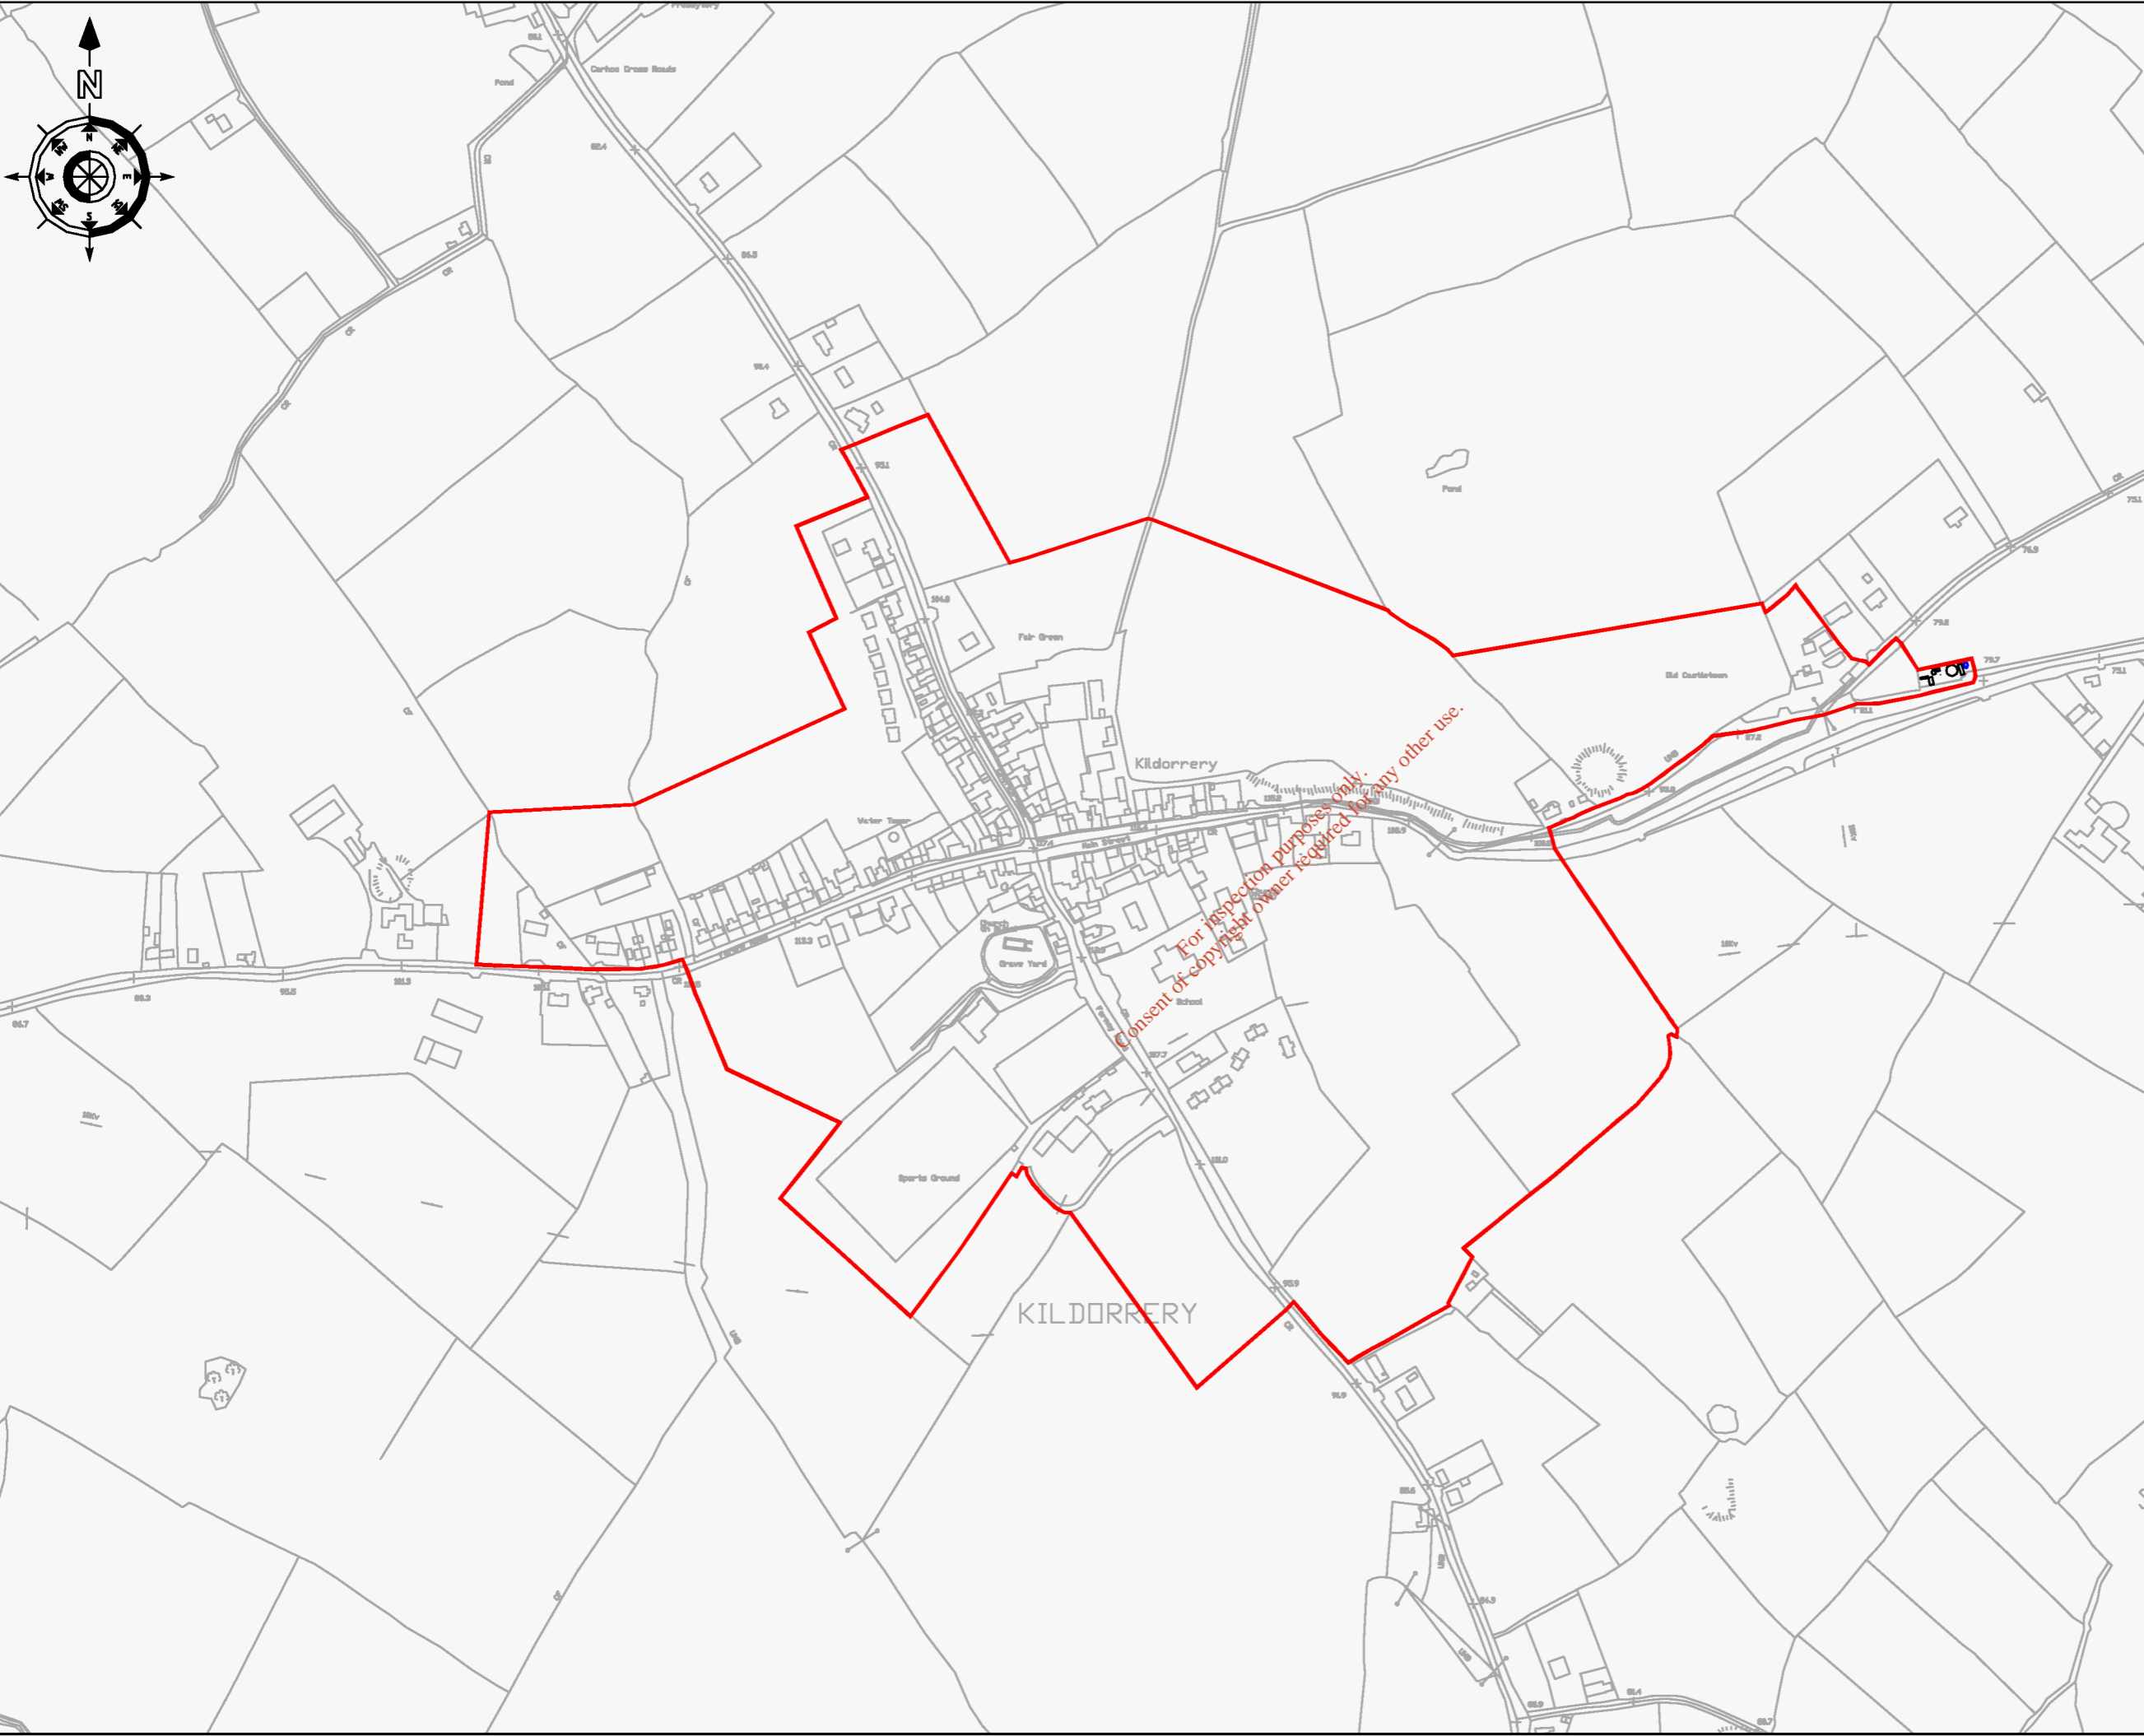

NOTES

1. Dimensions are not to be scaled from drawing. For any discrepancies found consult with the design office.
2. This drawing is to be read in conjunction with the Specification.
3. This drawing is to be read in conjunction with all other contract drawings.

No.	Date	Drawn	Survey	Checked	Revision Description
A	06/13	DL	DL	BOS	Revised Agglomeration boundary

**Cork County Council,
Northern Division.**

**N. O'KEEFE, B.E.,
COUNTY ENGINEER,
COUNTY HALL,
CORK.**

Job Title:
Kildorrery & Environs
Waste Water Discharge
Licence Application

Drawing Title:
Agglomeration Boundary
Attachment B1 - Map 4

Scales: 1:5,000 @ A3	Surveyed by: D.L.	Drawn by: D.L.
Designed by: E.M.	Checked by: F.C.	Date: June 2009
Drawing number: B1 - Map 4		Rev: A