

NOTE:
THIS DRAWING SUPERSEDES AND REPLACES
THE FOLLOWING DRAWING NUMBER:-
7558-40284

A	AS BUILT UPDATED	MS	05.01.18
REV	DESCRIPTION	NAME	DATE

Wyeth | Nutrition

Askeaton
Co Limerick

(C) All Rights Reserved. This drawing is the property of Nestlé and is not to be used or reproduced by unauthorised persons.

DRAWN BY: SMCA DATE: 04.01.18 SCALE: 1:1000 @ A1

DEPT/AREA: 50 FLOOR: ---

DRAWING TYPE: CIVILS-BUILDING DRAWING SUB-TYPE: LAYOUT

PROPOSAL NUMBER: PROJECT NUMBER:

PROJECT TITLE: MASTER

DRAWING TITLE: ASKEATON PLANT LAYOUT SURFACE WATER DRAINAGE

DRAWING STATUS: WORKING COPY


DRAWING NUMBER: 7558-43224 SHEET NUMBER: 1 of 1 REVISION: A

LEGEND:

STORMWATER DRAINAGE LEGEND

- NEW STORMWATER SYSTEM
- EXISTING STORMWATER SYSTEM
- EXISTING ROOF STORMWATER SYSTEM
- R.G. = ROAD GULLY
- S17 = MANHOLE
- R.W.P. = RAIN WATER PIPE
- = ACO MULTI DRAIN
- = MONITORING POINTS

NOTICE: THIS DRAWING HAS NOT BEEN PUBLISHED. IT IS THE PROPERTY OF WYETH NUTRITION IRELAND LTD AND IS FURNISHED TO THE RECIPIENT FOR CONFIDENTIAL USE ONLY. THE RECIPIENT PROMISES AND AGREES TO RETURN THIS DRAWING UPON REQUEST AND AGREES THAT IT SHALL NOT BE REPRODUCED, COPIED, LOANED OR OTHERWISE DISPOSED OF DIRECTLY OR INDIRECTLY, NOR USED FOR ANY OTHER PURPOSE OTHER THAN THAT FOR WHICH IT IS FURNISHED.

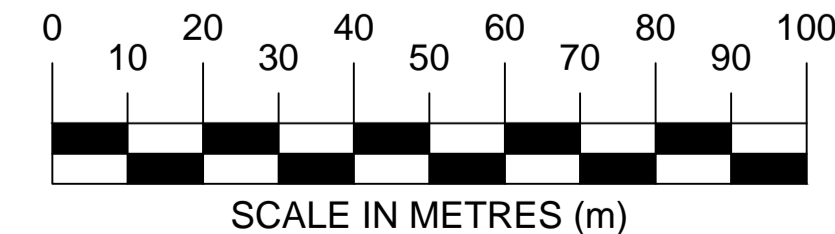

CONFIDENTIALITY CLASS
YELLOW