






Revisions	Comments	Dates
Client Ballynagran Landfill Limited		Date 18/06/2020
		Drawn BC
		Surveyor
Project title Ballynagran Residual Landfill		Approved TF
		Scale 1/6000-A3
Drawing title Revised Site Boundary 2020		Job No. 1006
		Dwg. No. 1006-IG 18-19
Landmark Surveying Johnstown Business Centre, Johnstown, Naas. Tel: 045254221 / 0877660437 E: info@landmarkes.ie W: www.landmarkes.ie		

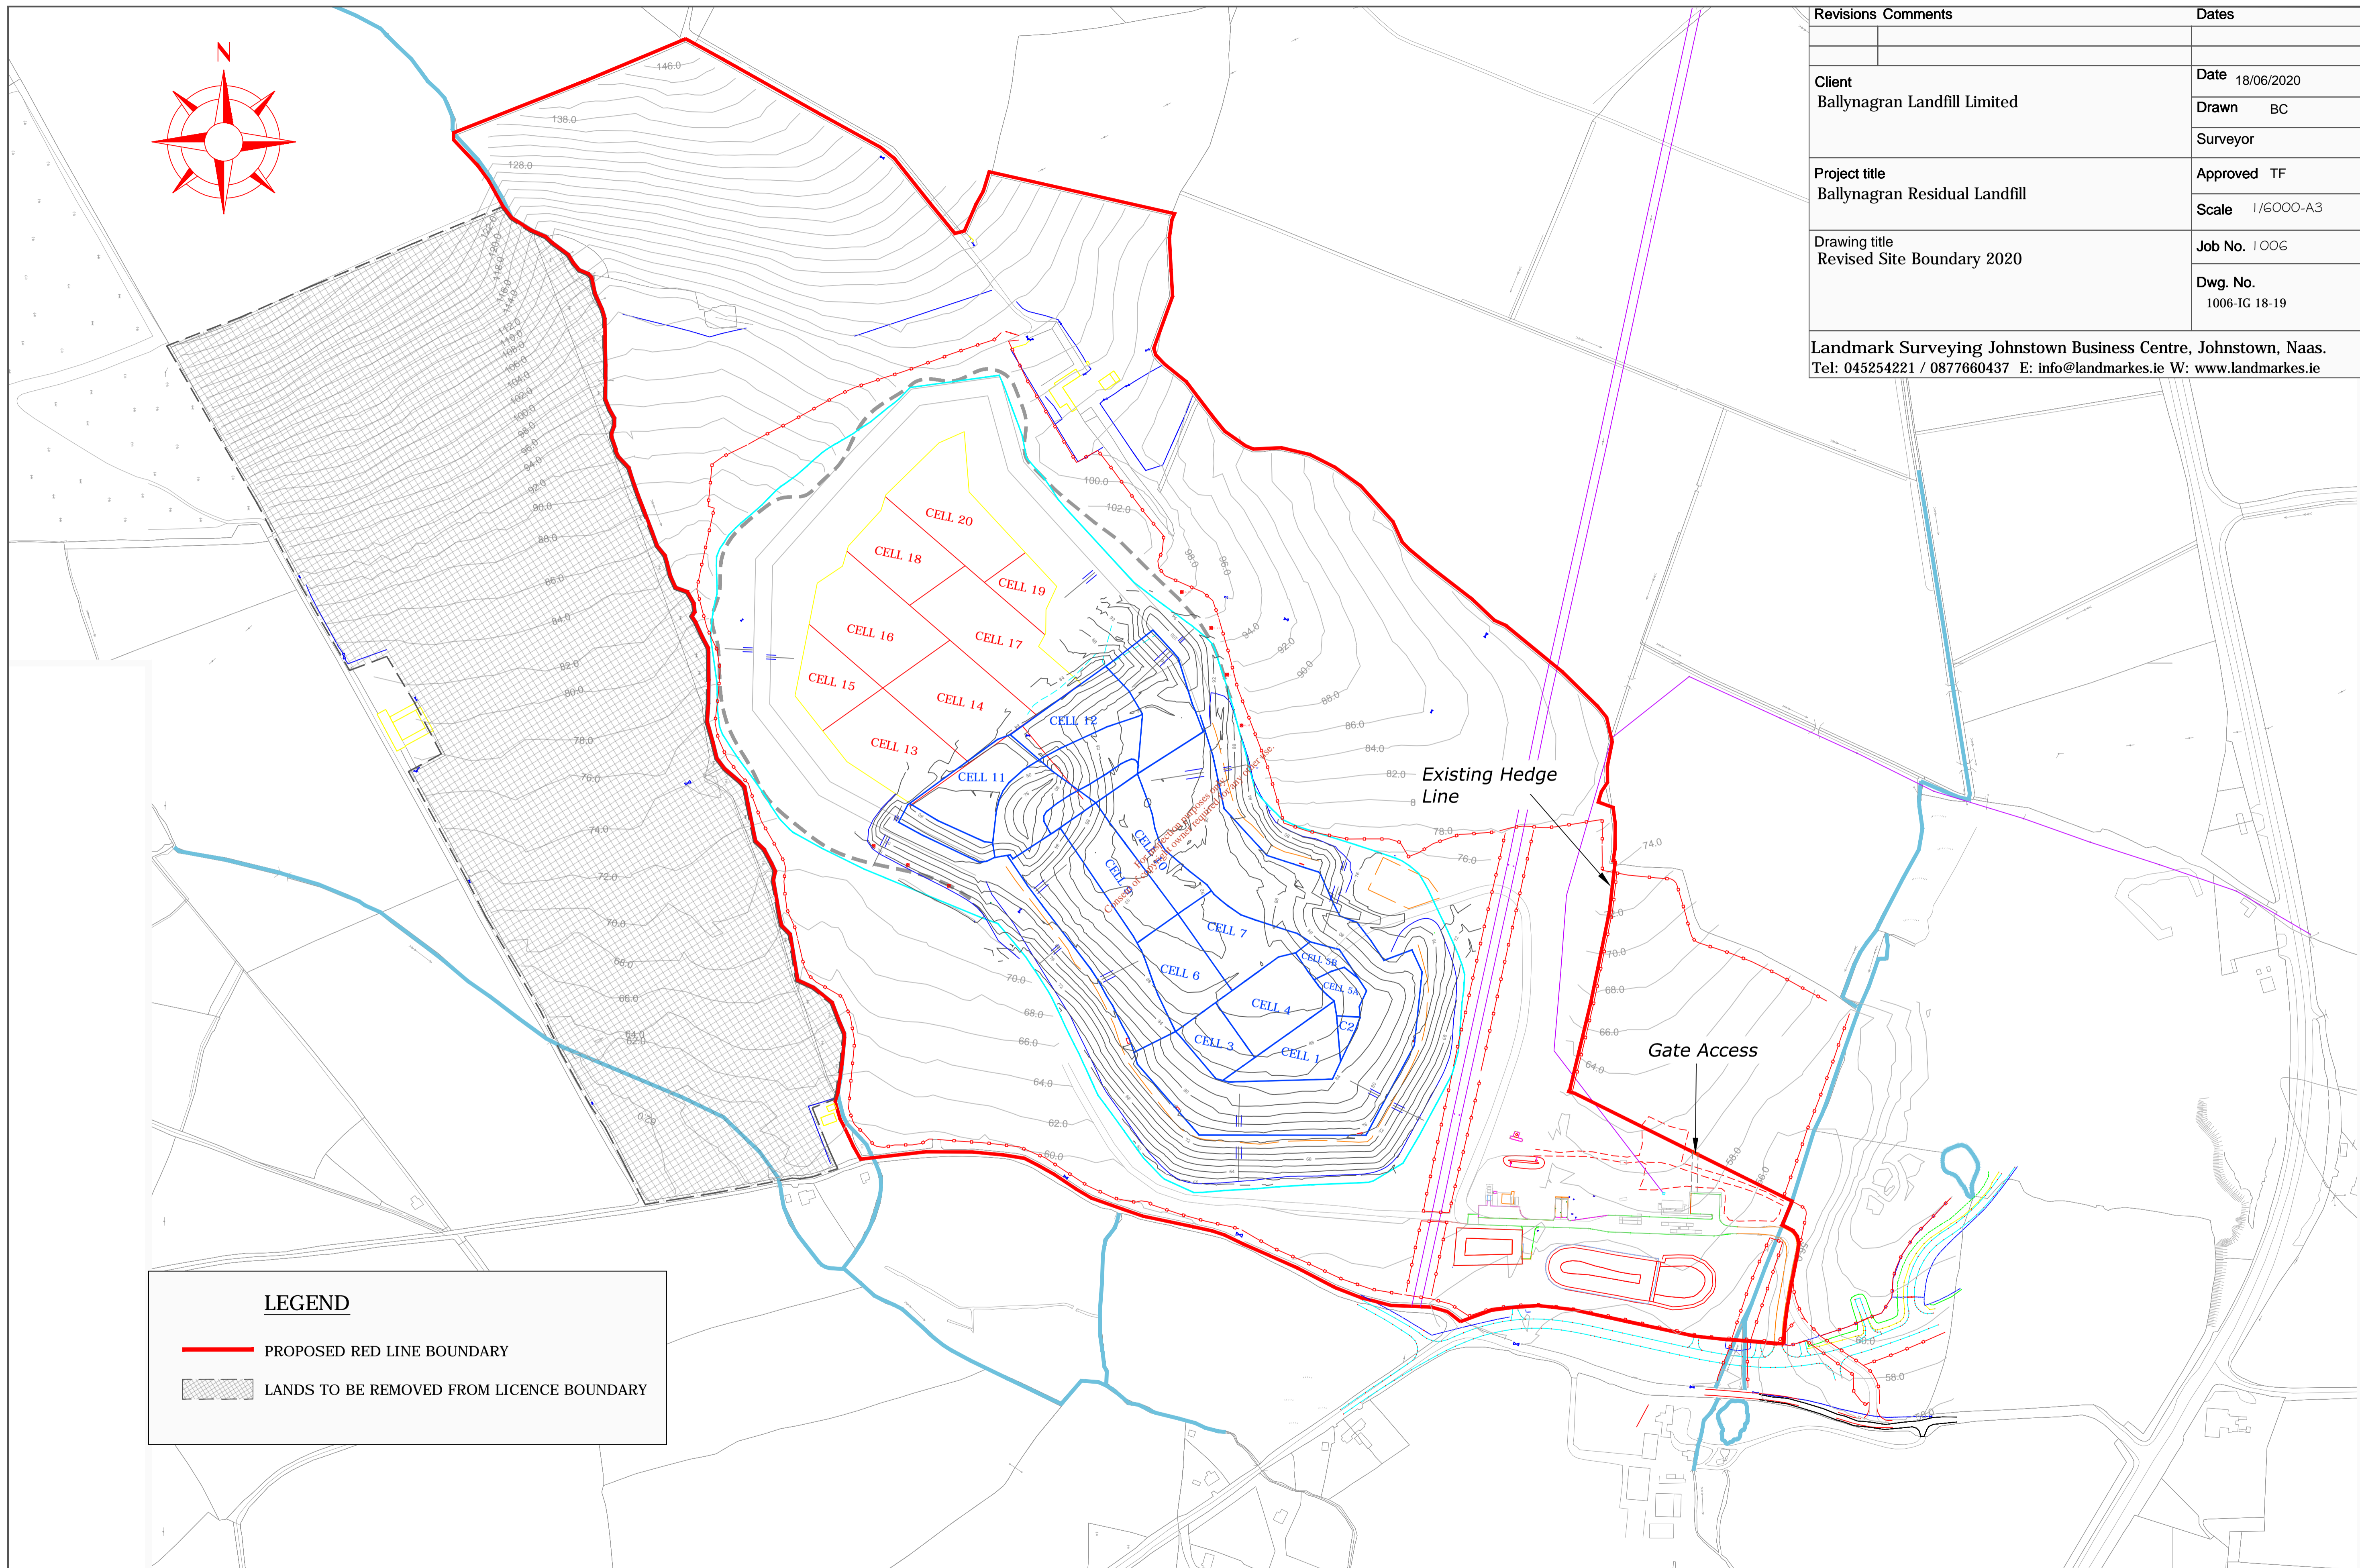

LEGEND	
	PROPOSED RED LINE BOUNDARY
	LANDS TO BE REMOVED FROM LICENCE BOUNDARY