

**Article 12 (Part 3)**  
**Section D.2: Operation &**  
**Section F: Treatment, Abatement & Control**

Note: All drawings referred to in this section of the response are included at the rear of this document, in the order in which they are referred to. However, drawings or attachments that may have been already referenced in Part 2 of the response, are included in Part 2 and not duplicated in this section

**(a) For the Wastewater Treatment process, provide the following details:**

**(i) For each process step provide details of capacity and design criteria**

The process steps for the wastewater treatment process are as follows (again, it should be noted that it is only the sludge treatment works (post Picket Fence Thickener) that is the licenceable activity and all other information given is for the purpose of providing a comprehensive overview of the overall WWTP operations):

**Primary Treatment**

- Flow (sewage) arrives to Works inlet building
- Sewage is screened automatic and manually raked screens prior to passing to grit traps
- Sewage passes to a distribution chamber where the flow is split between the two primary settlement tanks (PST)
- During storm conditions excess flow passes to the two storm tanks

**Secondary Treatment**

- Settled sewage flows to a selector tank and the Inclined Bubble Aeration (IBA) process
- Final settlement tanks separate the activated sludge flocs from the mixed liquor to produce settled effluent
- Settled effluent passes to the final effluent (FE) Sampling and Washwater Pumping Station prior to passing to outfall.
- Activated Sludge (RAS) is removed from the base of the Final Settlement Tanks (FST) and returned to the Selector Tank for mixing with the settled primary sewage
- This is introduced into the aeration tanks

**Sludge Treatment**

- The total sludge treated at the site consists of indigenous primary sludge from the Primary Settlement Tanks (PSTs) and surplus activated sludge from the Gravity Belt Thickener
- Primary sludge is thickened in a picket fence thickener and transferred to the sludge blending tank
- Activated sludge is thickened in the sludge building by a gravity belt thickener and transferred to the sludge blending tank
- Blended total sludge is pumped to the pasteurisation system
- Sludge is fed to the anaerobic digesters via the heat exchanger
- Sludge is transferred to sludge holding tanks
- Biogas generated within the digester is stored in a gas and is utilised to provide fuel to the boilers to heat the raw sludge

- The digested sludge flows by gravity to a digested sludge tank and pumped to sludge dewatering belt press streams
- Dewatered sludge cake is loaded into trailers/containers prior to being removed from site

Flow diagrams of the overall WWTP processes are shown in Drawings C1197-1001 and C1197-1005 and flow diagrams of the sludge treatment processes are shown in Drawings C1197-1002 and C1197-1006, as included with this response.

The capacity and design criteria are shown in the following Attachments for the sludge treatment part of the WWTP and for the non-licenceable section of the WWTP, for completeness:

|                          |   |
|--------------------------|---|
| Attachment C1197-8402    | Screening and grit traps  |
| Attachment C1197-8403    | Primary Settlement Tank Design  |
| Attachment C1197-8404    | Activated Sludge Design (detailing the influent to the primary works and selector tank and IBA process) |
| Attachment C1197-8407    | Settled Activated Sludge Production   |
| Attachment C1197-8408    | Picket Fence Thickener Design   |
| Attachment C1197-8409    | Gravity Belt Thickener Design   |
| Attachment C1197-8420    | Pasteuriser Design  |
| Attachment C1197-8416    | Heat Exchanger Design   |
| Attachment C1197-8412/15 | Anaerobic Digester Design (Sizing & Heat Loss)  |
| Attachment C1197-8413/18 | Biogas Equipment and Production   |
| Attachment C1197-8410    | Dewatering Belt Presses   |
| Attachment C1197-8422    | Liquor Return Sump  |

(ii) **Provide details on influent monitoring, composite samplers and in-treatment monitoring required for management of the plant**

The following areas/items of plant will be monitored (both flow and sampling unless shown otherwise) during the operation of the WWTP:

**Primary Treatment**

- Inlet channel & inlet works – raw sewage, screenings, grit (see Drawing C1197-2000)
- Inlet channel & post grit channel – screened sewage (see Drawing C1197-2000)

**Secondary Treatment**

- PST to Aeration chamber – settled sewage (see Drawing C1197-2006)
- Pre final effluent chamber & final effluent chamber – secondary effluent (see Drawing C1197-2020)
- Final effluent chamber – final effluent (see Drawing C1197-2000)
- At Selector tank – RAS to aeration selector tank (see Drawing C1197-3006)

**Storm Flows**

- After storm tanks – storm overflow to FE Chamber (see Drawing C1197-2002)

- At PST chamber – storm return (flow only) (see Drawing C1197-2004)

### **Sludge Treatment**

- Settled sludge (PST to PFT) After primary pumps and at picket fence thickener (see Drawing C1197-3006)
- Emergency primary sludge holding tank – thickened primary sludge (see Drawing C1197-2008)
- Emergency secondary sludge holding tank – thickened secondary sludge (see Drawing C1197-2009)
- After dewaterer feed pump – stored digested sludge (see Drawing C1197-3006)
- Pasteuriser slab – pasteurised sludge and return from cooler (see Drawing C1197-3006)
- After PFT – Thickened primary sludge to sludge blending tank (see Drawing C1197-3006)
- Gravity Belt Thickener (GBT) – sludge blending tank (see Drawing C1197-3006)
- Pasteuriser Slab- blended sludge to pasteuriser (see Drawing C1197-2004)
- Digester to Digested sludge tank (see Drawing C1197-3006)
- Digested sludge tank to dewaterer (see Drawing C1197-2004)
- Sludge Cake Skip – final sludge product (see Drawing C1197-2011)
- Aeration tanks – mixed liquor (see Drawing C1197-1016)
- Sludge building – SAS to gravity belt thickeners, digested sludge to dewaterer, polymer use (see Drawing C1197-3006)

### **Other Flows**

- Sludge building – liquor from gravity belt thickener (GBT) to Return Liquor chamber (see Drawing C1197-3006)
- Return liquor - at PST splitter (see Drawing C1197-2004)
- At liquor chamber – Return liquors (only sampling) (see Drawing C1197-1030)
- Inlet Works Building Odour Control Unit – inlet air and outlet air (see Drawing C1197-3006)
- Sludge Building Odour Control Unit – inlet air and outlet air (see Drawing C1197-3006)

### **Utilities**

- Polymer dosing- sludge conditioning for dewatering- Sludge Building (see Drawing C1197-2011)
- Potable Water/Washwater (see Drawing C1197-2024)

Table 07\_4084 3.a(ii) shows the monitoring and/or sampling that will be carried out during operation. The location of the monitoring is identified, with the measurement type, i.e. volumetric or flow rate, manual or auto-sampling for chemical or biological analysis. Also identified, where applicable, is the type of sampler to be used, size and equipment/sampler make or brand. The sampling interval for each one is given, ranging from continuous i.e. for volumetric measurements, flow rates at different parts of the plant, to daily or weekly, i.e. for chemical or biological analysis, to intermittently or spot checks.

In addition, the drawing reference for each drawing of where the sampling or monitoring point is located is provided in this table and the drawings showing these sampling/monitoring areas are included with this response.

**(iii) Provide further details of sludge returns (SAS and RAS) including volume, removal rates, characteristics and controls**

The sludge that will pass through the plant is as follows:

Sludge production is a percentage of the influent volume. The Plant is designed to cater for the maximum projected volume of influent in 25 years time.

Primary Sludge (as produced in the PST's) - The projected maximum volume of primary (settled) sludge production is 6499 kg DS (Dry Solids)/day at a DS concentration of 3%, a density of 1009 kg/m<sup>3</sup> and a volume flow rate of 214.79 m<sup>3</sup>/d. All based on the maximum projected inflow to the works in 25 years time.

Surplus Activated Sludge (SAS) - Sludge (activated sludge) produced in the final settlement tanks (part of the secondary treatment) is returned to the aeration tank inlet as it contains the bacteria for the aeration process. The rate of return of activated sludge (RAS) to the aeration tanks is determined by the dissolved oxygen demand of the settled sewage. Any activated sludge not required is therefore surplus (SAS) and is piped to the sludge treatment area where it is blended with the primary sludge and is therefore treated as part of the sludge treatment process.

The projected maximum volume of SAS production is 7748 kg DS/day at a DS concentration of 0.6%, a density of 1002 kg/m<sup>3</sup> and a volume flow rate of 1269 m<sup>3</sup>/d.

Some details on RAS and SAS return can be seen in Attachment C1197-8404. However, these volumes and rates will not be available until the plant is commissioned as they are based on the quality of the sludges as settled in the Final Settlement Tanks (FST). These can be provided to the EPA as soon as they are available.

**(iv) Provide further details of return liquors, including sources, volume, characteristics (including BOD load), return rates and controls. Provide details of the maximum volume and load to be returned to the WWTP**

Return liquors arise from several discharge points within the works. Details of these return liquors are shown on Drawing C1197-1030, which is the P&ID for the liquor returns.

The liquor returns amount to an average of 185 m<sup>3</sup>/hr for pump design purpose. This flow rate comprises the following:

- Odour control units 1 & 2 - indeterminate
- FST scum - 0.14m<sup>3</sup>/hr
- Picket fence thickener - 29 m<sup>3</sup>/hr
- Sludge tank overflows – as and when

- Gravity Belt Thickener - 111 m<sup>3</sup>/hr max
- Digester holding tanks - as & when
- Gas condenser - 0.10 m<sup>3</sup>/hr
- Polymer makeup overflow - 3.6m<sup>3</sup>/hr
- Sludge dewatering - 58 m<sup>3</sup>/hr

All these discharges are piped to (collected in) the Return Liquors pumping chamber tank (item 33 on Drawing No. C1197-3014). A duty pump (with standby) operates on float control to pump the contents to the splitter chamber at the inlet to the primary settlement tanks where they are mixed with the raw screened sewage for combined treatment in the PST's .

The return liquors that are returned to the start of the wastewater treatment process, i.e. into the inlet works, are detailed in Attachment C1197-8404.

The return liquors load is as follows:

| Return Liquors    |          |          |       |          |
|-------------------|----------|----------|-------|----------|
| Load              | BOD kg/d | S.S kg/d | NH3   | Flow l/s |
| Average Load 2005 | 993      | 1153     | 135   | 21.3     |
| Average Load 2025 | 1035     | 1127     | 135.0 | 28.0     |

**(b) For the sludge treatment process, provide:**

**(i) Technical design specifications and operational details for each stage**

The design specifications for the overall WWTP, including the sludge treatment, are detailed in Section 3.a(i). Please refer to this section for further information

**(ii) Describe in more detail the AD process, operating conditions, throughput, retention time, heating mixing and cooling systems, quantities and characteristics of input and outputs, handling of digested sludge, and outputs other than digested sludge and biogas**

The digestion process is working under mesophyllic conditions. Controls for the AD process are those relating to controlling the time and temperature; that is controls on the heating system and on the maximum flow rate through the system.

The Plant has been designed for a controlling temperature of 35 deg C in the digesters, and flow rate will be regulated accordingly and on production of sludges. Sludge arriving at the Digester (under pumping pressure against the head of the digester) is already heated (at 55 deg C) as a result of the pasteurization process and will enter the tank at 37 deg C. The pipework system is designed to enable heat to be lost before sludge enters the Digester. If there is insufficient heat loss (i.e. high ambient temperature) then a cooler heat exchanger is incorporated into the flow line which is fed by wash water, and if it is necessary the sludge can be diverted through this to provide cooling.

The flow into and out of the Digester is continuous but the `spot` retention time is 14 days.

The digester holding tank (of reinforced concrete) is designed to retain this temperature (35 deg C) over a specified temperature gradient of 1 deg C loss over one day when no heat is applied. Drawing No C1197-2019 shows the general arrangement of the Anaerobic Digesters and Drawing C1197-1021 shows the P&ID.

There are no other outputs from the digestion tanks other than digested sludge and biogas.

**(iii) Provide further details on Biogas collection, storage and method of transfer. Provide details of any scrubbing, or moisture removal and details of the flare including location, design, temperature and residence time**

As described in Part 2 Section D.1.i, biogas is produced as a product of digestion of the sludge in the digester tanks. This is utilised to provide the prime fuel source for the boilers, providing hot water for the pasteuriser system. Excess gas (or unused gas) is diverted to the waste gas flare for burning. Should there be insufficient gas available then the boiler system is designed to operate with gas oil. There is no provision for scrubbing.

The biogas collection system is located in the sludge treatment area, as shown in Drawing No. C1197-3006 (see attached). The pipework is shown, and the direction of flow of the biogas, from the 2 no. digesters to the biogas condensate holder, shown in Drawing No. C1197-2023 and Drawing No. C1197-1024.

Biogas from the Sludge Digesters flows to the flexible membrane gasholder. Water from the gas condenses in the gas pipework and gravitates forward to the condensate trap/chamber.

Gas is prevented from escaping from the condensate trap by means of a water trap, condensate discharges into a small pumping chamber for subsequent return to the liquors treatment plant. A system of valves in the condensate trap allows isolation of the gasholder if necessary. Low-pressure fans pressurising the space between the outer membrane of the gasholder and the internal membrane bag maintain gas pressure. Vacuum and pressure relief valves on the gasholder allow discharge under abnormal circumstances. The set pressures of the relief valves will be lower on top of the digesters than at the gas holder so that if there is a high gas pressure the relief will be at high level to make the best use of dispersion for safety and odour reasons.

The gas holder (Drawing No. C1197-1024) is a flexible membrane gas holder of 100m<sup>3</sup> capacity, which buffers the flow of biogas from the digesters and provides a reservoir of gas for semi-continuous operation of the boilers. The gas holder is constructed from two reinforced fabric membranes. The inner membrane is a hemispheric – cylindrical gas- holder, which is attached at its equator to the external, truncated spherical membrane, which is inflated by air pressure thus providing support to the inner membrane. The exterior membrane is inflated by two blowers, which maintain a constant air pressure in the outer membrane. The gas pressure is maintained by the exterior air pressure acting on the inner membrane.

The system operates at a working pressure of 200 mm wg. As the gas is utilised the inner membrane of the holder deflates under the constant pressure from the low-pressure fans. As the inner bag deflates an ultrasonic detector mounted in the top of the gasholder monitors the degree of deflation and computes a gas volume. Various set points will trigger various operations. As the inner membrane expands and fills with gas, the enclosed air volume between the inner and the outer membrane reduces, and to protect against this causing any excess air pressure, the air is automatically released through an air release valve mounted on the outer membrane. When gas consumption exceeds gas production the air blower provides air to replace the reducing gas volume whilst maintaining constant gas pressure.

Two air blowers configured as duty standby provide inflation air for the membrane Gasholder. These run continually in automatic and are rated for the maximum gas utilisation rate by the waste gas burner.

From the gas holder, the biogas is directed to the boilers, which are shown on Drawing No. C1197-3006. Gas is drawn from the gasholder via the condensate trap to the Boiler room for usage by the boilers (as the prime fuel source). The details of the gas use and flow rate for the boilers are shown in the P&ID for the boilers, included as Attachment C1197-8417.

A waste gas burner, located away from the gas holder, burns any excess Biogas, though as the hot water demand is high within the plant, use of this equipment will be limited and should be viewed as a standby route for the gas. This is shown in Drawing No. C1197-1024 and the P&ID sheet is included as Attachment C1197-8418, which gives further details on the capacity, retention time etc.

This low level waste gas burner operates under control of the SCADA (the operation control system). If the biogas level in the gasholder exceeds a set point the burner starts and biogas is drawn from the gasholder through a series of actuated valves and flame arrestors. In order that sufficient temperature is reached within the burner fresh air is added to the biogas at the burners to increase the oxygen/biogas mixture.

- (c) **For the odour handling units, provide further details including a list of air streams extracted, characteristics of extracted air, controls for emissions of methane. Describe any other odour abatement measures. Describe any proposed controls for pathogens.**

#### Odour Abatement

The P&ID diagram for the odour control is included as Drawing No. C1197-1026 and the data associated with the design are included as Attachment C1197-8419. This shows the 2 no. odour units, and the streams extracted and the characteristics of the extracted air. As detailed in Part 2.h of this response, these include:

- Inlet Works
- Grit Classifier
- Screenings Wash
- Inlet Works Building
- Screen/Grit Skips
- Primary Settlement Tank

- Picket Fence Thickener
- Gravity Belt Thickeners
- Sludge Blending Tanks
- Emergency Sludge Holding Tanks (Primary and Secondary)
- Sludge Building
- Sludge Dewaterers and Dewaterers Skip
- Liquor Returns

The characteristic of the air streams extracted include - average and maximum odour concentrations for each source, the average and peak H<sub>2</sub>S (hydrogen sulphide) concentrations, and the flow rate for the air from each source.

Further detail has been included on the odour abatement measures, which entail covering of potentially odorous tanks etc and the odour control units (OCU-1 and OCU-2) in Part 2.h.

#### Methane Emissions

The methane produced in the anaerobic digestion process will not be emitted to the atmosphere and therefore there will be no methane emissions from this part of the plant. The abatement control for this is the utilisation of the methane as a biogas fuel for the boilers. The boilers will use the biogas as described in Part 2(i) of this response. Any excess biogas will be burned off, again described in detail in Part 2(i).

#### Control for Destruction of Pathogens

The primary proposed control for pathogens that may be generated during the wastewater treatment process is the pasteurisation process. Detailed description of the pasteurisation process is included as Attachment 07\_4084 3.c. Drawing C1197-1020 shows the P&ID for the process.

The thermal sludge pasteuriser is utilised to thermally pasteurise sewage sludge prior to sludge digestion in order to eliminate pathogens harmful to man from the sewage sludge and render it suitable for hygienic disposal as a Class `A` sludge.

The thermal pasteuriser operates on the basis of utilising heat to eradicate the pathogenic bacteria.

In the thermal pasteuriser, the sludge is held at a temperature of 55 deg C for a period of four hours after which, it can then be cooled to digester temperature and utilised as the sole source of digester heating.

The anaerobic digestion process also provides a control for pathogen destruction due to the retention time and temperature that the process is kept at. This is described in more detail in Part 3.c.

- (d) Provide further details of process abatement and control for each stage of the wastewater treatment process, sludge treatment and odour control units. Submit Table F.1 for each stage**
- (i) Include details of the capacity, throughput and treatment efficiency, and waste products for each stage**

### Wastewater Treatment

The anticipated input to the wastewater treatment plant, in terms of the average and peak flows for both the current flows, and the predicted flows for the year 2025 (which is the maximum input for which the plant is designed) is shown in Attachment C1197-8404.

The expected average daily input for current situation (2005) is 277 l/s (average) and 611.3 l/s (max), and for the peak year (2025), the average flow is 441.3 l/s and the maximum is 981.7 l/s.

The loads for each year are shown in the Attachment C1197-8404. From the primary tanks, the removal efficiency rates for each parameter measured are as follows:

|                                      |   |     |
|--------------------------------------|---|-----|
| Suspended Solids (SS) (max.)         | - | 60% |
| Suspended Solids (SS) (min.)         | - | 55% |
| Biological Oxygen Demand (BOD) (max) | - | 30% |
| Biological Oxygen Demand (BOD) (max) | - | 25% |

The percentage dry solids details are also included in Attachment C1197-8404. The loads to the secondary treatment are also shown in the attachment.

As discussed in the original application, until the plant is commissioned, the exact quality of the final treated effluent cannot be determined, as the exact nature of the raw sewage can only be predicted at present. At present, the sewage is discharging through a large number of outfalls into the River Suir, Suir Estuary and St. John's River, and therefore a composite quality and nature has been predicted for the design stage of the plant.

The commissioning phase will ensure that optimum efficiency rates of removal are achieved by adjusting and setting the controls/plant to achieve the required performance. More information can be provided as the commissioning phase is completed.

However, there are maximum limits that the WWTP are designed to meet in terms of the quality of the final treated effluent, which will be discharged to the Suir Estuary. These limits are as follows:

| Parameter        | Unit | Standard |          | Compliance Criteria  |   |
|------------------|------|----------|----------|--|---|
|                  |      | Target A | Target B | Target A   | Target B  |
| BOD              | mg/l | 25       | 50       | No more than 3 daily samples per 60 days with a value for any one parameter or all parameters to be greater than the standards | No samples with a value for any one parameter to be greater than the standard |
| COD              | mg/l | 125      | 250      |  |   |
| Suspended Solids | mg/l | 35       | 87.5     |  |   |

### Sludge Treatment

The sludge volumes that will be produced are identified in Section 3.a(iii) and Attachment C1197-8404.

As for secondary treatment, the plant design efficiency rate is to produce 23% dry solids sludge cake, which is the condition that the sludge cake will be in when it leaves the site for land spreading or landfilling. The efficiency rates in practice will be available once the plant is commissioned and can be supplied to the EPA if required.

#### Odour Control Units

Details of the odour control units are shown in Part 2(h) of this response. As described in the odour dispersion model, for OCU 1, which treats the inlet building, the hydrogen sulphide removal rate i.e. efficiency is 99% and this equates to an odour removal rate of 97%.

For OCU 2, which treats the sludge building, the hydrogen sulphide removal rate i.e. efficiency is 99% and this equates to an odour removal rate of 95% in this case. Attachment C1197-8419 (Odour Control Design), included with Part 2.h.

#### **(ii) Include details of in-tank monitoring and control systems**

Section 3.a(ii) details the monitoring for the operation of the WWTP, and Table 07\_4083 shows all the parameters for each monitoring/sampling point.

In terms of the control systems, there will be in-tank monitoring in the digester tanks for level and temperature. The main control is that of temperature, which is described in Part 3.b(ii). All other monitoring is described in Table 07\_4084 3.a(ii) and shown in the drawings identified in Part 3.a(ii).

#### **(iii) Control parameters for the Anaerobic Digesters**

Controls for the AD process are those relating to controlling the time and temperature; that is controls on the heating system and on the maximum flow rate through the system.

The Plant has been designed for a controlling temperature of 35 deg C in the digesters, and flow rate will be regulated accordingly and on production of sludges. Sludge arriving at the Digester (under pumping pressure against the head of the digester) is already heated (at 55 deg C) as a result of the pasteurization process and will enter the tank at 37 deg C. The pipework system is designed to enable heat to be lost before sludge enters the Digester. If there is insufficient heat loss (i.e. high ambient temperature) then a cooler heat exchanger is incorporated into the flow line which is fed by wash water, and if it is necessary the sludge can be diverted through this to provide cooling.

The flow into and out of the Digester is continuous but the `spot` retention time is 14 days.

The digester holding tank (of reinforced concrete) is designed to retain this temperature (35 deg C) over a specified temperature gradient of 1 deg C loss over one day when no heat is applied. The in-tank monitoring of temperature and level will monitor these parameters, whilst flow rates into and out of the tanks are measured on the pipework, see Part 3.a(ii).

#### **(iv) For each item of control equipment provide details of maintenance and calibration**

Details of maintenance and calibration will be determined prior to operation of the WWTP. As the WWTP is still under construction, many items of plant have not yet been installed, and therefore suppliers and manufacturers guidelines on maintenance and calibration are not available in some cases.

Once the WWTP is complete, and prior to operation, a full maintenance and calibration schedule will be available and submitted to the EPA, as per their requirements, and it will be part of the "standing" O&M (Operation and Maintenance) procedures for Waterford WWTP.

**(e) Compare the abatement, treatment or recovery system with BAT Standards**

The Integrated Pollution Prevention and Control (IPPC) Reference (Bref) Document on Best Available Techniques (BAT) for the Waste Treatments Industries (August 2006) <sup>1</sup> has been referred to in this section.

Specifically, the techniques to consider in biological treatment have been taken into consideration during the design phase of the WWTP.

Selection of the appropriate biological treatment was based on the need for the best treatment to carry out the processed within the WWTP that achieves the optimum operational performance and reduces environmental issues, as well as providing an opportunity to use waste gas as a fuel.

Specific Storage and Handling Techniques

There is no storage of the wastewater as it enters the treatment works, but it is directed into the inlet works. Technique (b), (e) and (f) of the Bref document <sup>1</sup>, Section 4.2.2, have been employed for the WWTP by ensuring that the inlet works and primary settlement tanks are closed. The inlet works building is fully enclosed and under negative pressure and air from here, which may contain malodours, are sucked into the pipework to Odour Control Unit 1 (OCU 1), along with those from the primary settlement tanks.

Air exchanges of between 2 and 18.7 per hour are specified for different items of plant within the inlet works (2 air changes per hour for the overall building and for the primary settlement tank and between 8 and 19.7 for the individual items within the works building, including the pre-screen and post grit channel, the fine screens, the screenings compactors, the grit classifier and the grit channel).

The sludge works are also completely enclosed, in accordance with Technique (b) and (f), keeping all process within the structure. The building is under negative pressure and any malodourous air is sucked into OCU 2 from the building, which includes air from a number of items within the sludge works: the pasteurizer, picket fence thickener, the sludge tanks, the sludge dewaterer and the liquor returns. The air changes per hour for each item range from 2 – 6.

It should be noted that employees will not be routinely working in these areas, only for maintenance and monitoring purposes and therefore the air changes will be sufficient for these infrequent visits.

As all the waste entering the plant is via pipes, there will be no vehicle access to the inlet works delivering waste. In accordance with Technique (e) there is a roller shutter door for the inlet works building, which is electrically controlled to ensure the door opening is kept to a minimum and shut completely. Maintenance will be regular, and details will be included in the Operations Manual, which will be finalized prior to commencement of plant operation.

For the sludge works, there is no vehicle access, with only doors for employee access, which will be kept closed at all times. No air curtains are considered necessary as the risk of odour escaping is minimal (due to the building being under negative pressure, and also will not be significant as a result of the odour control programme).

Technique (d) has also been employed for the last steps of the biological treatment, concerning the storage of solid wastes produced, i.e. dewatered sludge cake, grit and screenings. The skips/containers will be enclosed and the dewatered sludge cake taken off-site every day, as waste storage on site will not be permitted. The grit and screenings will be taken off-site once the skips are almost full and replaced with empty ones.

#### Increase the Retention Time in the Anaerobic Digestion process

The required anaerobic digester operating temperature is 35 deg C with a 'spot' retention time of 14 days. These are the design criteria to ensure optimum digestion conditions, which allow the digestate to spend more time under degradation conditions, at the temperature that ensures maximum degradation. The temperature of the sludge fed forward to the digesters is controlled by the amount of cooling water used in the "cooler" heat exchanger. As a result of this process, maximum biogas is produced to fuel the boilers, providing a beneficial use from what was essentially a waste product.

In relation to the pasteurisation process, which is intrinsically linked with the Anaerobic Digestion process, there is increased retention time for this process. This is described in detail in Attachment 07\_4084 3.c.

The relationship with the anaerobic digestion is that, having heated the sludge to a temperature up to 55 deg C (pasteurisation retention temperature), it can then be cooled to digester temperature and utilised as the sole source of digester heating. Hence, a control loop is established such that the digester is fed with pasteurised sludge either higher or lower than the required digester operating temperature of 35 deg C. Hence, in the summer months the temperature of the sludge going forward for digestion may be a little cooler than in the winter.

#### Techniques for the Reduction of Emissions when Biogas is used as Fuel

The biogas produced that is used as a fuel for the boilers, is methane, produced by the anaerobic digesters. The gas holder that will be part of the biogas system, will buffer out any peaks in production and therefore provide a steady supply of biogas to the boilers as and when it is required. This will ensure that the biogas is not wasted (by burning off excess during peak production times) and also reduces the need to use alternative fuel (diesel) for the boilers during times of low production.

Techniques a – d of the Bref document, Section 4.2.6 are not considered necessary for the WWTP, primarily because the gas produced is methane (CH<sub>4</sub>) and not hydrogen sulphide (H<sub>2</sub>S), which would require further abatement techniques.

In terms of the hydrogen sulphide removal, there are activated carbon filters on each of the Odour Control Units (OCUs). The first step in the process, which is a biological media, strips the majority of the H<sub>2</sub>S out of the gas, with the carbon filters acting as a polishing step, taking out the remainder of the H<sub>2</sub>S (See Drawing C1197-1026) which is included with this response.

As the biogas is being used as a fuel, and the process is not a considerable source of fuel (only powering the boilers), it is not considered economically viable or environmentally justified for this plant.

Technique (e) has been employed by providing biogas storage and an emergency flare. Biogas is produced as a product of digestion of the sludge in the digester tanks. This is utilised to provide the prime fuel source for the boilers, providing hot water for the pasteuriser system. Excess gas (or unused gas) is diverted to the waste gas flare for burning. More details on the process are given in Section b(iii) of this section of the response (see above).

**(f) Provide design details for the discharge outfall, and details of diffusers etc**

Drawing No. 3126 shows the location and pathway of the final effluent discharge pipe and discharge point, which is marked on the drawing as a green line. The discharge point terminates in the centre of the Suir Estuary.

In summary, there will be three sections of the discharge pipeline, namely A. the land based section (227 metres); B. the section running parallel to the railway line above high water mark (399 metres); and C. the marine section (237 metres). Section C will have the diffusers, the pipe of which will be buried, and 20 diffuser ports, which will be exposed into the Estuary channel. Protection of these ports will be put in place.

See Attachment 07\_4084 D.2(f) for more detail on the design details for the final effluent discharge outfall, including information on the diffusers.

**(g) Provide details of final effluent wash water, including uses and volumes**

Wash water is provided at the start of the operations at the WWTP from an adjacent source, which has been agreed. This will be the IDA borehole, located within the adjacent IDA Park, from which a spur will be directed to the WWTP facility. This source is considered to be only temporary, pending provision of a permanent supply from the public mains (which is not in place at present).

The quality can be deemed to be of potable standard but is not being used as a potable source and no special provision is made to keep it sterilized when on the site. Potable water will be brought on site from another source, in bottled form.

The quantities of wash water that are anticipated (volumes cannot be confirmed until the plant has been commissioned) are as follows:

---

|                                      |                  |   |                      |
|--------------------------------------|------------------|---|----------------------|
| For polymer make-up – SAS thickeners | 9,821 l/d        | - | into sludge          |
| For polymer make-up – Dewaterers     | 21,478 l/d       | - | into sludge          |
| Boiler top up – as and when required |                  |   |                      |
| Odour control unit – inlet           | 2,600 l/d        | - | keeping OCU moist    |
| Odour control unit – sludge          | 1,500 l/d        | - | keeping OCU moist    |
| Internal hose point                  | 3,600 l/d        | - | into drainage system |
| <b>Total</b>                         | <b>39,000l/d</b> |   |                      |

The system is designed to use 40000 l/day.

Drawing No. C1197-1027 shows the wash water flow diagram for the WWTP.

*For inspection purposes only.  
Consent of copyright owner required for any other use.*

## References

1. Integrated Pollution Prevention and Control (IPPC) Reference (Bref) Document on Best Available Techniques (BAT) for the Waste Treatments Industries, EPA, 2006

*For inspection purposes only.  
Consent of copyright owner required for any other use.*

**Table 07\_4084 F.1 Rev.2**

*For inspection purposes only.  
Consent of copyright owner required for any other use.*

**TABLE F.1: ABATEMENT / TREATMENT CONTROL**

**Wastewater Treatment Stage – Inlet Works**

**Emission point reference number :** OCU-1 (Grid Ref: E 264547 N 112429)

| Control <sup>1</sup> parameter | Equipment <sup>2</sup> | Equipment maintenance                | Equipment calibration      | Equipment back-up |
|--------------------------------|------------------------|--------------------------------------|----------------------------|-------------------|
| Hydrogen Sulphide              | Odour Control Unit 1   | According to equipment specification | As recommended by supplier | None              |

| Control <sup>1</sup> parameter | Monitoring to be carried out <sup>3</sup>   | Monitoring equipment   | Monitoring equipment calibration   |
|--------------------------------|---|--|--|
| Hydrogen Sulphide              | Bi-annual Odour Survey at Determined Monitoring Points (closest receptors and boundary) | Hand held Jerome 631-X H <sub>2</sub> S analyzer for odour surveys | In the field - Sensor calibration with Jerome H <sub>2</sub> S functional test kit<br><br>Also regular calibration by manufacturer approved facility |

<sup>1</sup> List the operating parameters of the treatment / abatement system which control its function.

<sup>2</sup> List the equipment necessary for the proper function of the abatement / treatment system.

<sup>3</sup> List the monitoring of the control parameter to be carried out.

**TABLE F.1: ABATEMENT / TREATMENT CONTROL****Sludge Treatment Stage – Sludge Building****Emission point reference number :** OCU-2 (Grid Ref: E 264624 N 112338)

| Control <sup>1</sup> parameter | Equipment <sup>2</sup> | Equipment maintenance                | Equipment calibration      | Equipment back-up |
|--------------------------------|------------------------|--------------------------------------|----------------------------|-------------------|
| Hydrogen Sulphide              | Odour Control Unit 2   | According to equipment specification | As recommended by supplier | None              |

| Control <sup>1</sup> parameter | Monitoring to be carried out <sup>3</sup>   | Monitoring equipment                             | Monitoring equipment calibration   |
|--------------------------------|---|--|--|
| Hydrogen Sulphide              | Bi-annual Odour Survey at Determined Monitoring Points (closest receptors and boundary) | Hand held Jerome 631-X H <sub>2</sub> S analyser | In the field - Sensor calibration with Jerome H <sub>2</sub> S functional test kit<br>Also regular calibration by manufacturer approved facility |

<sup>1</sup> List the operating parameters of the treatment / abatement system which control its function.

<sup>2</sup> List the equipment necessary for the proper function of the abatement / treatment system.

<sup>3</sup> List the monitoring of the control parameter to be carried out.

**TABLE F.1: ABATEMENT / TREATMENT CONTROL****Sludge Treatment Stage – Adjacent to Sludge Building****Emission point reference number :** A-01(a) Grid Ref: E 264576 N 112295

| Control <sup>1</sup> parameter | Equipment <sup>2</sup> | Equipment maintenance | Equipment calibration | Equipment back-up |
|--------------------------------|------------------------|-----------------------|-----------------------|-------------------|
| NOx                            | None                   | None                  | None                  | None              |
| CO                             | None                   | None                  | None                  | None              |

| Control <sup>1</sup> parameter | Monitoring to be carried out <sup>3</sup>         | Monitoring equipment  | Monitoring equipment calibration            |
|--------------------------------|---|---|---|
| NOx                            | In-situ stack monitoring at Boiler stack A-01(a)  | Testo 350 electrochemical analysis fitted with gas-drying unit (or similar) | As required by equipment manufacturer spec. |
| CO                             | In –situ stack monitoring at Boiler stack A-01(a) | Testo 350 electrochemical analysis fitted with gas-drying unit (or similar) | As required by equipment manufacturer spec. |

<sup>1</sup> List the operating parameters of the treatment / abatement system which control its function.

<sup>2</sup> List the equipment necessary for the proper function of the abatement / treatment system.

<sup>3</sup> List the monitoring of the control parameter to be carried out.

**TABLE F.1: ABATEMENT / TREATMENT CONTROL****Sludge Treatment Stage – Adjacent to Sludge Building****Emission point reference number :** A-01(b) (Grid Ref: E 264580 N 112295)

| Control <sup>1</sup> parameter | Equipment <sup>2</sup> | Equipment maintenance | Equipment calibration | Equipment back-up |
|--------------------------------|------------------------|-----------------------|-----------------------|-------------------|
| NOx                            | None                   | None                  | None                  | None              |
| CO                             | None                   | None                  | None                  | None              |

| Control <sup>1</sup> parameter | Monitoring to be carried out <sup>3</sup>         | Monitoring equipment  | Monitoring equipment calibration            |
|--------------------------------|---|---|---|
| NOx                            | In-situ stack monitoring at Boiler stack A-01(b)  | Testo 350 electrochemical analysis fitted with gas-drying unit (or similar) | As required by equipment manufacturer spec. |
| CO                             | In –situ stack monitoring at Boiler stack A-01(b) | Testo 350 electrochemical analysis fitted with gas-drying unit (or similar) | As required by equipment manufacturer spec. |

<sup>1</sup> List the operating parameters of the treatment / abatement system which control its function.

<sup>2</sup> List the equipment necessary for the proper function of the abatement / treatment system.

<sup>3</sup> List the monitoring of the control parameter to be carried out.

**TABLE F.1: ABATEMENT / TREATMENT CONTROL**

**Surface Water Runoff**

**Emission point reference number :** SW-1 (Grid Ref: 265022 112153)

| Control <sup>1</sup> parameter | Equipment <sup>2</sup>   | Equipment maintenance              | Equipment calibration | Equipment back-up |
|--------------------------------|--------------------------|------------------------------------|-----------------------|-------------------|
| BOD                            | None                     | Not Applicable                     | Not Applicable        | Not Applicable    |
| COD                            | None                     | Not Applicable                     | Not Applicable        | Not Applicable    |
| Suspended Solids               | None                     | Not Applicable                     | Not Applicable        | Not Applicable    |
| pH                             | None                     | Not Applicable                     | Not Applicable        | Not Applicable    |
| Hydrocarbons                   | Hydrocarbon Interceptors | Regular Inspection of interceptors | Not Applicable        | Not Applicable    |

| Control <sup>1</sup> parameter | Monitoring to be carried out <sup>3</sup>  | Monitoring equipment       | Monitoring equipment calibration     |
|--------------------------------|--|----------------------------|--------------------------------------|
| BOD                            | Manually taken samples will be analysed by an external accredited laboratory, approved by the Agency | Standard Laboratory        | Standard Laboratory                  |
| COD                            | As Above   | As Above                   | As Above                             |
| Suspended Solids               | As Above   | As Above                   | As Above                             |
| pH                             | On-Site pH meter   | WTW-Water Meter or similar | As per manufacturers recommendations |

<sup>1</sup> List the operating parameters of the treatment / abatement system which control its function.

<sup>2</sup> List the equipment necessary for the proper function of the abatement / treatment system.

<sup>3</sup> List the monitoring of the control parameter to be carried out.

**TABLE F.1: ABATEMENT / TREATMENT CONTROL****Final Treated Effluent Stage – Discharge Point****Emission point reference number :** SW-2 (Grid Ref: 265602 112078)

| Control <sup>1</sup> parameter | Equipment <sup>2</sup>  | Equipment maintenance                              | Equipment calibration                              | Equipment back-up   |
|--------------------------------|---|--|--|---|
| BOD                            | The WWTP, which is described in Section D.2 performs the abatement function – | As required by supplier/manufacturer specification | As required by supplier/manufacturer specification | Manually sampling at three-hourly intervals - results weighted according to flow to establish the equivalent daily total load |
| COD                            | As Above  | As Above   | As Above   | As Above  |
| Suspended Solids               | As Above  | As Above   | As Above   | As Above  |
| pH                             | As Above  | As Above   | As Above   | On-Site pH meter  |
| Flow                           | As Above  | As Above   | As Above   | Not Specified   |
| Temperature                    | As Above  | As Above   | As Above   | On-site temperature meter   |


| Control <sup>1</sup> parameter | Monitoring to be carried out <sup>3</sup>   | Monitoring equipment                                    | Monitoring equipment calibration       |
|--------------------------------|---|---|--|
| BOD                            | Composite samples will be analysed by an external accredited laboratory, approved by the Agency | Standard Laboratory                                     | Standard Laboratory                    |
| COD                            | As Above  | As Above  | As Above                               |
| Suspended Solids               | As Above  | As Above  | As Above                               |
| pH                             | Ongoing pH monitoring   | On-Site pH meter  | As per manufacturers recommendations   |
| Flow                           | On-Site flow monitoring   | Open channel flumes fitted with ultrasonic level device | As specified by equipment manufacturer |
| Temperature                    | On-Site temperature   | On-Site temperature probe                               | As specified by equipment manufacturer |

<sup>1</sup> List the operating parameters of the treatment / abatement system which control its function.

<sup>2</sup> List the equipment necessary for the proper function of the abatement / treatment system.

<sup>3</sup> List the monitoring of the control parameter to be carried out.

DO NOT SCALE - IF IN DOUBT ASK

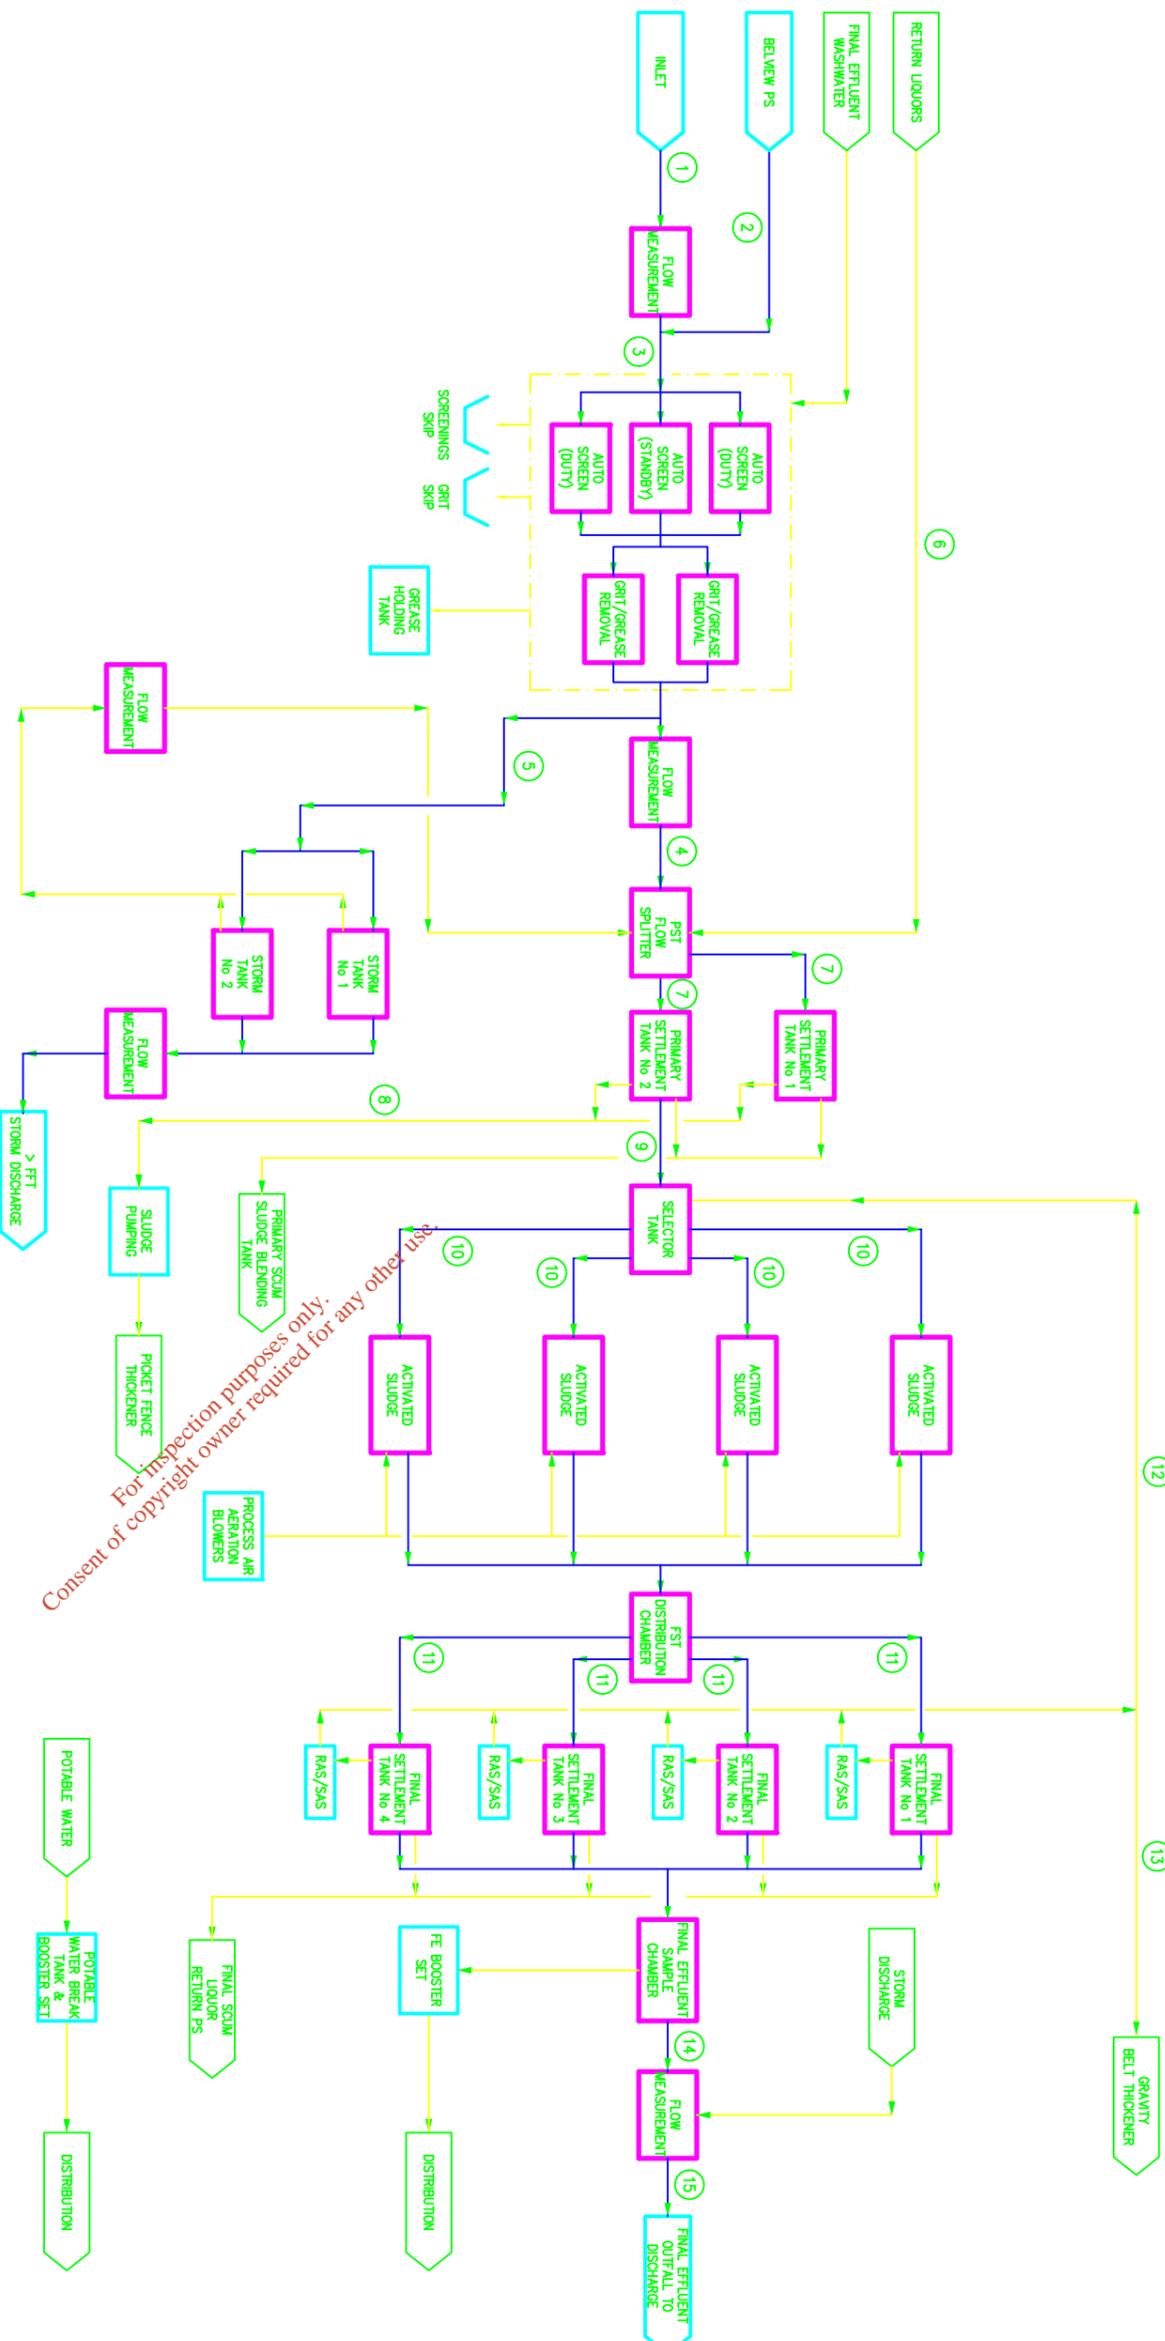

See Previous Issues For Past Revision Details

| Rev | Date       | Description             | Drawn |
|-----|------------|-------------------------|-------|
| E   | 04/05/2007 | DRAWING BORDER REVISED. | DDF   |

**NOTES**

- LOADS STATED ARE FOR YEAR 2025 ALTHOUGH PLANT DESIGNED TO ACCOMMODATE INCREASED LOADINGS OF UP TO 20% EXTRA.
- DRAWING PREVIOUSLY E8374-1001
- EXPANDED TO INCLUDE MASS AND FLOW BALANCE TABLE.

| DESCRIPTION                              | NUMBER | DUTY    | STANDBY | SIZE | CAPACITY (EACH)           | NOTES                                    |
|--|--------|---------|---------|------|---------------------------|--|
| INLET SCREENS                            | 3      | SCREENS | 2       | 2    | 2                         |  |
| GRIT REMOVAL                             | 2      | 1       | 1       | 1    | 1                         |  |
| GREASE REMOVAL                           | 2      | 1       | 1       | 1    | 1                         |  |
| PRIMARY SETTLING TANK DISTRIBUTION       | 1      | 1       | 1       | 1    | 1                         |  |
| PRIMARY SETTLING TANK                    | 2      | 2       | 2       | 0    | 32m DIA                   | CAN OPERATE WITH ONE PST OUT OF SERVICE  |
| NEW PRIMARY SLUDGE PUMPS                 | 3      | 2       | 2       | 1    | 29m <sup>2</sup> /h       |  |
| SECONDARY TREATMENT DISTRIBUTION CHAMBER | 1      | 1       | 1       | 1    | 10760m <sup>3</sup> TOTAL |  |
| ACTIVATED SLUDGE PLANT                   | 4      | 4       | 4       | 0    | 2890m <sup>3</sup>        | CAN OPERATE WITH ONE LAKE OUT OF SERVICE |
| PROCESS AIR DISTRIBUTION CHAMBER         | 5      | 4       | 4       | 1    | XXXm <sup>3</sup> /h      |  |
| EST LIQUOR CHAMBER                       | 1      | 1       | 1       | 1    | 36                        | CAN OPERATE WITH ONE PST OUT OF SERVICE  |
| NEW FINAL SETTLEMENT TANKS               | 4      | 4       | 4       | 0    | XXXm <sup>3</sup> /h      |  |
| FINAL EFFLUENT SAMPLING CHAMBER          | 1      | 1       | 1       | 1    | XXXm <sup>3</sup> /h      |  |
| FINAL EFFLUENT BOOSTER SET               | 2      | 1       | 1       | 1    | XXXm <sup>3</sup> /h      |  |
| POTABLE WATER BREAK TANK & BOOSTER SET   | 2      | 1       | 1       | 1    | XXXm <sup>3</sup> /h      |  |

| STREAM NUMBER | COMPONENT                | RAW SEWAGE | BELVIEW PS | COMBINED RAW SEWAGE | FTI RAW SEWAGE | STORM FLOW | RETURN LIQUORS | RAW SEWAGE | PRIMARY SLUDGE | SETTLED SEWAGE | MIXED LIQUOR | MIXED LIQUOR | RETURN ACTIVATED SLUDGE | SURPLUS ACTIVATED SLUDGE | FINAL EFFLUENT | DISCHARGE TO OUTFALL |
|---------------|--------------------------|------------|------------|---------------------|----------------|------------|----------------|------------|----------------|----------------|--------------|--------------|-------------------------|--------------------------|----------------|----------------------|
| 1             | RAW SEWAGE               | 24694      | 2870       | 27465               | 27465          | -          | -              | 29884      | -              | 29716          | 54676        | 54676        | 24960                   | -                        | 27465          | 27465                |
| 2             | BELVIEW PS               | 32834      | 2870       | 35704               | 35704          | -          | -              | 38123      | 188            | 37955          | 71171        | 71171        | 33216                   | 1089                     | 35704          | 35704                |
| 3             | COMBINED RAW SEWAGE      | 138039     | 9904       | 148563              | 82394          | 63169      | 2419           | 84813      | -              | 84645          | 133509       | 133509       | 48884                   | -                        | 82394          | 145563               |


# DESIGN ISSUE

**A.W.I. CONTRACT No 1002**

**enpure**

Enpure Limited  
 Empire House,  
 Birmingham Road,  
 Kidderminster, DY10 2SH,  
 UK  
 Tel: +44 (0)1562 820 010  
 Fax: +44 (0)1562 820 008  
 Internet: www.enpure.co.uk


**WATERFORD CITY COUNCIL**

**SEWAGE TREATMENT PROCESS FLOW DIAGRAM WATERFORD WWTTW**

|            |            |            |               |
|------------|------------|------------|---------------|
| Drawn      | Checked    | Approved   | Original Size |
| DJH/MS     | DGH/MS     | JMN/NTS    | A1            |
| Date       | Date       | Date       | Scale         |
| 20/10/2006 | 04/05/2007 | 04/05/2007 | NTS           |

Dr. No. **C1197-1001** Rev. **E**

DO NOT SCALE - IF IN DOUBT ASK

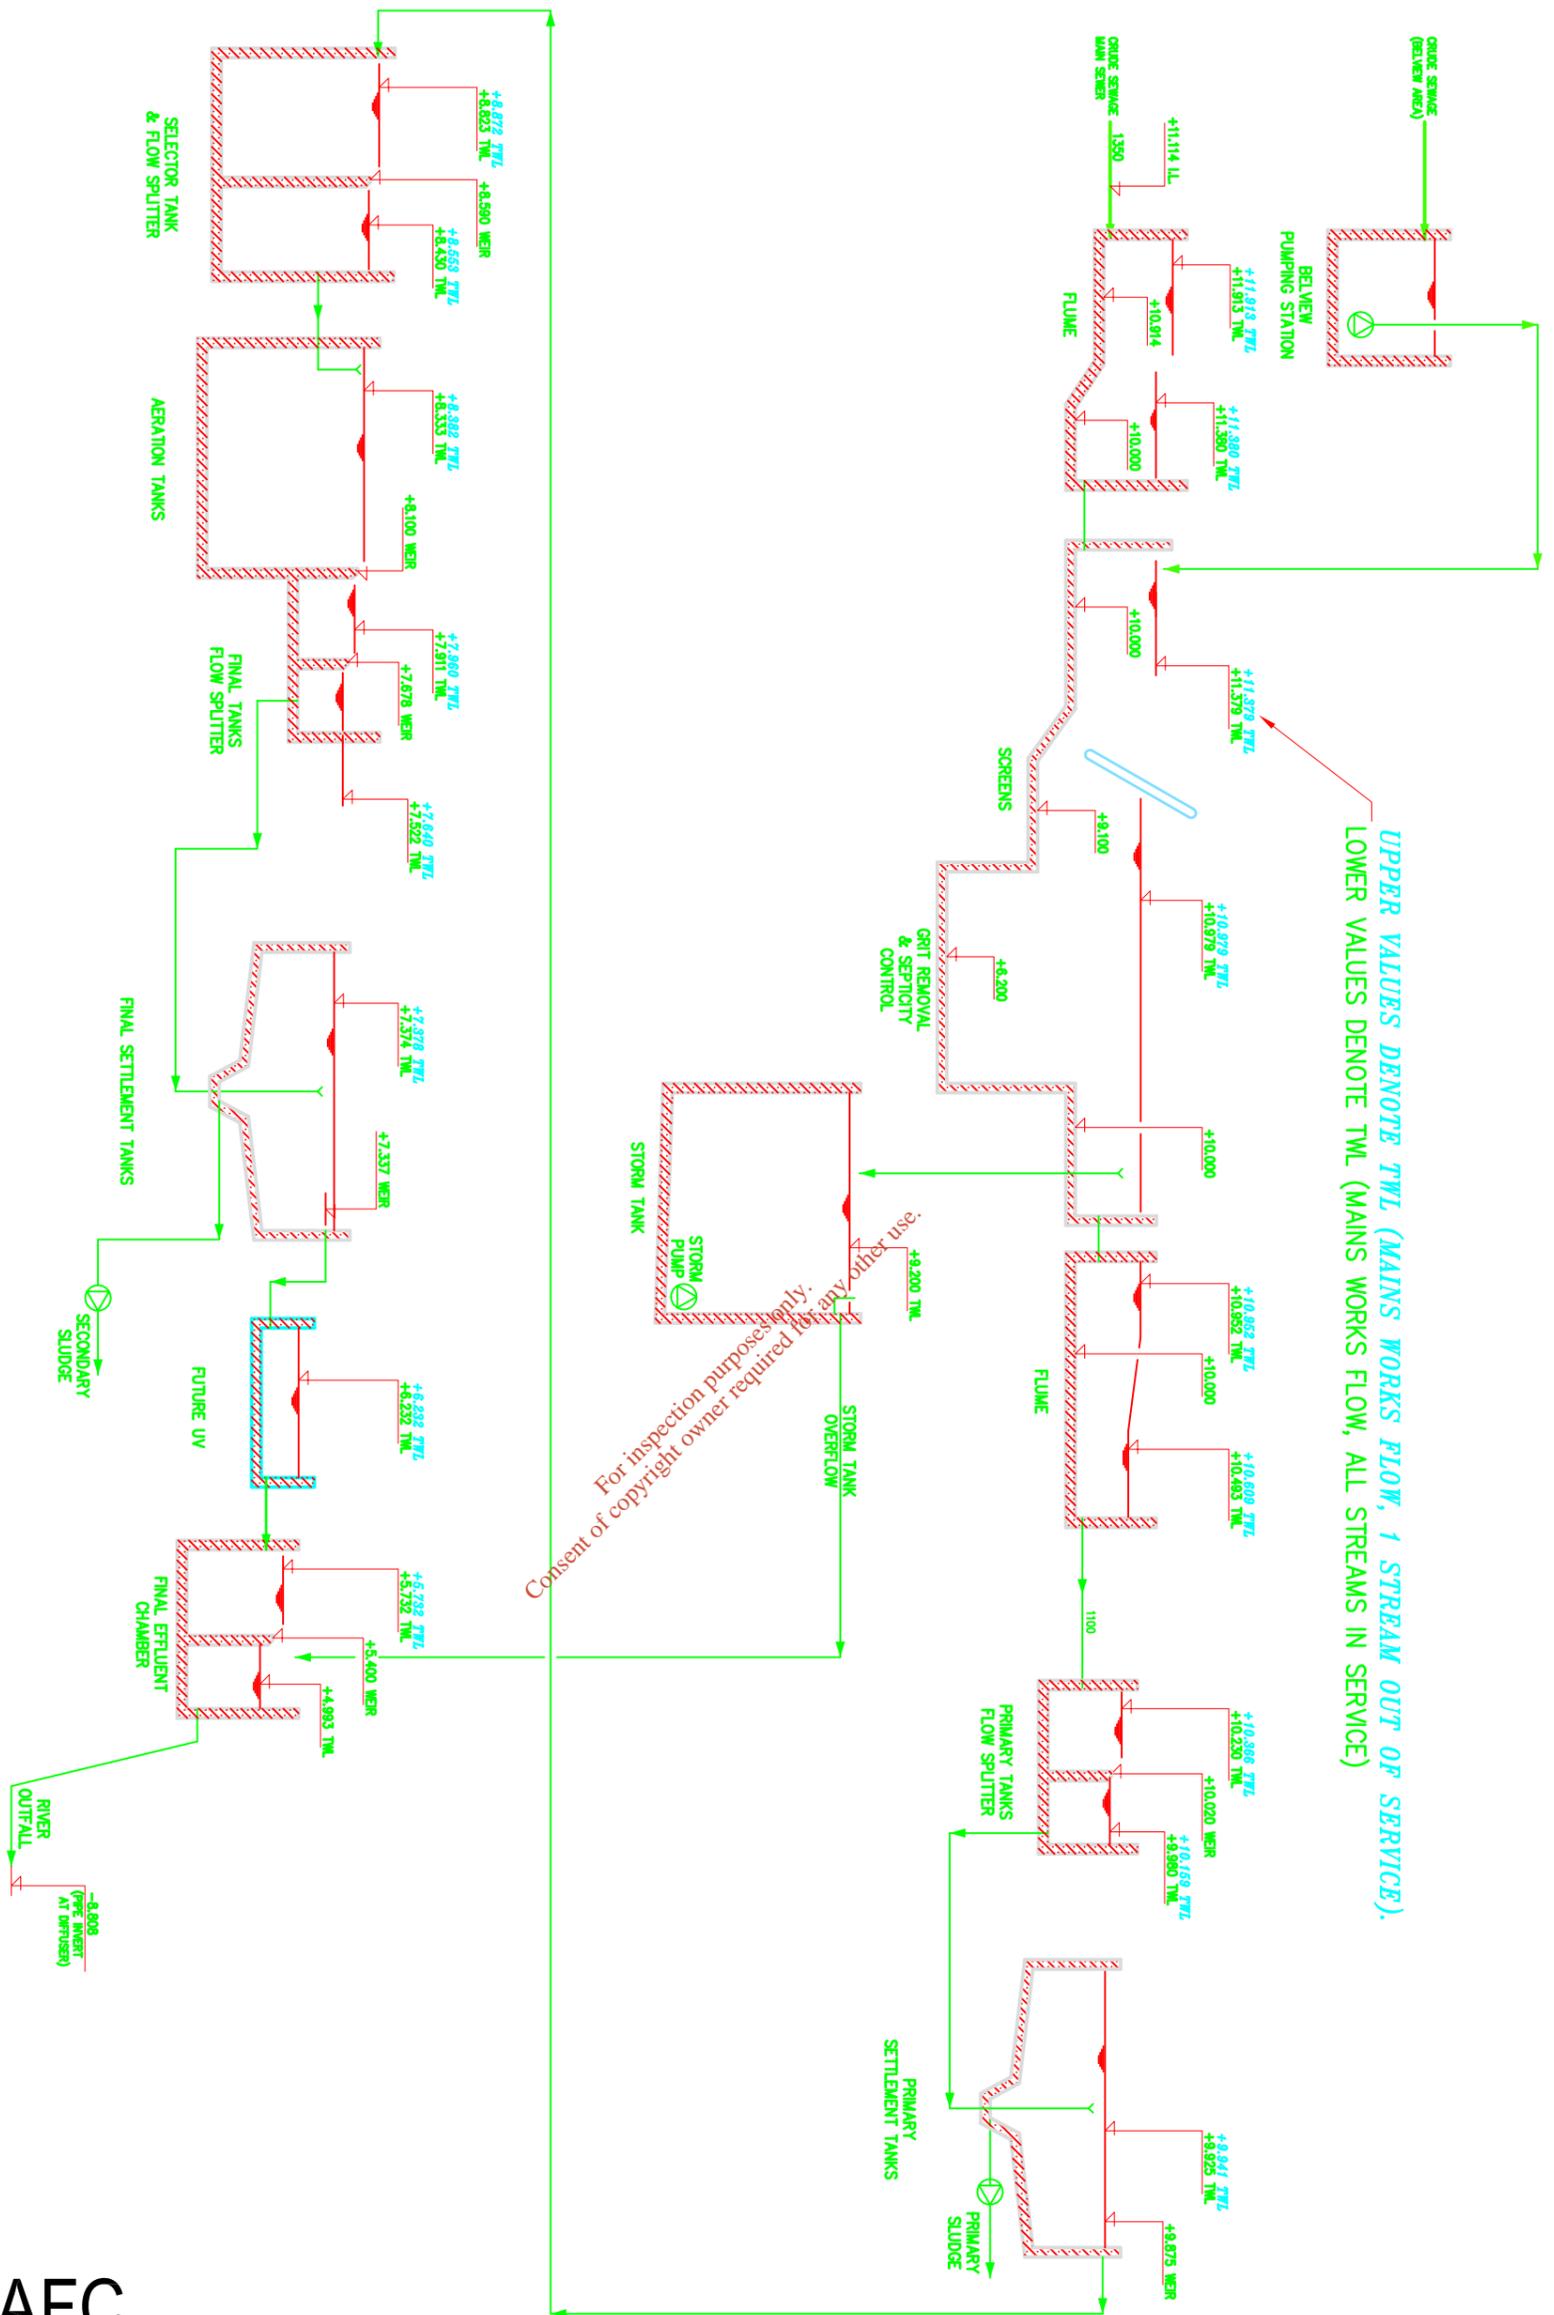

See Previous Issues For Past Revision Details

| Rev | Date       | Description                                 | Drawn |
|-----|------------|---|-------|
| 1   | 17/12/2007 | LEVELS REVISED IN LINE WITH AS BUILT WEIRS. | DDF   |

- NOTES
1. DRAWING PRELIMINARY E8374-1005
  2. LEVELS REVISED IN-LINE WITH HYDRAULIC CALCULATIONS.

| CHECKED        |     | APPROVED                |     |
|----------------|-----|-------------------------|-----|
| PROCESS ENG.   | DGH | PROCESS TECH SPECIALIST |     |
| PROJECT ENG.   | JMN | PROJECT MAN.            | CGP |
| LEAD MECH ENG. | JAM | MECH ENG MAN.           | ADG |
| LEAD ELEC ENG. |     | ELEC ENG MAN.           |     |

A.W.I. CONTRACT No 1002



Enpire Limited  
Enpire House,  
Birmingham Road,  
Kiddeminster, DY10 2SH,  
Tel: +44 (0)1562 820 010  
Fax: +44 (0)1562 820 008  
Internet: www.enpire.co.uk

All Copyright and Design Right subsisting in this document is the property of Enpire Limited of Enpire House, Birmingham Road, Kiddeminster, Dy10 2SH, without Enpire's written consent. This document and the information contained within it is confidential to Enpire Limited and may not be disclosed to any third party without Enpire's written consent.

CUSTOMER  
WATERFORD CITY COUNCIL

Title  
HYDRAULIC PROFILE  
SEWAGE SYSTEM  
WATERFORD WWTTW


| Drawn      | Checked    | Approved   | Original Size | Original Scale | Rev. |
|------------|------------|------------|---------------|----------------|------|
| DUTTLESLEY | RJUMILLER  | CGPAGE     | A1            | NTS            | 1    |
| Date       | Date       | Date       |               |                |      |
| 20/10/2006 | 17/12/2007 | 17/12/2007 |               |                |      |

Dr. No. C1197-1005

ISSUED AFC



DO NOT SCALE - IF IN DOUBT ASK

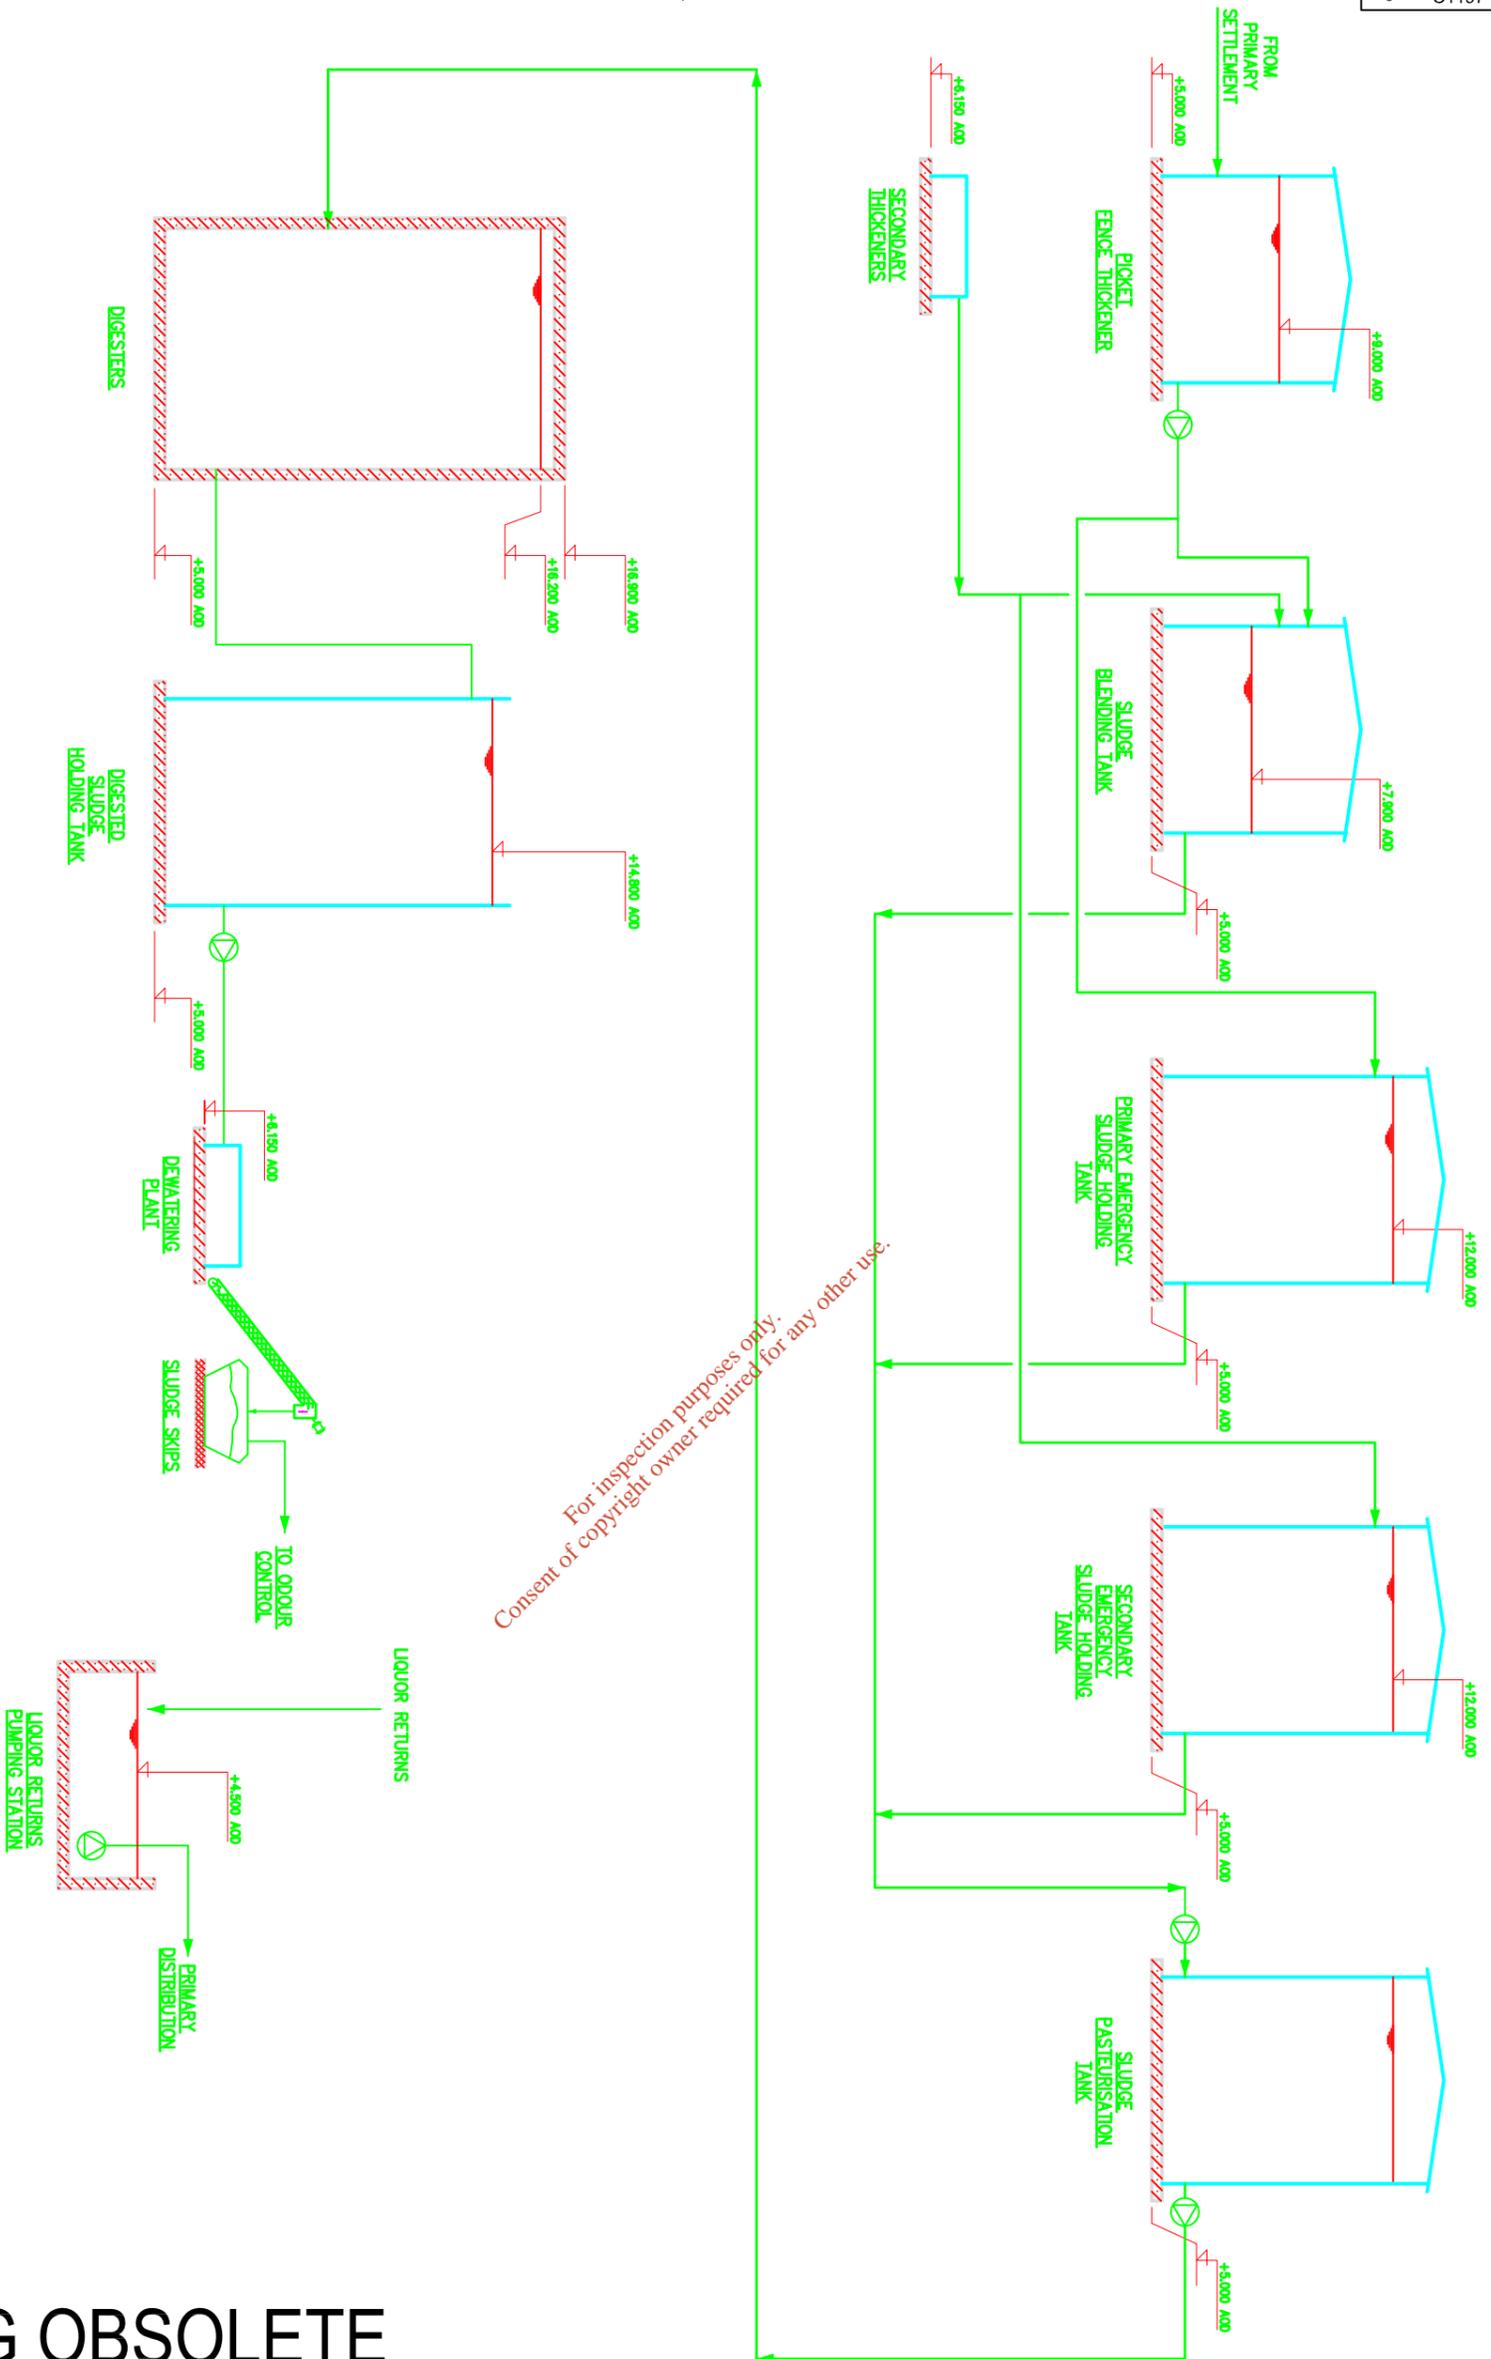

- NOTES**
1. DRAWING PREVIOUSLY E8374-1008
  2. EPS TO ADVISE ON LEVELS.

**LEGEND:**  
 NEW PIPEWORK/CHANNEL BY CIVILS CONTRACTOR.  
 NEW PIPEWORK BY MAKE CONTRACTOR.  
 EXISTING PIPEWORK/EQPT.

|                |                        |
|----------------|------------------------|
| PROCESS ENG.   | PROCESS TECH SPECMANIT |
| PROJECT ENG.   | PROJECT MAN.           |
| LEAD MECH ENG. | MECH ENG MAN.          |
| LEAD ELEC ENG. | ELEC ENG MAN.          |

**A.W.I. CONTRACT No 1002**

**enpure**



Enpire Limited  
 Enpire House,  
 Birmingham Road,  
 Kibblesmith, DY10 2SH,  
 UK  
 Tel: +44 (0)1562 820 010  
 Fax: +44 (0)1562 820 008  
 Internet: www.enpure.co.uk

**WATERFORD CITY COUNCIL**  
 WATERFORD WWTW

|             |            |            |                |
|-------------|------------|------------|----------------|
| Drawn       | Checked    | Approved   | Original Size  |
| DJ/Tilesley | Rádams     | Rádams     | A1             |
| Date        | Date       | Date       | Original Scale |
| 20/10/2006  | 07/08/2007 | 07/08/2007 | NTS            |

**DRAWING OBSOLETE**

Dr. No. **C1197-1006** Rev. **A**

| See Previous Issues For Past Revision Details |            |              |
|---|------------|--------------|
| Rev   | Date       | Description  |
| A   | 07/08/2007 | NOTES ADDED. |



| PURAC   |           |                                     |        | Project-Specific Data                                    |             |
|---|-----------|-------------------------------------|--------|--|-------------|
| Grit / Grease Removal   |           |                                     |        | Document Ref   | 8402        |
| Standard Process Calculation: Project-specific data input is permitted to highlighted areas only.   |           |                                     |        | Project No   | C1197       |
|   |           |                                     |        | Project Name   | Waterford   |
| Calc Ref:   | PCS001    | Rev 1                               | Page 1 | Process area code  |             |
| Author  | D Garnett | Refer to PCS index for full details |        | Tag No(s)  |             |
| Calculation status:   |           |                                     |        | Process Engineer   | D. Hemmings |
|   |           |                                     |        | Date   | 21-Nov-06   |
| <b>Description</b>  |           |                                     |        |  |             |
| Two longitudinal, spiral flow type aerated grit and grease removal tanks are to be utilised. A bypass channel capable of taking 50% of the flow is also included should one lane be out of service. |           |                                     |        |  |             |
| <b>Plant Flows</b>  |           |                                     |        |  |             |
| Peak flow   |           | 1.685                               | m3/s   |  |             |
| Mean flow   |           | 0.413                               | Cumecs |  |             |
| Minimum flow  |           | 0.318                               | Cumecs |  |             |
| <b>Design parameters</b>  |           |                                     |        |  |             |
| Detention time  |           |                                     |        |  |             |
| At maximum flow   |           | 3.0                                 | Mins   | Ref: Metcalf and Eddy 4th Edition page 389               |             |
| Adopt maximum flow  |           | 1.685                               | Cumecs |  |             |
| No. of channels   | Select    | 2                                   | No.    | Ref: Vol 4 section 7.3.2                                 |             |
| No. of channels as standby  | Select    | 0                                   | No.    |  |             |
| No. of operational channels   |           | 2                                   | No.    |  |             |
| Total volume required   |           | 303                                 | m3     |  |             |
| Volume per channel  |           | 152                                 | m3     |  |             |
| Detention time  |           |                                     |        |  |             |
| At average flow   |           | 12.2                                | Mins   |  |             |
| Channel cross section - see also sketch   |           |                                     |        |  |             |
| D1 : Depth of channel   | Select    | 4.00                                | m      | Ref: Metcalf and Eddy 4th Edition page 389               |             |
| W1 : Width of Grit channel  |           | 3.40                                | m      |  |             |
| W2 : Width of grease channel  |           | 1.70                                | m      |  |             |
| W1 approx 0.85*D  |           |                                     |        |  |             |
| W2 approx W1/2 and between 1 - 2m   |           |                                     |        |  |             |
| W4 Width : Wall to grit sump  | Select    | 0.75                                | m      |  |             |
| W3 Width of grit sump   | Select    | 0.75                                | m      |  |             |
| D2 Depth of grit sump   | Select    | 0.85                                | m      |  |             |
| Angle A of benching   | Select    | 60                                  |        |  |             |
| Angle B of channel floor  | Select    | 45                                  |        |  |             |
| <hr/>   |           |                                     |        |  |             |
| Area a  |           | 20.4                                | m2     |  |             |
| Area b  |           | 0.5                                 | m2     |  |             |
| Area c  |           | 4.8                                 | m2     |  |             |
| Cross sectional area of channel   |           | 15.1                                | m2     |  |             |
| <hr/>   |           |                                     |        |  |             |
| Length of channel   |           | 10.01                               | m      |  |             |
| <hr/>   |           |                                     |        |  |             |
| Actual Length   | Rounded   | 10.00                               | m      |  |             |
| Actual W1   | Rounded   | 3.40                                | m      |  |             |
| Actual W2   | Rounded   | 1.70                                | m      |  |             |
| Total channel width   |           | 5.10                                | m      |  |             |
| <hr/>   |           |                                     |        |  |             |
| Check hydraulic rate at maximum flow  |           | 59.5                                | m/h    | Note: don't consider surface of grease removal normally. |             |
|   |           | 0.017                               | m/s    |  |             |
| Check hydraulic rate in non-aerated section   |           | 178.39                              | m/h    |  |             |
| <hr/>   |           |                                     |        |  |             |
| <i>Purac AB design notes:</i>   |           |                                     |        |  |             |
| Take cross section area around  | 10 and 15 |                                     | m2     |  |             |
| Take typical airflow as   | 40        |                                     | m3/hr  |  |             |
| The airflow will be set on site.  |           |                                     |        |  |             |
| Use one Saunders valves per down comer and perforated stainless steel pipes DN40-50 as aerators.  |           |                                     |        |  |             |
| Fat removal zone width between  | 1 and 2   |                                     | m      |  |             |
| Retention time at maximum flow  | 3 to 5    |                                     | min    |  |             |
| Hydraulic load in non aerated zone  | 25        |                                     | m/hr   |  |             |


**Air Requirement**

Metcalf and Eddy states that an airflow of between 12 and 30 m<sup>3</sup>/h per m length of tank is required.

|  |                    |       |
|--|--------------------|-------|
| Nm <sup>3</sup> /h of air per m length of tank | Nm <sup>3</sup> /h | 20.0  |
| Air Requirement                                | Nm <sup>3</sup> /h | 200.0 |

|                                |                                     |        |   |
|--------------------------------|-------------------------------------|--------|---|
| Expected grit quantities       | m <sup>3</sup> /1000 m <sup>3</sup> | 0.0150 | Ref Metcalf and Eddy 4th Edition page 389 |
| Grit quantities @ average flow | m <sup>3</sup> /d                   | 0.54   |   |

**Cross Section - Grit and Grease Channel**

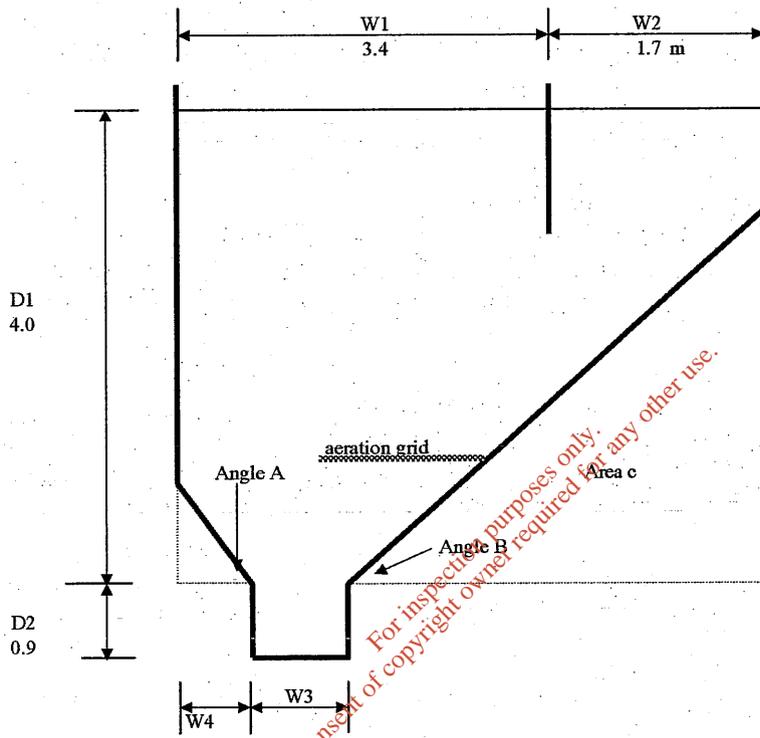



|  |           |                                     |                              |            |
|--|-----------|-------------------------------------|------------------------------|------------|
| <b>PURAC</b>   |           |                                     | <b>Project-Specific Data</b> |            |
| <b>Primary Settlement Tank Design: Radial Flow</b>   |           |                                     | Document Ref                 | 8403       |
| <i>Standard Process Calculation: Project-specific data input is permitted to highlighted areas only.</i> |           |                                     | Project No                   | C1197      |
| Calc Ref:  | Rev       | Page 1                              | Project Name                 | Waterford  |
| Author   | D Garnett | Refer to PCS index for full details | Process area code            |            |
| Calculation status:  | CHECKED   | M HARPAM                            | Tag No(s)                    |            |
|  |           |                                     | Process Engineer             | D.Hemmings |
|  |           |                                     | Date                         | 30/10/2006 |

#### APPLICATION

Provides guidance in design of radial flow (circular) tanks for primary sedimentation of municipal wastewaters.

#### References

#### INTRODUCTION

Sedimentation tank design is not a precise science; judgement and experience are required. USA practice specifies tank depths as a design criteria whereas UK practice tends to ignore this parameter. The calculation below is based on UK practice where the surface loading does not exceed 45 m<sup>3</sup>/m<sup>2</sup>.day.

#### INPUTS

|                         |                     | Maximum | Minimum | Average |                        |
|-------------------------|---------------------|---------|---------|---------|------------------------|
| Inflow to Primary Tanks | (m <sup>3</sup> /h) | 3534    | 1221    | 1564    | From 8000-Design Basis |
|                         | lps                 | 982     | 339     | 435     |                        |
| Liquor returns          | (m <sup>3</sup> /h) | 101     | 77      | 77      |                        |
| Required No. Tanks      |                     | 2       |         |         |                        |

#### SURFACE LOADING

##### Recommended Surface Loading

|                   |           |                                   |                       |
|-------------------|-----------|-----------------------------------|-----------------------|
| Radial Flow Tanks | 45        | m <sup>3</sup> /m <sup>2</sup> .d | all tanks in service  |
|                   | < 80      | m <sup>3</sup> /m <sup>2</sup> .d | 1 tank out of service |
| Upward Flow Tanks | 28.8 - 43 | m <sup>3</sup> /m <sup>2</sup> .d |                       |

References: - Manual of British Practice in Water Pollution Control 'Primary Sedimentation'

#### TANK DESIGN

|                                    |                                   |       |  |
|------------------------------------|-----------------------------------|-------|--|
| Design Loading                     | m <sup>3</sup> /m <sup>2</sup> .d | 45.0  |  |
| Minimum tank diameter              | (m)                               | 34.6  |  |
| Actual Tank Diameter               |                                   | 32.0  |  |
| Tank Gross Surface Area - per tank | (m <sup>2</sup> )                 | 804.2 |  |
| Minimum stilling well diameter     | (m)                               | 4.800 | at 15 % of tank diameter (normal range 15-20%)   |
| Actual stilling well diameter      | (m)                               | 5.20  | Vol 4 section 7.6 states 10% liquid surface area |
| Stilling well surface area         | (m <sup>2</sup> )                 | 21.24 |  |
| Velocity in Stilling Well          | (m/s)                             | 0.02  |  |
| Stilling Well :Tank Diameter       | %                                 | 16.3  |  |
| Stilling Well Area:Tank Area       | %                                 | 2.64  |  |
| Tank nett surface - per tank       | (m <sup>2</sup> )                 | 802   |  |

|                                    |                                       | Maximum Flow |       | Min Flow | Average Flow |      |
|------------------------------------|---------------------------------------|--------------|-------|----------|--------------|------|
| No. tanks in operation             |                                       | 2            | 1     | 2        | 2            | 1    |
| Tank Surface Gross Loading         | (m <sup>3</sup> /m <sup>2</sup> .day) | 52.7         | 105.5 | 18.2     | 23.3         | 46.7 |
| Tank Surface Nett Loading          | (m <sup>3</sup> /m <sup>2</sup> .day) | 52.9         | 105.8 | 18.3     | 23.4         | 46.8 |
| (allowing for inlet diffuser drum) | m/h                                   | 2.20         | 4.41  | 0.76     | 0.98         | 1.95 |

#### SIDE WALL DEPTH

Tank geometry is important for good performance since interference can occur between the incoming high velocity diffuser zone and the sludge zone (particularly in final settlement tanks) when tanks are too shallow. Note that primary tanks where activated and primary sludge are cosettled have a higher minimum sidewall height. The values calculated below are based on a floor slope of 7.5 degrees. Should the floor slope be steeper lower values may be acceptable.

|                                    | Minimum | Preferred |
|------------------------------------|---------|-----------|
| Primary Sidewall Depth             | 2.10    | 3         |
| Primary Sidewall Depth (Cosettled) | 2.40    | 3         |
| Actual Sidewall Depth              | 2.50    |           |

#### DIFFUSER DRUM SIZING

|                       |     |                |                |                       |
|-----------------------|-----|----------------|----------------|-----------------------|
| Tank Diameter         | (m) | 32.00          |                |                       |
|                       |     | <b>Minimum</b> | <b>Maximum</b> |                       |
| Primary Drum Diameter | (m) | 4.80           | 6.40           |                       |
| Storm Drum Diameter   | (m) | 4.80           | 6.40           |                       |
| Drum Immersion        | (m) | 0.300          | 1.500          | Should be at least 1m |
| Height above TWL      | mm  | 300            | 300            |                       |

**FLOOR SLOPE** (Exception cone bottomed tanks [no sludge scrapers] typically 60 degrees)

Minimum floor slope is 7.5 degrees, preferred floor slope is 11 degrees.

|                      |                |      |   |
|----------------------|----------------|------|---|
| Floor Slope Selected | degrees        | 7.5  |   |
| Depth due to slope   | m              | 2.11 | Vol 4 sect. 7.6 minimum specified wall height 2.5 m |
| Volume of cone       | m <sup>3</sup> | 22   |   |

**SCRAPER SPEED**

|                          |     |   |
|--------------------------|-----|---|
| Number of scraper blades | 2   |   |
| Efficiency of Scraper    | 1.3 | Note : Efficiency is 1.3 for scraper system, 1.0 for suction lift system. |

|                           |       | Minimum | Maximum | Selected |   |
|---------------------------|-------|---------|---------|----------|---|
| Peripheral scraper speed  | m/min | 1.2     | 1.5     | 1.5      | Vol 4 sect. 7.6 maximum speed 2.5 m/min |
| Circumference of tank     | m     | 100.5   |         |          |   |
| Time Period Between Blade | mins  | 54.5    | 43.6    | 43.6     |   |

**NUMBER OF SCRAPERS IS SATISFACTORY**

Preferred scraper speed is 1.5 m/min for primary tanks. Note for large tanks (>30m) this can be increased to 1.8 to 2m/min.

**RETENTION TIME**

|                  |                |      |
|------------------|----------------|------|
| Capacity of tank | m <sup>3</sup> | 2033 |
|------------------|----------------|------|

|                             |                     | Maximum | Minimum | Average |
|-----------------------------|---------------------|---------|---------|---------|
| Inflow to each Primary Tank | (m <sup>3</sup> /h) | 1767    | 611     | 782     |
| Sewage retention time       | hrs                 | 1.2     | 3.3     | 2.6     |

Note that this is not a critical parameter but in order to prevent septicity the following guidelines should be adhered to where possible: -  
Retention period should not exceed 8 hours at DWF.  
retention time at maximum flow shouldn't greatly exceed 2 hours.

**SLUDGE HOPPER**

Where automatic or frequent manual desludging is employed, it is recommended that the hopper should have a nominal size based on a depth of approximately 1.5m. This provides for sludge thickening within the hopper. The hopper should have sloping sides not less than 60 degrees to the horizontal and the base of the hopper should have a diameter not greatly exceeding 1m.

|                         |                |      |
|-------------------------|----------------|------|
| Diameter of hopper base | m              | 1.5  |
| Depth Of Hopper         | m              | 1.5  |
| Volume of sludge hopper | m <sup>3</sup> | 0.86 |

**Weir Loading Criteria**

Primary Tanks Must be greater than 100 m<sup>3</sup>/md to prevent surface effects.  
Preferred value of around 300 m<sup>3</sup>/md  
Maximum allowable 450 m<sup>3</sup>/md

**V NOTCH WEIR SIZING (90° NOTCHES)**

|                                |                     |      |   |
|--------------------------------|---------------------|------|---|
| Max Notch Discharge            | (m <sup>3</sup> /d) | 30.0 | Maximum discharge per notch is 30-40 m <sup>3</sup> /d. |
| Min Number of Notches per tank |                     | 1414 |   |
| Circumference                  | m                   | 101  |   |

Based on 2m long boards the maximum number of V notches per board is:-

Required No. V notches per 2m plate is 28 and since the maximum number of V notches in a 2m long plate is 19, a double sided weir is required  
Actual No. V notches per 2m long plate 2

|                     |                           |
|---------------------|---------------------------|
| Actual No Notches   | 200                       |
| Act Notch Discharge | (m <sup>3</sup> /d) 212.0 |

Vert Head Thro Notch (mm) 80.7 (normally around 30 to 35mm)

|                       |                      |      |                               |
|-----------------------|----------------------|------|-------------------------------|
| Effective Weir Length | (m)                  | 32.3 | for a 45 degree V notch weir. |
| Weir Loading          | (m <sup>3</sup> /md) | 1313 | (all tanks in operation)      |
|                       |                      | 2627 | (1 tank out of service)       |



|   |           |                                     |                              |                |
|---|-----------|-------------------------------------|------------------------------|----------------|
| <b>PURAC</b>  |           |                                     | <b>Project-Specific Data</b> |                |
| <b>IBA Plant Design</b>   |           |                                     | Document Ref                 | 8405           |
| Standard Process Calculation: Project-specific data input is permitted to highlight areas only. |           |                                     | Project No                   | C1197          |
| Calc Ref:   | PCS001    | Rev                                 | Process area code            |                |
| Author  | D Garnett | Refer to PCS index for full details | Tag No(s)                    |                |
| Calculation status:   |           |                                     | Process Engineer             | Dave Hemmings  |
|   |           |                                     | Date                         | 13th July 2005 |

**Inlet Data**

**Year 2005**

Dry Weather Flow, l/s  
Average Daily Flow, l/s  
Peak Flow For Biological Treatment, l/s

| Raw Sewage | Return Liquors | Total Flow |
|------------|----------------|------------|
| 196.7      | 12.3           | 209.0      |
| 255.7      | 21.3           | 277.0      |
| 590.0      | 21.3           | 611.3      |

From 8000-Design Basis +  
8050 Flow Diagram

**Year 2025 (Tender)**

Dry Weather Flow, l/s  
Average Daily Flow, l/s  
Peak Flow For Biological Treatment, l/s

| Raw Sewage | Return Liquors | Total Flow |
|------------|----------------|------------|
| 317.9      | 28.0           | 345.9      |
| 413.2      | 28.0           | 441.3      |
| 953.6      | 28.0           | 981.7      |

From 8000-Design Basis +  
8050 Flow Diagram

**Year 2025**

Dry Weather Flow, l/s  
Average Daily Flow, l/s  
Peak Flow For Biological Treatment, l/s

| Raw Sewage | Return Liquors | Total Flow |
|------------|----------------|------------|
| 317.9      | 28.0           | 345.9      |
| 413.2      | 28.0           | 441.3      |
| 953.6      | 28.0           | 981.7      |

From 8000-Design Basis +  
8050 Flow Diagram

|  | Raw Load<br>kg/d | RL's<br>kg/d | Load to PST<br>kg/d | Concentration, mg/l |              |
|--|------------------|--------------|---------------------|---------------------|--------------|
|  |                  |              |                     | Raw @DWF            | Raw+RLs @DWF |
| Average Daily BOD5 Load 2005                 | 6654             | 993.0        | 7647                | 346                 | 320          |
| Average Daily BOD5 Load 2025                 | 11436            | 1035.0       | 12471               | 349                 | 327          |
| Average Daily BOD5 Load 2025                 | 13724            | 1035.0       | 14759               | 413                 | 387          |
| Average Daily SS Load 2005                   | 4378             | 1163.0       | 5531                | 250                 | 231          |
| Average Daily SS Load 2025                   | 8005             | 1227.0       | 9232                | 259                 | 242          |
| Average Daily SS Load 2025                   | 9606             | 1227.0       | 10833               | 303                 | 284          |
| Average Daily TKN Load 2005                  |                  |              | 0                   | 0                   | 0            |
| Average Daily TKN Load 2025                  |                  |              | 0                   | 0                   | 0            |
| Average Daily TKN Load 2025                  |                  |              | 0                   | 0                   | 0            |
| Average Daily TN Load 2005                   |                  |              | 0                   | 0                   | 0            |
| Average Daily TN Load 2025                   |                  |              | 0                   | 0                   | 0            |
| Average Daily TN Load 2025                   |                  |              | 0                   | 0                   | 0            |
| Average Daily NH3 Load 2005                  | 1066             | 135.0        | 1201                | 54                  | 50           |
| Average Daily NH3 Load 2025                  | 1217             | 135.0        | 1352                | 38                  | 35           |
| Average Daily NH3 Load 2025                  | 1461             | 135.0        | 1596                | 45                  | 42           |
| Average Daily TP Load 2005                   |                  |              | 0                   | 0                   | 0            |
| Average Daily TP Load 2025                   |                  |              | 0                   | 0                   | 0            |
| Average Daily TP Load 2025                   |                  |              | 0                   | 0                   | 0            |
| Percentage Volatile Solids                   | %                |              |                     | 70                  |              |
| Percentage Volatile Solids in settled sewage | %                |              |                     | 80                  |              |
| Percentage Soluble BOD in raw sewage         | %                |              |                     | 30                  |              |
| Percentage Soluble BOD in return liquors     | %                |              |                     | 80                  |              |
| TKN:BOD Ratio                                |                  |              |                     | 0.0                 |              |
| Are return liquors sent to ASP or inlet      |                  |              |                     |                     | Inlet        |

DGHemmings:  
+20% extra load

DGHemmings:  
+20% extra load

DGHemmings:  
+20% extra load

For inspection purposes only. Consent of copyright owner required for all other uses.

| Effluent Consent Standard                |                        |                         | Average | 95 % 'ile     |      |               |       |
|--|------------------------|-------------------------|---------|---------------|------|---------------|-------|
| COD                                      | From 8000-Design Basis | mg/l                    | 62.5    | 125           |      |               |       |
| BOD                                      | From 8000-Design Basis | mg/l                    | 12.5    | 25            |      |               |       |
| SS                                       | From 8000-Design Basis | mg/l                    | 17.5    | 35            |      |               |       |
| NH3                                      |                        | mg/l                    | N/A     | #VALUE!       |      |               |       |
| TN                                       |                        |                         | N/A     | #VALUE!       |      |               |       |
| P  |                        |                         | N/A     | #VALUE!       |      |               |       |
| <b>Primary Tanks</b>                     |                        |                         |         |               |      |               |       |
| No. of Tanks                             |                        |                         | 2       |               |      |               |       |
| SS Removal Efficiency (max)              | %                      |                         | 60      | From 8403-PST |      |               |       |
| SS Removal Efficiency (min)              | %                      |                         | 55      | From 8403-PST |      |               |       |
| BOD5 Removal Efficiency (max)            | %                      |                         | 30      | From 8403-PST |      |               |       |
| BOD5 Removal Efficiency (min)            | %                      |                         | 25      | From 8403-PST |      |               |       |
| TKN/TN Removal Efficiency (max)          | %                      |                         | 0       |               |      |               |       |
| TKN/TN Removal Efficiency (min)          | %                      |                         | 0       |               |      |               |       |
| N-NH4 Removal Efficiency (max)           | %                      |                         | 0       |               |      |               |       |
| N-NH4 Removal Efficiency (min)           | %                      |                         | 0       |               |      |               |       |
| <b>Primary Sludge Production</b>         |                        |                         |         |               |      |               |       |
|  |                        | Sludge Production, m3/d |         |               |      |               |       |
| Percentage Dry Solids                    | %                      | 1.5                     | 2       | 3             | 5    |               |       |
| Max Removal in year 2005                 | kg/d                   | 3318                    | 221     | 166           | 111  | 66            |       |
| Min Removal in year 2005                 | kg/d                   | 3042                    | 203     | 152           | 101  | 61            |       |
| Max Removal in year 2025                 | kg/d                   | 5539                    | 369     | 277           | 185  | 111           |       |
| Min Removal in year 2025                 | kg/d                   | 5078                    | 339     | 254           | 169  | 102           |       |
| Max Removal in year 2025                 | kg/d                   | 6500                    | 433     | 325           | 217  | 130           |       |
| Min Removal in year 2025                 | kg/d                   | 5958                    | 397     | 298           | 199  | 119           |       |
| <b>SECONDARY TREATMENT</b>               |                        |                         |         |               |      |               |       |
|  |                        | Yr 2005                 |         | Yr 2025       |      | Yr 2025 + 20% |       |
|  |                        | Max                     | Min     | Max           | Min  | Max           | Min   |
| BOD Load To Secondary Stage              | kg/d                   | 5736                    | 5353    | 9353          | 8730 | 11069         | 10331 |
| Soluble BOD Component                    | kg/d                   | 2791                    | 2791    | 4259          | 4259 | 4945          | 4945  |
| Percentage Soluble BOD                   | %                      | 49                      | 52      | 46            | 49   | 45            | 48    |
| TKN Load To Secondary Treatment          | kg/d                   | 0                       | 0       | 0             | 0    | 0             | 0     |
| SS To Secondary Treatment Stage          | kg/d                   | 2489                    | 2212    | 4155          | 3693 | 4875          | 4333  |
| Volatile SS Component                    | %                      | 80                      |         |               |      |               |       |
| Volatile SS Component                    | kg/d                   | 1991                    | 1770    | 3324          | 2954 | 3900          | 3467  |
| Inorganic SS Component                   | kg/d                   | 498                     | 442     | 831           | 739  | 975           | 867   |
| NH4-N Load                               | kg/d                   | 1203                    | 1201    | 1352          | 1352 | 1596          | 1596  |
| TN Load                                  | kg/d                   | 0                       | 0       | 0             | 0    | 0             | 0     |
| <b>Concentrations at DWF</b>             |                        |                         |         |               |      |               |       |
|  |                        | Yr 2005                 |         | Yr 2025       |      | Yr 2025 + 20% |       |
|  |                        | Max                     | Min     | Max           | Min  | Max           | Min   |
| BOD concentration To Secondary Stage     |                        | 318                     | 296     | 313           | 292  | 370           | 346   |
| Soluble BOD Component                    |                        | 155                     | 155     | 143           | 143  | 165           | 165   |
| Percentage Soluble BOD                   |                        | 0                       | 0       | 0             | 0    | 0             | 0     |
| TKN concentration To Secondary Treatment |                        | 0                       | 0       | 0             | 0    | 0             | 0     |
| SS To Secondary Treatment Stage          |                        | 138                     | 123     | 139           | 124  | 163           | 145   |
| Volatile SS Component                    |                        |                         |         |               |      |               |       |
| Volatile SS Component                    |                        | 110                     | 98      | 111           | 99   | 130           | 116   |
| Inorganic SS Component                   |                        | 28                      | 25      | 28            | 25   | 33            | 29    |
| NH4-N concentration                      |                        | 67                      | 67      | 45            | 45   | 53            | 53    |
| <b>Concentrations at Average Flow</b>    |                        |                         |         |               |      |               |       |
|  |                        | Yr 2005                 |         | Yr 2025       |      | Yr 2025 + 20% |       |
|  |                        | Max                     | Min     | Max           | Min  | Max           | Min   |
| BOD concentration To Secondary Stage     |                        | 240                     | 224     | 245           | 229  | 290           | 271   |
| Soluble BOD Component                    |                        | 117                     | 117     | 112           | 112  | 130           | 130   |
| Percentage Soluble BOD                   |                        |                         |         |               |      |               |       |
| COD concentration To Secondary Treatment |                        | 0                       | 0       | 0             | 0    | 0             | 0     |
| SS To Secondary Treatment Stage          |                        | 104                     | 92      | 109           | 97   | 128           | 114   |
| Volatile SS Component                    |                        |                         |         |               |      |               |       |
| Volatile SS Component                    |                        | 83                      | 74      | 87            | 77   | 102           | 91    |
| Inorganic SS Component                   |                        | 21                      | 18      | 22            | 19   | 26            | 23    |
| NH4-N concentration                      |                        | 50                      | 50      | 35            | 35   | 42            | 42    |

**SLUDGE PRODUCTION**

**Extended Aeration** Not used in design

Note : This equation applies where primary tanks are not utilised and where extended aeration is practiced. It should not be used if trade effluents containing non-degradable or slowly biodegradable solids are present. For a more detailed calculation see spreadsheet entitled 'SAS Production Rate'.

|   |               |      |      |      |      |
|---|---------------|------|------|------|------|
| Sludge Loading (F/M Ratio)  | kgBOD/kgTSSd. | 0.3  |      |      |      |
| Temperature   | degrees C     | 8    | 10   | 12   | 20   |
| Ratio of non biodegradable solids in raw sewage / total SS in raw sewage. |               | 0.2  | 0.2  | 0.2  | 0.2  |
| Ratio of total raw sewage SS to raw sewage BOD (Fallback value =1.2)      |               | 0.72 |      |      |      |
| Temperature   | degrees C     | 8    | 10   | 12   | 20   |
| Sludge Yield  |               | 0.79 | 0.79 | 0.78 | 0.73 |
| Max Sludge Production (Yr 2005)   | kg/d          | 4556 | 4514 | 4466 | 4194 |
| Min Sludge Production (Yr 2005)   | kg/d          | 4252 | 4213 | 4168 | 3915 |
| Max Sludge Production (Yr 2025)   | kg/d          | 7420 | 7367 | 7288 | 6846 |
| Min Sludge Production (Yr 2025)   | kg/d          | 6934 | 6871 | 6798 | 6384 |
| Max Sludge Production (Yr 2025)   | kg/d          | 8792 | 8712 | 8619 | 8095 |
| Min Sludge Production (Yr 2025)   | kg/d          | 8206 | 8131 | 8045 | 7555 |

**Conventional Aeration**

For well settled sewage the following equation can be used. This applies for a temperature range of 7 to 25 C

|                                 |                            |       |      |      |      |
|---------------------------------|----------------------------|-------|------|------|------|
| Sludge Loading (F/M Ratio)      | kgBOD/kgTSSd.              | 0.27  |      |      |      |
| Temperature                     | degrees C                  | 8     | 10   | 12   | 20   |
| Sludge Yield                    | 0.75 used in tender design | 1.01  | 0.75 | 0.80 | 0.51 |
| Max Sludge Production (Yr 2005) | kg/d                       | 5810  | 4302 | 4569 | 2899 |
| Min Sludge Production (Yr 2005) | kg/d                       | 5423  | 4015 | 4264 | 2706 |
| Max Sludge Production (Yr 2025) | kg/d                       | 9475  | 7015 | 7454 | 4727 |
| Min Sludge Production (Yr 2025) | kg/d                       | 8844  | 6547 | 6954 | 4412 |
| Max Sludge Production (Yr 2025) | kg/d                       | 11213 | 8302 | 8817 | 5594 |
| Min Sludge Production (Yr 2025) | kg/d                       | 10466 | 7748 | 8229 | 5221 |

**Selector Tank Volume**

Design Basis : minimum of 30 mins at DWF plus RAS or 10 mins at max flow plus RAS

Assuming RAS remains constant for both flows.

|                                 |           |  |         |               |
|---------------------------------|-----------|--|---------|---------------|
| RAS Flow                        | m3/h      | Yr 2005  | Yr 2025 | Yr 2025 + 20% |
| 30 mins at DWF plus RAS         | m3        | 752  | 2036    | 2036          |
| 10 mins at max flow plus RAS    | m3        | 730  | 1590    | 1590          |
| 30 mins at DWF                  |           | 479  | 912     | 912           |
| Selector Zone Volume            | m3        | 354  | 572     | 572           |
|                                 |           | 730  | 1590    | <b>1590</b>   |
| MLSS                            | kg/m3     | 3.5  |         |               |
| Number of selector tanks        |           | 1  |         |               |
| Water Depth                     | m         | 5  |         |               |
| Tank Length                     | m         | 12   |         |               |
| Tank Width                      | m         | 10   |         |               |
| Actual Volume per tank          | m3        | 600  |         |               |
| Proposed Selector Tank Volume   | <b>m3</b> | <b>600</b> Selected to give floc loading >2.3        |         |               |
| Actual Retention Time           | mins      | DWF  | Average | Peak          |
| Actual Retention Time (inc RAS) | mins      | 51   | 39      | 17            |
| Floc Loading (>2.3)             |           | <b>4.5</b> (BOD kg/d /Mixed Liquor Mass in Selector) |         |               |

Note: The Floc Loading should be greater than 2.3 to encourage the growth of floc forming bacteria. This can be increased by lowering the selector volume or mixed liquor suspended solids.

|                    |     |
|--------------------|-----|
| Selected F/M ratio | 0.3 |
| Operating MLSS     | 3.5 |


|                 |                      |  |
|-----------------|----------------------|--|
| Volume Required | 10542 m <sup>3</sup> | Based upon 2025 load with 20% extra                          |
| Volume Selected | 10600                | as requirement to meet consent with one lane out of service. |

**Inclined Bubble Aeration Ditch**

|                                  |    |       |                           |
|----------------------------------|----|-------|---------------------------|
| Selector Volume Required         | m3 | 600   |                           |
| Total Volume For Oxidation ditch | m3 | 10600 |                           |
|                                  |    |       | Tender drawing shows tank |
| Number of streams                | m3 | 4     |                           |
| Volume Per stream                | m3 | 2650  |                           |
| Minimum Sewage Depth             | m  | 5     | 5                         |
| Width of each lane               | m  | 7     | 7                         |
| Straight Length of each tank     | m  | 38    | 48.5                      |
| Actual Volume Per Tank           | m3 | 2660  | 3395                      |
| Recycle Ratio (FST to ditch)     |    | 1     |                           |

Ref: Vol 4 section 7.7.1 minimum sludge 5 days @ 10 deg C

**Inclined Bubble Aeration Ditch - Tapered Ends**

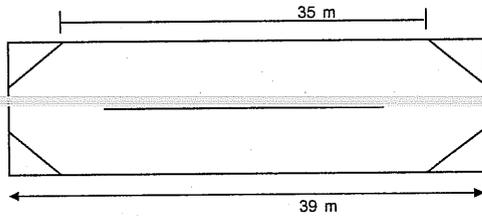

|                              |                               |
|------------------------------|-------------------------------|
| Area taken by corner baffles | 8 m <sup>2</sup>              |
| total length required        | 38.0 m                        |
| actual total tank length     | 39.1 m                        |
| Actual Volume                | 2690 m <sup>3</sup> per ditch |
|                              | 10760 m <sup>3</sup> total    |

**DGHemmings:**  
Includes 20% extra load

**Actual F/M Ratio**

|                  | kg/m3 | Average 2005 |      | Max Year 2025 |      | Max Year 2025 |      |
|------------------|-------|--------------|------|---------------|------|---------------|------|
|                  |       | Max          | Min  | Max           | Min  | Max           | Min  |
| MLSS in ASP      |       | 3.0          | 3.0  | 3.5           | 3.5  | 3.5           | 3.5  |
| Actual F/M Ratio |       | 0.18         | 0.17 | 0.25          | 0.23 | 0.29          | 0.27 |
| SRT              | d     | 8            | 8    | 5             | 6    | 5             | 5    |
| SRT              | d     | 8            | 8    | 5             | 6    | 5             | 5    |

SRT = Vol x MLSS/sludge prod  
SRT = 1/(yield x F:M)

**Operation With One Tank Out Of Service**

|                  |       |      |      |      |      |      |      |
|------------------|-------|------|------|------|------|------|------|
| MLSS in ASP      | kg/m3 | 3.0  | 3.0  | 4.0  | 4.0  | 4.8  | 4.8  |
| Actual F/M Ratio |       | 0.24 | 0.22 | 0.29 | 0.27 | 0.29 | 0.27 |
| SRT              | d     | 6    | 6    | 5    | 5    | 5    | 5    |
| SRT              | d     | 6    | 6    | 5    | 5    | 5    | 5    |

SRT = Vol x MLSS/sludge prod  
SRT = 1/(yield x F:M)

assumes all FST's will be in service when one activated sludge lane is taken out of service.

For inspection purposes only. Not for any other use.  
Consent of copyright owner required for any other use.



# PURAC

## Sludge Production in Conventional Aeration Plants

### Project-Specific Data

|   |  |                                     |        |                   |               |
|---|--|-------------------------------------|--------|-------------------|---------------|
| Standard Process Calculation: Project-specific data input is permitted to highlighted areas only. |  |                                     |        | Document Ref      | 8407          |
| Calc Ref:   |  | Rev                                 | Page 1 | Project No        | C1197         |
| Author  |  | Refer to PCS index for full details |        | Project Name      | Waterford STW |
| Calculation status:   |  | <b>CHECKED</b>                      |        | Process area code |               |
|   |  |                                     |        | Tag No(s)         | TBC           |
|   |  |                                     |        | Process Engineer  | D. Hemmings   |
|   |  |                                     |        | Date              | 01/11/2006    |

### Application

Provides guidance in the calculation of the quantity of WAS produced for conventional aeration plants which utilise primary tanks.

### Introduction

The calculation below can be used for a well settled sewage treating domestic sewage.

### Sludge Load Produced (Average) 2005.

|                            |           |      |                                   |
|----------------------------|-----------|------|-----------------------------------|
| BOD in settled sewage feed | kg/d      | 5353 | From 8404 Activated Sludge Design |
| SS in settled sewage feed  | kg/d      | 2212 | From 8404 Activated Sludge Design |
| Temperature of sewage      | degrees C | 10   | Ref: Vol 4 section 7.7.1          |
| F/M Ratio                  |           | 0.17 | From 8404 Activated Sludge Design |

|                       |            |      |      |      |      |                      |
|-----------------------|------------|------|------|------|------|----------------------|
| Temperature of sewage | degrees C  | 8    | 10   | 12   | 20   | note: 0.75 in tender |
| Yield Coefficient     | kgTS/kgBOD | 0.91 | 0.75 | 0.72 | 0.46 |                      |
| Sludge Production     | kgDS/d     | 4883 | 4015 | 3852 | 2466 |                      |
|                       | tDS/yr     | 1782 | 1465 | 1406 | 900  |                      |

|                   |                   |             |      |      |      |
|-------------------|-------------------|-------------|------|------|------|
| Sludge Dry Solids | %                 | Temperature | 0.4  | 0.5  | 0.6  |
| Sludge Density    | kg/m <sup>3</sup> |             | 1001 | 1001 | 1002 |
| Sludge Volume     | m <sup>3</sup> /d | 8           | 1219 | 975  | 813  |
|                   |                   | 10          | 1003 | 802  | 668  |
|                   |                   | 12          | 962  | 769  | 641  |
|                   |                   | 20          | 616  | 492  | 410  |

**Sludge Load Produced (Average) 2025**

|                            |           |      |                                   |
|----------------------------|-----------|------|-----------------------------------|
| BOD in settled sewage feed | kg/d      | 8730 | From 8404 Activated Sludge Design |
| SS in settled sewage feed  | kg/d      | 3693 | From 8404 Activated Sludge Design |
| Temperature of sewage      | degrees C | 10   | Vol 4 section 7.7.1               |
| F/M Ratio                  |           | 0.23 | From 8404 Activated Sludge Design |

|                       |            |      |      |      |      |
|-----------------------|------------|------|------|------|------|
| Temperature of sewage | degrees C  | 8    | 10   | 12   | 20   |
| Yield Coefficient     | kgTS/kgBOD | 0.98 | 0.75 | 0.77 | 0.49 |
| Sludge Production     | kgDS/d     | 8557 | 6547 | 6735 | 4285 |
|                       | tDS/yr     | 3123 | 2390 | 2458 | 1564 |

note: 0.75 in tender

|                   |       |             |      |      |      |
|-------------------|-------|-------------|------|------|------|
| Sludge Dry Solids | %     | Temperature | 0.4  | 0.5  | 0.6  |
| Sludge Density    | kg/m3 |             | 1001 | 1001 | 1002 |
| Sludge Volume     | m3/d  | 8           | 2137 | 1709 | 1424 |
|                   |       | 10          | 1635 | 1308 | 1089 |
|                   |       | 12          | 1682 | 1345 | 1121 |
|                   |       | 20          | 1070 | 856  | 713  |

**Sludge Load Produced (Maximum 20% extra) 2025**

**dghemmings:**  
Only 30% BOD removal across PST

|                            |           |       |                                   |
|----------------------------|-----------|-------|-----------------------------------|
| BOD in settled sewage feed | kg/d      | 10331 | From 8404 Activated Sludge Design |
| SS in settled sewage feed  | kg/d      | 4875  | From 8404 Activated Sludge Design |
| Temperature of sewage      | degrees C | 10    | Vol 4 section 7.7.1               |
| F/M Ratio                  |           | 0.27  | From 8404 Activated Sludge Design |

|                       |            |       |      |      |      |
|-----------------------|------------|-------|------|------|------|
| Temperature of sewage | degrees C  | 8     | 10   | 15   | 20   |
| Yield Coefficient     | kgTS/kgBOD | 1.02  | 0.75 | 0.67 | 0.51 |
| Sludge Production     | kgDS/d     | 10502 | 7748 | 6930 | 5237 |
|                       | tDS/yr     | 3833  | 2828 | 2529 | 1912 |

note: 0.75 in tender

|                   |       |             |      |      |      |
|-------------------|-------|-------------|------|------|------|
| Sludge Dry Solids | %     | Temperature | 0.4  | 0.5  | 0.6  |
| Sludge Density    | kg/m3 |             | 1001 | 1001 | 1002 |
| Sludge Volume     | m3/d  | 8           | 2622 | 2097 | 1747 |
|                   |       | 10          | 1935 | 1547 | 1289 |
|                   |       | 12          | 1730 | 1384 | 1153 |
|                   |       | 20          | 1308 | 1046 | 871  |

Consent of copyright owner is required for any other use.

|   |  |   |   |                       |            |
|---|--|---|---|-----------------------|------------|
| <b>PURAC</b>  |  |   |   | Project-Specific Data |            |
| IBA Design: SAS Pumps   |  |   |   | Document Ref          | 8407       |
| Standard Process Calculation: Project-specific data input is permitted to highlighted areas only. |  |   |   | Project No            | C1197      |
| Calc Ref:   |  |   |   | Project Name          | Waterford  |
|   |  | Rev   | 0 | Process area code     |            |
| Author  |  | D Garnett Refer to PCS index for full details |   | Tag No(s)             |            |
| Calculation status:   |  | UNCHECKED                                     |   | Process Engineer      | D Hemmings |
|   |  |   |   | Date                  | 01-Nov-06  |

### APPLICATION

Provides guidance in the calculation of the sludge pump capacity required for SAS desludging.

### INTRODUCTION

SAS sludge pumps are normally run on a timer basis.

The calculation below allows an estimate of the sludge pump capacity

### INPUTS

|                         |         | Average | Maximum |
|-------------------------|---------|---------|---------|
| SS Load                 | kg/d    | 6547    | 7748    |
| No. duty pumps per tank |         | 1       |         |
| Pump run time           | mins/hr | 60      |         |

### AVERAGE SLUDGE QUANTITY REMOVED

|                    |                   | 0.6  | 0.6  | 0.7  | 0.8  |
|--------------------|-------------------|------|------|------|------|
| Dry Solids Content | %                 | 0.6  | 0.6  | 0.7  | 0.8  |
| Sludge Density     | kg/m <sup>3</sup> | 1002 | 1002 | 1002 | 1002 |
| Sludge Removed     | kgDS/d            | 6547 | 6547 | 6547 | 6547 |
|                    | m <sup>3</sup> /d | 1089 | 1089 | 933  | 817  |

### SLUDGE PUMP DUTY

Feeding 1 GBT thickener 20 h day 7 d/wk (ref: 8409 Secondary Sludge Thickener)

|                        |                   | 20 | 20 | 20 | 20 |
|------------------------|-------------------|----|----|----|----|
| Hours operated per day | hr/d              | 20 | 20 | 20 | 20 |
| Duty GBT               |                   | 1  | 1  | 1  | 1  |
| Pump flowrate required | m <sup>3</sup> /h | 54 | 54 | 47 | 41 |
| Selected Flowrate      | m <sup>3</sup> /h | 60 |    |    |    |
| Actual run time        | mins/hr           | 54 | 54 | 47 | 41 |

per duty pump.

### MAXIMUM SLUDGE QUANTITY REMOVED

Feeding 2 GBT thickener 12.6 h day 7 d/wk (ref: 8409 Secondary Sludge Thickener)

|                        |                   | 0.6  | 0.6  | 0.7  | 0.8  |
|------------------------|-------------------|------|------|------|------|
| Dry Solids Content     | %                 | 0.6  | 0.6  | 0.7  | 0.8  |
| Sludge Density         | kg/m <sup>3</sup> | 1002 | 1002 | 1002 | 1002 |
| Sludge Removed         | kgDS/d            | 7748 | 7748 | 7748 | 7748 |
|                        | m <sup>3</sup> /d | 1289 | 1289 | 1105 | 966  |
| Hours operated per day | hr/d              | 12.6 | 12.6 | 12.6 | 12.6 |
| Duty GBT               |                   | 2    | 2    | 2    | 2    |
| Time to remove sludge  | mins/hr           | 51   | 51   | 44   | 38   |

|               |       |                   |
|---------------|-------|-------------------|
| Pipe diameter | 0.15  | m                 |
| CSA           | 0.018 | m <sup>2</sup>    |
| Pump Flowrate | 60    | m <sup>3</sup> /h |
| Velocity      | 0.943 | m/s               |



## 1. SCOPE

To calculate the WRc thickener size for the Waterford WwTW.

## 2. SUMMARY

|                          |                   |
|--------------------------|-------------------|
| No. of WRc thickeners =  | 1                 |
| WRc thickener diameter = | 8.700 m           |
| Total depth =            | 4.000 m           |
| Supernatant depth =      | 0.660 m           |
| Launder width =          | 0.870 m           |
| Launder TWL =            | 0.109 m below O/F |

## 3. REFERENCES

01. Ref 1 for wastewater is Guidelines for design and operation of sewage sludge consolidation tanks WRc 1994

Design the picket fence thickener to operate in continuous mode on primary sludge only.  
 Assume that the primary tanks will be provided with an auto desludging system, which will operate on a semi-continuous basis for 24 hours per day, 7 days per week.  
 Auto desludge regime is 24 desludges per day per PST (2 PSTs). 20 minutes per desludge.  
 Therefore desludging for 20 min x 24 x 2 = 16 hours per day.

## 4. CALCULATION

### 4.1. Design Basis

#### 4.1.1. Sludge Production

|                        | Min.    | Avg.    | Max.    |   |
|------------------------|---------|---------|---------|---|
| Sludge production =    | 3041.94 | 5077.79 | 6500.05 | kg d <sup>-1</sup> From 8404-Activated Sludge |
| =                      | 126.7   | 211.6   | 270.8   | kg m <sup>-3</sup>                            |
| Primary tank removal = | 55.0    | 55.0    | 80.0    | % Assumed                                     |
| Solids concentration = | 3.0%    | 3.0%    | 3.0%    | by wt Assumed                                 |
| Sludge density =       | 1008.6  | 1008.6  | 1008.6  | kg m <sup>-3</sup>                            |
| Sludge =               | 4.19    | 6.99    | 8.95    | m <sup>3</sup> h <sup>-1</sup>                |

#### 4.1.2. Thickener Design

|                             | Min. | Avg. | Max. |
|-----------------------------|------|------|------|
| No. of duty thickeners =    | 1    | 1    | 1    |
| No. of standby thickeners = | 0    | 0    | 0    |

|                               |   |
|-------------------------------|---|
| Max. hydraulic loading rate = | 0.5 m <sup>3</sup> m <sup>-2</sup> h <sup>-1</sup> ... [Ref. 01]      |
| Max. solids loading rate =    | 4.6 kg m <sup>-2</sup> h <sup>-1</sup> ... Ref: Vol 4 section 7.9.1   |
|                               | 110.0 kg m <sup>-2</sup> d <sup>-1</sup> ... Ref: Vol 4 section 7.9.1 |

### 4.2. WRc Thickener

#### 4.2.1. Thickener Feed Rate

|  | Min.   | Avg.   | Max.   |   |
|--|--------|--------|--------|---|
| Days operation =                             | 7.0    | 7.0    | 7.0    | d week <sup>-1</sup>  |
| Hours operation =                            | 24.0   | 24.0   | 24.0   | h d <sup>-1</sup>   |
| No. of duty units =                          | 1      | 1      | 1      |   |
| Thickener unit feed flow =                   | 4.19   | 6.99   | 8.95   | m <sup>3</sup> h <sup>-1</sup>                                    |
| Solids concentration =                       | 3.0%   | 3.0%   | 3.0%   | by wt   |
| Sludge density =                             | 1008.6 | 1008.6 | 1008.6 | kg m <sup>-3</sup>  |
| Thickener block feed solids =                | 126.7  | 211.6  | 270.8  | kg h <sup>-1</sup>  |
| Maximum allowable thickener unit feed flow = | 29.72  | 29.72  | 29.72  | m <sup>3</sup> h <sup>-1</sup>                                    |
|  |        |        | 29.00  | m <sup>3</sup> h <sup>-1</sup> Chosen max instantaneous pump rate |

## 4.2.2. Thickened Solids

|                           | Min.   | Avg.   | Max.   |                                |                                    |
|---------------------------|--------|--------|--------|--------------------------------|------------------------------------|
| Thickener recovery =      | 99.5%  | 99.5%  | 99.5%  | by wt of inlet solids          | Assumed                            |
| Cake solids =             | 126.1  | 210.5  | 269.5  | kg h <sup>-1</sup>             |                                    |
| Solids concentration =    | 6.0%   | 6.0%   | 6.0%   | by wt                          | Ref: Vol 4 section 7.9.1           |
| Sludge density =          | 1017.4 | 1017.4 | 1017.4 | kg m <sup>-3</sup>             |                                    |
| Thickened sludge volume = | 2.07   | 3.45   | 4.41   | m <sup>3</sup> h <sup>-1</sup> |                                    |
|                           |        |        | 29.00  | m <sup>3</sup> h <sup>-1</sup> | Chosen max instantaneous pump rate |

## 4.2.3. Thickener Filtrate

|                                 | Min.   | Avg.   | Max.   |                                |  |
|---------------------------------|--------|--------|--------|--------------------------------|--|
| Filtrate solids =               | 0.6    | 1.1    | 1.4    | kg h <sup>-1</sup>             |  |
| Approx. centrate density =      | 1000.0 | 1000.0 | 1000.0 | kg m <sup>-3</sup>             | Assumed  |
| Average Filtrate flow =         | 2.12   | 3.54   | 4.54   | m <sup>3</sup> h <sup>-1</sup> |  |
|                                 |        |        | 29.00  | m <sup>3</sup> h <sup>-1</sup> | Max instantaneous discharge rate                     |
| Filtrate solids concentration = | 0.30   | 0.30   | 0.30   | kg m <sup>-3</sup>             |  |
| ≡                               | 299    | 299    | 299    | mg L <sup>-1</sup>             | WRC guidelines for sewage sludge consolidation tanks |
| Solids concentration =          | 0.03%  | 0.03%  | 0.03%  | by wt                          | 140 mg/l   |
| Load =                          | 15.2   | 25.4   | 32.5   | kg/d                           |  |

## 4.2.4. Thickened Sludge Storage (Emergency)

|                         | Min.   | Avg.   | Max.   |                   |  |
|-------------------------|--------|--------|--------|-------------------|--|
| Days operation =        | 3.0    | 3.0    | 3.0    | d                 | Ref: Vol 4 section 7.9.3 storage of 3 days |
| Hours production =      | 24.0   | 24.0   | 24.0   | h d <sup>-1</sup> | production of thickened primary sludge     |
| No. of duty tanks =     | 1      | 1      | 1      |                   |  |
| Sludge storage volume = | 148.74 | 248.29 | 317.83 | m <sup>3</sup>    |  |

## 4.2.5. Thickener Diameter

|                       | Min.  | Avg.  | Max.  |  |
|-----------------------|-------|-------|-------|--|
| Hydraulic load =      | 4.2   | 7.0   | 29.0  | m <sup>3</sup> h <sup>-1</sup>                         |
| Solids load =         | 126.7 | 211.6 | 270.8 | kg h <sup>-1</sup>                                     |
| No. of thickeners =   | 1     | 1     | 1     |  |
| Unit hydraulic load = | 4.2   | 7.0   | 29.0  | m <sup>3</sup> h <sup>-1</sup> thickener <sup>-1</sup> |
| Unit solids load =    | 126.7 | 211.6 | 270.8 | kg h <sup>-1</sup> thickener <sup>-1</sup>             |
| Hydraulic diameter =  | 3.266 | 4.220 | 8.593 | m  |
| Solids diameter =     | 5.934 | 7.666 | 8.674 | m  |

Thickener is Solids limited  
Diameter selected = 8.700 m

Diameter selected from Permafrost Range = 8.530 m

## 4.2.6. Depths

|                     |       |   |   |
|---------------------|-------|---|---|
| Total depth =       | 4.000 | m | Ref: Vol 4 section 7.9.1; Needs to be at least 4m process depth |
| Supernatant depth = | 0.660 | m | ... Ref. 01   |

## 4.2.7. Launder

|                 |       |                       |             |
|-----------------|-------|-----------------------|-------------|
| Launder width = | 0.870 | m                     | ... Ref. 01 |
| Liquid depth =  | 0.109 | m below thickener O/F | ... Ref. 01 |

## 4.2.8. Sludge Retention

|   |         |                |                                       |
|---|---------|----------------|---------------------------------------|
| Chosen capacity =                       | 237.000 | m <sup>3</sup> |                                       |
| Sludge volume =                         | 190.869 | m <sup>3</sup> |                                       |
| Sludge depth =                          | 3.340   | m              |                                       |
| Hydraulic retention @ max sludge flow = | 1.802   | d              | Ref: Vol 4 section 7.9.1; minimum 1 d |

**PERMASTORE STANDARD DIMENSIONS FOR A PICKET FENCE THICKENER**

| Model Reference (Height) |                 |                           |                 | 5                                  | 10    | 15    | 20    | 25    | 30    | 35    | 40     | 45     | 50     |
|--------------------------|-----------------|---------------------------|-----------------|------------------------------------|-------|-------|-------|-------|-------|-------|--------|--------|--------|
| Actual Height (m)        |                 |                           |                 | 1.47                               | 2.867 | 4.264 | 5.661 | 7.058 | 8.455 | 9.852 | 11.249 | 12.846 | 14.043 |
| Number of rings          |                 |                           |                 | 1                                  | 2     | 3     | 4     | 5     | 6     | 7     | 8      | 9      | 10     |
| Model Ref                | Actual Diameter | Floor Area m <sup>2</sup> | Sheets Per Ring | NOMINAL CAPACITY (m <sup>3</sup> ) |       |       |       |       |       |       |        |        |        |
| 8                        | 2.56            | 5.14                      | 3               | 7                                  | 14    | 21    | 28    | 36    | 43    | 50    | 57     | 64     | 72     |
| 11                       | 3.41            | 9.14                      | 4               | 12                                 | 25    | 38    | 51    | 63    | 76    | 89    | 102    | 115    | 127    |
| 14                       | 4.27            | 14.29                     | 5               | 19                                 | 39    | 59    | 79    | 99    | 119   | 139   | 159    | 179    | 199    |
| 17                       | 5.12            | 20.58                     | 6               | 28                                 | 56    | 85    | 114   | 143   | 171   | 200   | 229    | 258    | 286    |
| 20                       | 5.97            | 28.01                     | 7               | 38                                 | 77    | 116   | 155   | 194   | 233   | 272   | 312    | 351    | 390    |
| 22                       | 6.82            | 36.58                     | 8               | 49                                 | 100   | 151   | 203   | 254   | 305   | 356   | 407    | 458    | 509    |
| 25                       | 7.68            | 46.3                      | 9               | 62                                 | 127   | 192   | 256   | 321   | 386   | 450   | 515    | 580    | 644    |
| 28                       | 8.53            | 57.16                     | 10              | 77                                 | 157   | 237   | 316   | 396   | 476   | 556   | 636    | 716    | 795    |
| 30                       | 9.38            | 69.16                     | 11              | 93                                 | 190   | 286   | 383   | 479   | 576   | 673   | 769    | 866    | 963    |
| 33                       | 10.24           | 82.3                      | 12              | 111                                | 226   | 341   | 456   | 571   | 686   | 801   | 916    | 1031   | 1146   |
| 36                       | 11.09           | 96.59                     | 13              | 130                                | 265   | 400   | 535   | 670   | 805   | 940   | 1075   | 1209   | 1344   |
| 39                       | 11.94           | 112.03                    | 14              | 151                                | 307   | 464   | 620   | 777   | 933   | 1090  | 1246   | 1403   | 1559   |
| 42                       | 12.8            | 128.6                     | 15              | 173                                | 353   | 532   | 712   | 892   | 1071  | 1251  | 1431   | 1610   | 1790   |
| 45                       | 13.65           | 146.32                    | 16              | 197                                | 401   | 606   | 810   | 1014  | 1219  | 1423  | 1628   | 1832   | 2036   |
| 47                       | 14.5            | 185.18                    | 17              | 222                                | 453   | 684   | 914   | 1145  | 1376  | 1607  | 1837   | 2068   | 2299   |
| 50                       | 15.36           | 185.18                    | 18              | 249                                | 508   | 766   | 1025  | 1284  | 1543  | 1801  | 2060   | 2319   |        |
| 53                       | 16.21           | 206.33                    | 19              | 278                                | 566   | 854   | 1142  | 1431  | 1719  | 2007  | 2295   | 2583   |        |
| 56                       | 17.06           | 228.62                    | 20              | 307                                | 627   | 946   | 1266  | 1585  | 1904  | 2224  | 2543   |        |        |
| 59                       | 17.91           | 252.06                    | 21              | 339                                | 691   | 1043  | 1395  | 1748  | 2100  | 2452  | 2804   |        |        |
| 62                       | 18.77           | 276.63                    | 22              | 372                                | 759   | 1145  | 1531  | 1918  | 2304  | 2691  | 3077   |        |        |
| 64                       | 19.62           | 302.35                    | 23              | 407                                | 829   | 1251  | 1674  | 2096  | 2519  | 2941  | 3363   |        |        |
| 67                       | 20.47           | 329.22                    | 24              | 443                                | 903   | 1363  | 1823  | 2282  | 2742  | 3202  | 3662   |        |        |
| 70                       | 21.33           | 357.22                    | 25              | 480                                | 980   | 1479  | 1976  | 2477  | 2976  | 3475  | 3974   |        |        |
| 73                       | 22.18           | 386.37                    | 26              | 520                                | 1059  | 1599  | 2139  | 2679  | 3218  | 3758  |        |        |        |
| 76                       | 23.03           | 416.67                    | 27              | 560                                | 1142  | 1725  | 2307  | 2889  | 3471  | 4053  |        |        |        |
| 78                       | 23.89           | 448.1                     | 28              | 603                                | 1229  | 1855  | 2481  | 3107  | 3733  | 4359  |        |        |        |
| 81                       | 24.74           | 480.68                    | 29              | 647                                | 1318  | 1990  | 2661  | 3333  | 4004  | 4676  |        |        |        |
| 84                       | 25.59           | 514.4                     | 30              | 692                                | 1410  | 2129  | 2848  | 3566  | 4285  |       |        |        |        |
| 86                       | 26.45           | 549.27                    | 31              | 739                                | 1506  | 2273  | 3041  | 3808  | 4575  |       |        |        |        |
| 89                       | 27.3            | 585.27                    | 32              | 787                                | 1605  | 2422  | 3240  | 4058  | 4875  |       |        |        |        |
| 92                       | 28.15           | 622.43                    | 33              | 837                                | 1707  | 2576  | 3446  | 4315  | 5185  |       |        |        |        |
| 95                       | 29              | 680.72                    | 34              | 889                                | 1812  | 2735  | 3658  | 4581  | 5504  |       |        |        |        |
| 98                       | 29.88           | 700.16                    | 35              | 942                                | 1920  | 2898  | 3876  | 4854  | 5832  |       |        |        |        |
| 101                      | 30.71           | 740.74                    | 36              | 996                                | 2031  | 3066  | 4101  | 5136  |       |       |        |        |        |
| 103                      | 31.56           | 782.46                    | 37              | 1052                               | 2146  | 3239  | 4332  | 5425  |       |       |        |        |        |
| 106                      | 32.42           | 825.33                    | 38              | 1110                               | 2263  | 3416  | 4589  | 5722  |       |       |        |        |        |
| 109                      | 33.27           | 869.34                    | 39              | 1169                               | 2384  | 3598  | 4813  | 6027  |       |       |        |        |        |
| 112                      | 34.12           | 914.49                    | 40              | 1230                               | 2508  | 3785  | 5063  | 6340  |       |       |        |        |        |
| 115                      | 34.98           | 960.79                    | 41              | 1292                               | 2634  | 3977  | 5319  | 6661  |       |       |        |        |        |
| 118                      | 35.83           | 1008.23                   | 42              | 1356                               | 2765  | 4173  | 5582  | 6990  |       |       |        |        |        |
| 120                      | 36.68           | 1056.81                   | 43              | 1421                               | 2898  | 4374  | 5850  | 7327  |       |       |        |        |        |
| 123                      | 37.54           | 1106.53                   | 44              | 1488                               | 3034  | 4580  | 6126  | 7672  |       |       |        |        |        |
| 126                      | 38.39           | 1157.4                    | 45              | 1557                               | 3174  | 4790  | 6407  |       |       |       |        |        |        |
| 129                      | 39.24           | 1209.42                   | 46              | 1627                               | 3316  | 5005  | 6695  |       |       |       |        |        |        |
| 131                      | 40.09           | 1262.57                   | 47              | 1698                               | 3462  | 5226  | 6990  |       |       |       |        |        |        |
| 134                      | 40.95           | 1316.87                   | 48              | 1771                               | 3611  | 5451  | 7290  |       |       |       |        |        |        |
| 137                      | 41.8            | 1372.31                   | 49              | 1848                               | 3763  | 5680  | 7597  |       |       |       |        |        |        |
| 140                      | 42.65           | 1428.89                   | 50              | 1922                               | 3918  | 5914  | 7910  |       |       |       |        |        |        |
| 143                      | 43.51           | 1486.62                   | 51              | 2000                               | 4076  | 6153  | 8230  |       |       |       |        |        |        |
| 145                      | 44.38           | 1545.49                   | 52              | 2079                               | 4238  | 6397  | 8556  |       |       |       |        |        |        |
| 148                      | 45.21           | 1605.5                    | 53              | 2159                               | 4402  | 6645  | 8888  |       |       |       |        |        |        |



## 1. SCOPE

To calculate the thickener duties for the Waterford WwTW

## 2. SUMMARY

### 2.1. Scheme [Thickeners]

|                           | Min.  | Avg.  | Max.  |  |
|---------------------------|-------|-------|-------|--|
| No. of duty units =       | 1     | 1     | 2     |  |
| Thickener feed flow =     | 40.09 | 54.47 | 55.00 | m <sup>3</sup> h <sup>-1</sup> per machine |
| Thickener feed solids =   | 0.5%  | 0.6%  | 0.6%  | by wt                                      |
| ≡                         | 200.7 | 327.4 | 330.6 | kg h <sup>-1</sup> per machine             |
| Thickened solids =        | 5.0%  | 5.0%  | 5.0%  | by wt                                      |
| Filtrate solids consent = | 441   | 540   | 540   | mg L <sup>-1</sup>                         |

## 3. REFERENCES

### 3.1. Duty [From AS Plant]

#### 3.1.1. SAS Sludge Feed

|                        | Min.    | Avg.    | Max.    |                                |
|------------------------|---------|---------|---------|--------------------------------|
| Sludge production =    | 4014.89 | 6547.43 | 7748.24 | kg d <sup>-1</sup>             |
| ≡                      | 167.3   | 272.8   | 322.8   | kg h <sup>-1</sup>             |
| Solids concentration = | 0.5%    | 0.6%    | 0.6%    | by wt                          |
| Sludge density =       | 1001.7  | 1001.7  | 1001.7  | kg m <sup>-3</sup>             |
| Sludge =               | 38.41   | 45.39   | 53.72   | m <sup>3</sup> h <sup>-1</sup> |

**DGHemmings:**  
Includes 20% extra load at  
only 30%BOD removal  
across PST

#### 3.1.2. SAS Buffer Tank

|                         | Min. | Avg. | Max. |                   |
|-------------------------|------|------|------|-------------------|
| Days operation =        | 1.0  | 1.0  | 1.0  | d                 |
| Hours production =      | 0.0  | 0.0  | 0.0  | h d <sup>-1</sup> |
| No. of duty tanks =     | 1    | 1    | 1    |                   |
| Sludge storage volume = | 0.00 | 0.00 | 0.00 | m <sup>3</sup>    |

**3.1.2. Thickener Feed Rate**

|                               | Min.   | Avg.   | Max.   |   |
|-------------------------------|--------|--------|--------|---|
| Days operation =              | 7.0    | 7.0    | 7.0    | d week <sup>-1</sup>  |
| Hours operation =             | 20.0   | 20.0   | 11.7   | h d <sup>-1</sup> Vol 4 section 7.9.7 treat average sludge load in < 20 hours |
| No. of duty units =           | 1      | 1      | 2      |   |
| Thickener unit feed flow =    | 40.09  | 54.47  | 55.00  | m <sup>3</sup> h <sup>-1</sup>  |
| Solids concentration =        | 0.5%   | 0.6%   | 0.6%   | by wt   |
| Sludge density =              | 1001.4 | 1001.7 | 1001.7 | kg m <sup>-3</sup>  |
| Thickener block feed solids = | 200.7  | 327.4  | 330.6  | kg h <sup>-1</sup> per machine  |

**3.1.3. Thickened Solids**

|                           | Min.   | Avg.   | Max.   |  |
|---------------------------|--------|--------|--------|--|
| Thickener recovery =      | 92.0%  | 92.0%  | 92.0%  | by wt of inlet solids                      |
| Cake solids =             | 184.7  | 301.2  | 304.1  | kg h <sup>-1</sup> per machine             |
| Solids concentration =    | 5.0%   | 5.0%   | 5.0%   | by wt                                      |
| Sludge density =          | 1014.5 | 1014.5 | 1014.5 | kg m <sup>-3</sup>                         |
| Thickened sludge volume = | 3.64   | 5.94   | 6.00   | m <sup>3</sup> h <sup>-1</sup> per machine |

**3.1.4. Thickener Filtrate**

|                                      | Min.   | Avg.   | Max.   |   |
|--------------------------------------|--------|--------|--------|---|
| Filtrate solids =                    | 16.1   | 26.2   | 26.4   | kg h <sup>-1</sup>  |
| Approx. centrate density =           | 1000.0 | 1000.0 | 1000.0 | kg m <sup>-3</sup>  |
| Filtrate flow =                      | 36.46  | 48.54  | 49.01  | m <sup>3</sup> h <sup>-1</sup> per machine                    |
| Filtrate solids concentration =      | 0.44   | 0.54   | 0.54   | kg m <sup>-3</sup>  |
| ≡                                    | 441    | 540    | 540    | mg L <sup>-1</sup>  |
| Solids concentration =               | 0.04%  | 0.05%  | 0.05%  | by wt   |
| Return Load =                        | 321.2  | 523.8  | 619.9  | kg/d  |
| Wash water and make-up consumption = | 6.5    | 6.5    | 6.5    | m <sup>3</sup> h <sup>-1</sup> Sernagiotto Literature (1200N) |
| Total filtrate return =              | 43.0   | 55.0   | 11.0   | m <sup>3</sup> h <sup>-1</sup>                                |

**3.1.5. Thickened Filter Sludge Storage**

|                         | Min.   | Avg.   | Max.   |  |
|-------------------------|--------|--------|--------|--|
| Days operation =        | 3.0    | 3.0    | 3.0    | d Vol 4 section 7.9.3 storage of 3 days                    |
| Hours production =      | 20.0   | 20.0   | 11.7   | h d <sup>-1</sup> production of thickened secondary sludge |
| No. of duty tanks =     | 1      | 1      | 1      |  |
| Sludge storage volume = | 218.46 | 356.26 | 421.59 | m <sup>3</sup>   |



**DESIGN BASIS FOR WATERFORD STW****1. Indigenous sludge production**

Yearly sludge production 0 tDS/year  
0 kgDS/day

|                            |      |      |      |   |
|----------------------------|------|------|------|---|
| Primary sludge thickness   | 6    | 6    | 6    | %DS by means of new Picket Fence Thickeners (EPS) |
| Density                    | 1017 | 1017 | 1017 | kg/m3   |
| Secondary sludge thickness | 5    | 5    | 5    | %DS by means of a new SAS thickener (EPS)         |
| Density                    | 1014 | 1014 | 1014 | kg/m3   |

|                             | Minimum | Average | Maximum |          |                                       |
|-----------------------------|---------|---------|---------|----------|---------------------------------------|
| Primary sludge production   | 3041    | 5078    | 6499    | kgDS/day | From 8408 Primary Sludge Thickening   |
| Primary sludge volume       | 50      | 83      | 106     | m3/day   |                                       |
| Secondary sludge production | 3694    | 6024    | 7116    | kgDS/day | From 8409 Secondary Sludge Thickening |
| Secondary sludge volume     | 73      | 119     | 140     | m3/day   |                                       |

|                                    |       |       |       |        |
|------------------------------------|-------|-------|-------|--------|
| Total indigenous sludge volume     | 122.6 | 201.9 | 246.7 | m3/day |
| Percentage dry solids of the blend | 5.4   | 5.4   | 5.5   | %DS    |

**2. Imported sludge**

Type of imported sludge Unknown

In the future, the sludge will be imported in consolidation tanks prior to digestion. Imported sludge will not be thickened.

|                              | Minimum | Average | Maximum |          |
|------------------------------|---------|---------|---------|----------|
| Yearly import                | 0       | 0       | 0       | tDS/year |
| Import 5 days a week         | 0       | 0       | 0       | kgDS/day |
| Thickness of imported sludge | 3.0     | 3.0     | 3.0     | %DS      |
| Density                      | 1009    | 1009    | 1009    | kg/m3    |
| Volume                       | 0.0     | 0.0     | 0.0     | m3/day   |

**3. Total sludge throughput****PASTEURISATION PLANT DESIGN BASIS**

|                             | Minimum                   | Average | Maximum |          |
|-----------------------------|---------------------------|---------|---------|----------|
| Total sludge production     | 0                         | 0       | 0       | tDS/year |
|                             | 6735                      | 11102   | 13615   | kgDS/day |
| Total volume                | 123                       | 202     | 247     | m3/day   |
| Total percentage dry solids | 5.41                      | 5.42    | 5.41    | %DS      |
|                             | Normally at maximum flow: |         | 5.44    | %DS      |

**4. Check retention time in the digesters**

|                   |      |      |                            |
|-------------------|------|------|----------------------------|
| No off digesters  | 2    |      |                            |
| Individual volume | 1721 | m3   | 8412 Digester design sheet |
| Volume            | 3442 | m3   |                            |
| Retention time    | 28.1 | 17.0 | 13.9                       |

**5. Biogas production**

Average gas production 3776 m3/day 8413 Gas production sheet

**PASTEURISATION PLANT DESIGN BASIS**

**Sludge Input criteria**

|   | Max          | Avg         | Min  |                                    |
|---|--------------|-------------|------|------------------------------------|
| Sludge Make                                       | 13615        | 11102       | 6735 | kg DS/d                            |
| Flowrate  | 10.3         | 8.4         | 5.1  | m3/h                               |
| Thickness   | 5.4%         | 5.4%        | 5.4% | % DS                               |
| Density   | 1016         | 1016        | 1016 | kg/m3                              |
| Viscosity at 10 degC<br>For an upper bound sludge | 35.12        | 23.32       | 14.6 | Nm2/s      CHECK WITH LOWESTOFT DE |
| Sludge Temp                                       | Summer<br>15 | Winter<br>5 |      | degrees C Assumed                  |

|                                   |       |         |
|-----------------------------------|-------|---------|
| Enter Installed Digester Capacity | 3442  | m3      |
| Specific Heat Capacity            | 4.186 | kJ/kg.K |

For the purpose of the heat requirement calculations, winter and summer conditions will be defined using maximum operational conditions (sludge throughput and %DS) for summer and minimal operational conditions for winter.

**Operational Requirements**

|                     |                |   |               |              |
|---------------------|----------------|---|---------------|--------------|
| Pasteurisation Temp | 55             | degrees (70 degrees min recommended)  |               |              |
| Pasteurisation Time | 240            | minutes as a minimum (35 minutes minimum recommended)   |               |              |
| Hrs of Operation    | 20             | hrs per day to make allowance for down time (22 hrs recommended)<br>Ref: Vol 4 section 7.9.5 (average daily load treated in 20 hours) |               |              |
| Range of flowrate   | 12.3           | 10.1  | 5.1           | m3/h         |
| Digestion Temp      | Option 1<br>35 | Mesophilic  | Option 2<br>- | Thermophilic |

**Digesters heat losses**

The design of the heat exchangers is based on the maximum and minimum sludge flows, i.e.

|      |        |     |       |
|------|--------|-----|-------|
| 15.0 | m3/hr. | 5.1 | m3/hr |
|------|--------|-----|-------|

See spreadsheet "Digester heat losses".  
*Note: This includes the heat losses in the pipelines.*

|             | Maximum flow |        | Minimum flow |        | kW |
|-------------|--------------|--------|--------------|--------|----|
|             | Summer       | Winter | Summer       | Winter |    |
| Heat losses | 95.4         | 206.1  | 47.7         | 103.1  |    |

The corresponding rise in temperature is:

$$\text{Temp (deg C)} = \frac{\text{Energy (kW)} \times 3600}{\text{Heat Capacity(kJ/kg.K)} \times \text{Flow (m3/hr)} \times \text{Density (kg/m3)}}$$

|                   |      |      |      |      |       |
|-------------------|------|------|------|------|-------|
| Temperature rise  | 6.5  | 14.1 | 7.9  | 17.1 | deg C |
| Final temperature | 41.5 | 49.1 | 42.9 | 52.1 | deg C |

**SIZING OF THE PASTEURISATION UNIT**

**Sludge Input criteria**

|   | Max   | Avg   | Min  |                        |
|---|-------|-------|------|------------------------|
| Sludge Make                                       | 13615 | 11102 | 6735 | kg DS/d                |
| Flowrate  | 10.3  | 8.4   | 5.1  | 15.0 m <sup>3</sup> /h |
| Thickness   | 5.4%  | 5.4%  | 5%   | % DS                   |
| Density   | 1016  | 1016  | 1016 | kg/m <sup>3</sup>      |
| Viscosity at 10 degC<br>For an upper bound sludge | 35.12 | 23.32 | 14.6 | Nm <sup>2</sup> /s     |

**Operational Requirements**

|                     |      |  |     |      |                   |   |
|---------------------|------|--|-----|------|-------------------|---|
| Pasteurisation Temp | 55   | degrees (70 degrees min recommended)                             |     |      |                   |   |
| Pasteurisation Time | 240  | min as a minimum (35 minutes minimum recommended)                |     |      |                   |   |
| Hrs of Operation    | 20   | hrs per day to make allowance for down time (22 hrs recommended) |     |      |                   |   |
| Actual Flowrate     | 12.3 | 10.1   | 5.1 | 15.0 | m <sup>3</sup> /h | Alfa Laval<br>Channel (0.018m x 0.25m)<br>SA = 0.0045 m <sup>2</sup><br>velocity = 0.925926 m/s |

**2 cycles per day option**

|                                   |       |                   |  |       |
|-----------------------------------|-------|-------------------|--|-------|
| Number of tanks                   | 3     |                   |  |       |
| Number of complete cycles per day | 2     |                   |  |       |
| Time of cycle                     | 720   | min               | Therefore number of tank empties per day | 6     |
|                                   | Max   |                   |  |       |
|                                   | 280   | min               |  |       |
| Duration of fill stage            | 240   | min               |  |       |
| Duration of pasteurise stage      | 200   | min               |  |       |
| Duration of empty stage           |       |                   | CHECK                                    |       |
|                                   |       |                   | Avg                                      | Min   |
| Volume of sludge                  | 41.1  | m <sup>3</sup>    | 33.7                                     | 20.4  |
| Discharge rate                    | 12.3  | m <sup>3</sup> /h |  |       |
| Fill time @ chosen tank size      | 164   | min               | 135                                      | 82    |
| Discharge rate @ chosen tank size | 15.0  | m <sup>3</sup> /h | 15.0                                     | 12.0  |
| Discharge time @ chosen tank size | 164.0 | min               | 134.6                                    | 102.2 |
| Total cycle time                  | 732.0 | min               | 643.9                                    | 485.3 |
| Volume of sludge discharged       | 246.0 | m <sup>3</sup> /d | 201.9                                    | 122.6 |
| Idle time                         | -12.0 | min               | 76.1                                     | 234.7 |

**Pasteurisation tank unit**

|  | Min    | Average | Max |                               |
|--|--------|---------|-----|-------------------------------|
| Volume of the bottom section   | 49.3   | 41.0    |     | m <sup>3</sup>                |
| Retention time   | 240    | 293     | 579 | 199 min                       |
| Time allowed for filling bottom section  | 0      | 0       |     | min                           |
| Real retention time  | 240    | 293     | 579 | 199 min                       |
| Internal diameter of the unit  | 3.5    | 3.5     |     | m                             |
| Wall thickness   | 0.005  | 0.005   |     | m                             |
| Lagging thickness  | 0.05   | 0.05    |     | m                             |
| External diameter of the unit  | 3.61   | 3.61    |     | m                             |
| Minimum sludge water depth in top tank<br>(Note: the sludge water depth is measured from the top of the truncated section of the upper tank) | 0.000  | 0.000   |     | mm N/A                        |
| Volume in the top tank   | 49.3   | 41.0    |     | m <sup>3</sup>                |
| Freeboard in top tank  | 0.500  | 0.500   |     | m                             |
| Minimum lagging under the tank   | 0.200  | 0.200   |     | m                             |
| Partition between top and bottom tanks   | 60     | 60      |     | degrees inc Chosen for sizing |
| Maximum height of the top tank   | 7.150  | 6.282   |     | m 6.250 m                     |
| Total height of the pasteurisation unit  | 7.850  | 6.982   |     | m 6.750 m                     |
| Sludge inlet pipe diameter   | 0.150  | 0.200   |     | m                             |
| Sludge inlet pipe level  | 11.47  | 9.73    |     | m                             |
| Sludge outlet pipe top section diameter  |        |         |     | m                             |
| Sludge outlet pipe top section level   | 10.509 | 8.773   |     | m                             |
| Sludge inlet pipe bottom section level   |        |         |     | m                             |
| Sludge outlet pipe diameter  | 0.150  | 0.150   |     | m                             |
| Sludge outlet pipe level   | 0.325  | 0.350   |     | m                             |

Note: level 0.00 is taken as being at the bottom of the pasteurisation tank, including the bottom insulation.  
The level of pipes is the level of the center section of the pipes.



## Surface areas

|   |                |        |        |        |        |
|---|----------------|--------|--------|--------|--------|
| Pasteuriser base  |                |        |        |        |        |
| Inner surface area                                      | m <sup>2</sup> | 33.501 | 33.501 | 33.501 | 33.501 |
| Outer surface area                                      | m <sup>2</sup> | 33.741 | 33.741 | 33.741 | 33.741 |
| Log mean surface area                                   | m <sup>2</sup> | 33.621 | 33.621 | 33.621 | 33.621 |
| Pasteuriser base insulation in contact with air         |                |        |        |        |        |
| Inner surface area                                      | m <sup>2</sup> | 33.741 | 33.741 | 33.741 | 33.741 |
| Outer surface area                                      | m <sup>2</sup> | 36.203 | 36.203 | 36.203 | 36.203 |
| Log mean surface area                                   | m <sup>2</sup> | 34.958 | 34.958 | 34.958 | 34.958 |
| Wetted Pasteuriser wall in contact with soil            |                |        |        |        |        |
| Inner surface area                                      | m <sup>2</sup> | 0.000  | 0.000  | 0.000  | 0.000  |
| Outer surface area                                      | m <sup>2</sup> | 0.000  | 0.000  | 0.000  | 0.000  |
| Log mean surface area                                   | m <sup>2</sup> | 0.000  | 0.000  | 0.000  | 0.000  |
| Wetted Pasteuriser wall insulation in contact with soil |                |        |        |        |        |
| Inner surface area                                      | m <sup>2</sup> | 0.000  | 0.000  | 0.000  | 0.000  |
| Outer surface area                                      | m <sup>2</sup> | 0.000  | 0.000  | 0.000  | 0.000  |
| Log mean surface area                                   | m <sup>2</sup> | 0.000  | 0.000  | 0.000  | 0.000  |
| Wetted Pasteuriser wall above ground level              |                |        |        |        |        |
| Inner surface area                                      | m <sup>2</sup> | 68.722 | 68.722 | 68.722 | 68.722 |
| Outer surface area                                      | m <sup>2</sup> | 68.919 | 68.919 | 68.919 | 68.919 |
| Log mean surface area                                   | m <sup>2</sup> | 68.820 | 68.820 | 68.820 | 68.820 |
| Wetted Pasteuriser wall insulation in contact with air  |                |        |        |        |        |
| Inner surface area                                      | m <sup>2</sup> | 68.919 | 68.919 | 68.919 | 68.919 |
| Outer surface area                                      | m <sup>2</sup> | 70.882 | 70.882 | 70.882 | 70.882 |
| Log mean surface area                                   | m <sup>2</sup> | 69.896 | 69.896 | 69.896 | 69.896 |
| Dry Pasteuriser wall above ground                       |                |        |        |        |        |
| Inner surface area                                      | m <sup>2</sup> | 5.498  | 5.498  | 5.498  | 5.498  |
| Outer surface area                                      | m <sup>2</sup> | 5.513  | 5.513  | 5.513  | 5.513  |
| Log mean surface area                                   | m <sup>2</sup> | 5.506  | 5.506  | 5.506  | 5.506  |
| Dry Pasteuriser wall insulation in contact with air     |                |        |        |        |        |
| Inner surface area                                      | m <sup>2</sup> | 5.513  | 5.513  | 5.513  | 5.513  |
| Outer surface area                                      | m <sup>2</sup> | 5.671  | 5.671  | 5.671  | 5.671  |
| Log mean surface area                                   | m <sup>2</sup> | 5.592  | 5.592  | 5.592  | 5.592  |
| Dry Pasteuriser roof                                    |                |        |        |        |        |
| Inner surface area                                      | m <sup>2</sup> | 16.837 | 16.837 | 16.837 | 16.837 |
| Outer surface area                                      | m <sup>2</sup> | 16.982 | 16.982 | 16.982 | 16.982 |
| Log mean surface area                                   | m <sup>2</sup> | 16.909 | 16.909 | 16.909 | 16.909 |
| Dry Pasteuriser roof insulation in contact with air     |                |        |        |        |        |
| Inner surface area                                      | m <sup>2</sup> | 16.982 | 16.982 | 16.982 | 16.982 |
| Outer surface area                                      | m <sup>2</sup> | 18.475 | 18.475 | 18.475 | 18.475 |
| Log mean surface area                                   | m <sup>2</sup> | 17.718 | 17.718 | 17.718 | 17.718 |

**Heating requirements**

Heat losses from pasteurisation tank

$$\text{Heat losses} = \frac{\text{Tin-Tout}}{\frac{1}{\text{Sludge film coef} \times \text{SA in}} + \frac{\text{Wall thickness}}{\text{Therm.cond} \times \text{SAmean}} + \frac{\text{Insulation thick}}{\text{Therm.cond} \times \text{SAmean}} + \frac{1}{\text{Air film coef} \times \text{SA out}}}$$

Note: The air film coefficient insulation has not been taken into account in the following calculations.

|  |    |             |             |             |             |
|--|----|-------------|-------------|-------------|-------------|
| Pasteuriser floor                            | kW | 1.680       | 1.680       | 1.680       | 0.000       |
| Wetted Pasteuriser wall in contact with soil | kW | 0.000       | 0.000       | 0.000       | 0.000       |
| Wetted Pasteuriser wall in contact with air  | kW | 3.362       | 3.362       | 3.362       | 0.000       |
| Dry Pasteuriser wall in contact with air     | kW | 0.269       | 0.269       | 0.269       | 0.000       |
| Dry Pasteuriser Roof in contact with air     | kW | 0.852       | 0.852       | 0.852       | 0.000       |
| Sub - total                                  | kW | <b>6.16</b> | <b>6.16</b> | <b>6.16</b> | <b>0.00</b> |
| Assuming the three tanks are full            | kW | <b>6.16</b> | <b>6.16</b> | <b>6.16</b> | <b>0.00</b> |
| Heat required by feed sludge                 | kW | 0.000       | 0.000       | 0.000       | 0.000       |
| Miscellaneous losses (pipes etc)             | kW | 0.616       | 0.616       | 0.616       | 0.000       |

Note: there is no heat losses in the heat exchangers.

|  |     |            |            |            |                |
|--|-----|------------|------------|------------|----------------|
| <b>TOTAL HEAT REQUIRED FOR SITE</b>                        | kW  | <b>6.8</b> | <b>6.8</b> | <b>6.8</b> | <b>0.0</b>     |
| <b>Equivalent temperature drop based on feed rate only</b> | d°C | <b>1.1</b> | <b>0.6</b> | <b>0.5</b> | <b>#DIV/0!</b> |
| <b>Equivalent temperature drop</b>                         | d°C | <b>3.4</b> | <b>1.7</b> | <b>1.4</b> | <b>#DIV/0!</b> |

In reality, the sludge spend three time the amount of time needed for filling only as a batch will then be pasteurised and emptied. This is taken into account in the equivalent temperature drop calculation cells.

The temperature depletion has been calculated using the following formulas.

$$\begin{aligned} \text{Energy (kW)} &= \text{Sludge Specific Heat} \times \text{Mass Flux} \times (\text{Tin-Tout}) \\ \text{Sludge Specific Heat} &= 4.186 \text{ kJ/kg/dK} \\ \text{Mass Flux (kg/s)} &= \text{Sludge Flow (m}^3\text{/hr)} \times \text{density (kg/m}^3\text{)} / 3600 \end{aligned}$$

For inspection purposes only. Consent of copyright owner required for any other use.



**HEAT EXCHANGER DESIGN**

**2. DESIGN WITH INCREASED FLOW (for AL)**

The minimum sludge flow through the heat exchangers will be advised by Alfa Laval. It is usually 15m<sup>3</sup>/hr

Feed flow through the heat exchangers 15 m/hr

**Recirculation around the hot water heat exchangers**

Say recirculation around the hot water HE is 15 m<sup>3</sup>/hr minimum

Temperature at inlet of heat recovery 

|    |   |    |   |
|----|---|----|---|
| 15 | 5 | 15 | 5 |
|----|---|----|---|

 deg C

The maximum percentage dry solids that will be recirculated is 6%DS.  
The minimum is still 5%DS.

|                        |      |      |      |      |       |
|------------------------|------|------|------|------|-------|
| Mass Flux              | 4.23 | 4.23 | 4.23 | 4.23 | kg/s  |
| Energy                 | 443  | 620  | 443  | 620  | kW    |
| Temperature rise       | 25   | 35   | 25   | 35   | deg C |
| Sludge temperature out | 40   | 40   | 40   | 40   | deg C |

**Heat Exchanger No.2 (Hot water)**

Raw sludge

Sludge temperature in 

|    |    |    |    |
|----|----|----|----|
| 40 | 40 | 40 | 40 |
|----|----|----|----|

 deg C

Allowance must be made for the heat losses in the pasteurisation tank and such determining the temperature of the sludge after the hot water heat exchangers.

|                        |      |      |      |      |   |
|------------------------|------|------|------|------|---|
| Heat losses            | 6.8  | 6.8  | 6.8  | 6.8  | kW (see calcs. Pasteurisation Tank Heat Losses) |
| Rise in temperature    | 0.47 | 0.47 | 1.12 | 1.12 | deg Celsius                                     |
| Sludge temperature out | 55   | 55   | 56   | 56   | deg C   |
| Chosen temperature     | 57.0 | 57.0 | 57.0 | 57.0 | deg C   |

The energy (kW) needed to heat the raw sludge is:

Energy (kW) = Specific Heat x Mass Flux x (Tin-Tout)

Specific Heat = 4.186 kJ/kg/dK

Mass Flux (kg/s) = Sludge Flow (m<sup>3</sup>/hr) x density (kg/m<sup>3</sup>) / 3600

|           |      |      |      |      |      |
|-----------|------|------|------|------|------|
| Mass Flux | 4.23 | 4.23 | 4.23 | 4.23 | kg/s |
| Energy    | 301  | 301  | 301  | 301  | kW   |

The equivalent energy will have to be provided using Hot Water.

Maximum acceptable temperature for the hot water 70 deg C

Total energy requirement 

|     |     |     |     |
|-----|-----|-----|-----|
| 744 | 921 | 744 | 921 |
|-----|-----|-----|-----|

 kW

**3. ENERGY NEEDED AT PLANT START UP**

There is no heat recovery when the plant is starting up and the sludge will be heated by means of the hot water heat exchangers only.

|                | Maximum flow |        | Minimum flow |        |
|----------------|--------------|--------|--------------|--------|
|                | Summer       | Winter | Summer       | Winter |
| Temperature in | 15           | 5      | 15           | 5      |
| Flowrate       | 15.0         | 15.0   | 5.1          | 5.1    |

Temperature needed      57            57            57            57

|               |       |       |       |       |       |
|---------------|-------|-------|-------|-------|-------|
| Flowrate      | 15.0  | 15.0  | 5.1   | 5.1   | m3/hr |
| Mass flux     | 4.23  | 4.23  | 1.44  | 1.44  | kg/s  |
| Energy needed | 744.1 | 921.2 | 253.5 | 313.8 | kW    |

Purchase 2 new boilers operating as duty/assist.

|                       |      |    |                           |
|-----------------------|------|----|---------------------------|
| Each will be rated at | 500  | kW |                           |
| Duty/assist           | 1000 | kW | okay for normal operation |

For inspection purposes only.  
Consent of copyright owner required for any other use.



## DIGESTER SIZING

|                                | Case 1                   | Case 2        | Case 3 | Case 4 |
|--------------------------------|--------------------------|---------------|--------|--------|
| Number of Digesters            | 2                        | 2             | 2      | 2      |
| Total Feed Volumetric Flowrate | m <sup>3</sup> /d 246.47 | <b>209.04</b> | 201.52 | 122.39 |

### All Digesters in Service

|                                     |                   |        |               |        |        |   |
|-------------------------------------|-------------------|--------|---------------|--------|--------|---|
| Flowrate per Digester               | m <sup>3</sup> /d | 123.24 | <b>104.52</b> | 100.76 | 61.20  | Check against pasteurisation design sheets 8420<br>Ref: Vol 4 section 7.9.6 |
| Retention Time Required             | d                 | 14.0   | <b>14.0</b>   | 14.0   | 14.0   |   |
| Minimum Digester Capacity Required  | m <sup>3</sup>    | 1725   | <b>1463</b>   | 1411   | 857    |   |
| Allowance for Grit build-up         | %                 | 1.0    | <b>5.0</b>    | 5.0    | 5.0    |   |
| Design Capacity                     | m <sup>3</sup>    | 1743   | <b>1536</b>   | 1481   | 900    |   |
| Capacity Selected                   | m <sup>3</sup>    | 1700   | <b>1700</b>   | 1700   | 1700   |   |
| Ratio of Diameter to Height (h=nxd) |                   | 0.90   | <b>0.90</b>   | 0.90   | 0.90   |   |
| Floor Slope Selected                | degrees           | 10.00  | <b>10.00</b>  | 10.00  | 10.00  |   |
| Calculated Diameter                 | m                 | 13.255 | <b>13.255</b> | 13.255 | 13.255 |   |
| Calculated Height                   | m                 | 11.930 | <b>11.930</b> | 11.930 | 11.930 |   |
| Selected Diameter                   | m                 | 13.300 | <b>13.300</b> | 13.300 | 13.300 | Height restriction of 16.9m AOD, GL = 5m AOD                                |
| Selected Height                     | m                 | 12.000 | <b>12.000</b> | 12.000 | 12.000 |   |
| Volume of Selected Tank             | m <sup>3</sup>    | 1721   | <b>1721</b>   | 1721   | 1721   | Note: Tendered volume 1660 m <sup>3</sup>                                   |
| Retention Time in Selected Tank     | d                 | 14.0   | <b>16.5</b>   | 17.1   | 28.1   |   |

### Some Digesters Out of Service

|                                     |                   |        |               |        |        |
|-------------------------------------|-------------------|--------|---------------|--------|--------|
| Number of Digesters Out of Service  |                   | 1      | 1             |        | 1      |
| Number of Digesters Remaining       |                   | 1      | 1             | 1      | 1      |
| Flowrate per Digester               | m <sup>3</sup> /d | 246.47 | <b>209.04</b> | 201.52 | 122.39 |
| Retention Time Required             | d                 | 14.00  | <b>14.00</b>  | 14.00  | 14.00  |
| Minimum Digester Capacity Required  | m <sup>3</sup>    | 3451   | <b>2927</b>   | 2821   | 1713   |
| Allowance for Grit build-up         | %                 | 1      | <b>5.0</b>    | 5.0    | 5.0    |
| Design Capacity                     | m <sup>3</sup>    | 3485   | <b>3073</b>   | 2962   | 1799   |
| Capacity Selected                   | m <sup>3</sup>    | 1600   | <b>1600</b>   | 1600   | 1600   |
| Ratio of Diameter to Height (h=nxd) |                   | 0.90   | <b>0.90</b>   | 0.90   | 0.90   |
| Floor Slope Selected                | degrees           | 10.00  | <b>10.00</b>  | 10.00  | 10.00  |
| Calculated Diameter                 | m                 | 12.990 | <b>12.990</b> | 12.990 | 12.990 |
| Calculated Height                   | m                 | 11.691 | <b>11.691</b> | 11.691 | 11.691 |
| Selected Diameter                   | m                 | 13.300 | <b>13.300</b> | 13.300 | 13.300 |
| Selected Height                     | m                 | 12.000 | <b>12.000</b> | 12.000 | 12.000 |
| Volume of Selected Tank             | m <sup>3</sup>    | 1721   | <b>1721</b>   | 1721   | 1721   |
| Retention Time in Selected Tank     | d                 | 7.0    | <b>8.2</b>    | 8.5    | 14.1   |

### Digester Size Selection Summary

|                         |                |        |             |        |        |
|-------------------------|----------------|--------|-------------|--------|--------|
| Selected Diameter       | m              | 13.300 | 13.300      | 13.300 | 13.300 |
| Selected Height         | m              | 12.000 | 12.000      | 12.000 | 12.000 |
| Volume of Selected Tank | m <sup>3</sup> | 1721   | <b>1721</b> | 1721   | 1721   |



**DIGESTERS HEAT LOSSES - Mesophilic operation****Drawing references:**

|   |                                   | Maximum flow         |               | Minimum flow  |               |  |
|---|-----------------------------------|----------------------|---------------|---------------|---------------|--|
|   |                                   | Summer               | Winter        | Summer        | Winter        |  |
| <b>Temperatures</b>                                   |                                   |                      |               |               |               |  |
| Operation of digestion                                |                                   | <b>Mesophilic</b>    |               |               |               |  |
| Raw sludge in   | <sup>0</sup> C                    | 37                   | 39            | 37            | 40            | Indicative values, not used in ca<br>Average<br>To allow for windchill |
| Inside Digester                                       | <sup>0</sup> C                    | 35                   | 35            | 35            | 35            |  |
| Air   | <sup>0</sup> C                    | 15                   | -10           | 15            | -10           |  |
| Ground  | <sup>0</sup> C                    | 0                    | 0             | 0             | 0             |  |
| <b>Sludge</b>   |                                   |                      |               |               |               |  |
| Specific Heat   | kJ/kg. <sup>0</sup> C             | 4.186                | 4.186         | 4.186         | 4.186         |  |
| Feedrate  | m <sup>3</sup> /h                 | 12.34                | 12.34         | 5.11          | 5.11          |  |
| Solids concentration                                  | % w/w                             | 5.41%                | 5.41%         | 5.41%         | 5.41%         |  |
| Density   | kg/m <sup>3</sup>                 | 1015.7               | 1015.7        | 1015.7        | 1015.7        |  |
| <b>Digester</b>                                       |                                   |                      |               |               |               |  |
| Retention time *                                      | days                              | 13.9                 | 13.9          | 14.0          | 14.0          |  |
| (with 1 digester in service only)                     |                                   | 6.97                 | 6.97          | 7.02          | 7.02          |  |
| Total retention volume Selected                       | m <sup>3</sup>                    | 3442                 | 3442          | 1721          | 1721          |  |
| No digesters  |                                   | 2                    | 2             | 1             | 1             |  |
| Retention volume of each digester                     | m <sup>3</sup>                    | 1721                 | 1721          | 1721          | 1721          |  |
| Maximum permitted heatlosses                          |                                   |                      |               |               |               |  |
| Temperature drop                                      | <sup>0</sup> C                    | 1.00                 | 1.00          | 1.00          | 1.00          |  |
| Time  | h                                 | 24                   | 24            | 24            | 24            |  |
| Energy  | kJ                                | 7.317E+06            | 7.317E+06     | 7.317E+06     | 7.317E+06     |  |
| Rate of heat loss per digester                        | kW                                | 84.69                | 84.69         | 84.69         | 84.69         |  |
| <b>Thermal conductivities</b>                         |                                   |                      |               |               |               |  |
| Steel Wall  | W/m. <sup>0</sup> C               | 45                   | 45            | 45            | 45            |  |
| Steel Floor   | W/m. <sup>0</sup> C               | 45                   | 45            | 45            | 45            |  |
| Concrete wall   | W/m. <sup>0</sup> C               | 1.5                  | 1.5           | 1.5           | 1.5           |  |
| Concrete floor  | W/m. <sup>0</sup> C               | 1.5                  | 1.5           | 1.5           | 1.5           |  |
| Concrete roof   | W/m. <sup>0</sup> C               | 1.5                  | 1.5           | 1.5           | 1.5           |  |
| Steel roof  | W/m. <sup>0</sup> C               | 45                   | 45            | 45            | 45            |  |
| GRP roof  | W/m. <sup>0</sup> C               | 1.5                  | 1.5           | 1.5           | 1.5           |  |
| Roof/wall insulation                                  | W/m. <sup>0</sup> C               | 0.037                | 0.037         | 0.037         | 0.037         |  |
| Wet soil  | W/m. <sup>0</sup> C               | 0.7                  | 0.7           | 0.7           | 0.7           |  |
| <b>Film coefficients</b>                              |                                   |                      |               |               |               |  |
| Sludge  | W/m <sup>2</sup> . <sup>0</sup> C | 1000                 | 1000          | 1000          | 1000          |  |
| Gas and external air                                  | W/m <sup>2</sup> . <sup>0</sup> C | 50                   | 50            | 50            | 50            |  |
| Thickness of soil heated by digester                  | m                                 | 1                    | 1             | 1             | 1             |  |
| <b>Primary digester dimensions</b>                    |                                   |                      |               |               |               |  |
| NB area sums will need to be changed if different     |                                   | <b>Concrete Roof</b> | Concrete Roof | Concrete Roof | Concrete Roof |  |
| Inner diameter  | m                                 | 14.25                | 14.25         | 14.25         | 14.25         |  |
| Overall height of digester, roof & motor above ground | m                                 | 12.30                | 12.3          | 12.3          | 12.3          |  |
| Overall height of digester, floor & base below ground | m                                 | 1.356                | 1.356329738   | 1.356329738   | 1.356329738   |  |
| <b>Side wall</b>                                      |                                   |                      |               |               |               |  |
| Below ground  | m                                 | 0.1                  | 0.1           | 0.1           | 0.1           |  |
| Above ground  | m                                 | 11.650               | 11.650        | 11.650        | 11.650        |  |
| Total height  | m                                 | 11.750               | 11.750        | 11.750        | 11.750        |  |
| Wetted wall height                                    | m                                 | 10.750               | 10.750        | 10.750        | 10.750        |  |
| Wetted roof depth                                     | m                                 | 0.000                | 0.000         | 0.000         | 0.000         |  |
| Sludge freeboard                                      | m                                 | 1.000                | 1.0           | 1.0           | 1.0           |  |
| Height of gear box & motor                            | m                                 |                      |               |               |               |  |
| <b>Floor</b>  |                                   |                      |               |               |               |  |
| Slope   | <sup>0</sup>                      | 10.0                 | 10.00         | 10.00         | 10.00         |  |
| Depth   | m                                 | 1.256                | 1.256         | 1.256         | 1.256         |  |
| <b>Roof</b>   |                                   |                      |               |               |               |  |
| Slope   | <sup>0</sup>                      | 0.0                  | 0.0           | 0.0           | 0.0           |  |
| Height  | m                                 | 0.00                 | 0.0           | 0.0           | 0.0           |  |
| Total digester sludge volume                          | m <sup>3</sup>                    | 3442                 | 3442          | 3442          | 3442          |  |
| Wall thickness (average)                              | m                                 | 0.500                | 0.500         | 0.500         | 0.500         |  |

|                            |   |       |       |       |       |
|----------------------------|---|-------|-------|-------|-------|
| Floor thickness            | m | 0.5   | 0.500 | 0.500 | 0.500 |
| Roof thickness             | m | 0.300 | 0.300 | 0.300 | 0.300 |
| Wall insulation thickness  | m | 0     | 0.000 | 0.000 | 0.000 |
| Floor insulation thickness | m | 0     | 0.000 | 0.000 | 0.000 |
| Roof insulation thickness  | m | 0     | 0.000 | 0.000 | 0.000 |

**Surface areas**

|  |                |              |              |              |              |
|--|----------------|--------------|--------------|--------------|--------------|
| <b>Digester base</b>                                       |                |              |              |              |              |
| Inner surface area   | m <sup>2</sup> | 161.9        | 161.9        | 161.9        | 161.9        |
| Outer surface area   | m <sup>2</sup> | 167.6        | 167.6        | 167.6        | 167.6        |
| Log mean surface area                                      | m <sup>2</sup> | <b>164.8</b> | <b>164.8</b> | <b>164.8</b> | <b>164.8</b> |
| <b>Wetted digester base insulation in contact with air</b> |                |              |              |              |              |
| Inner surface area   | m <sup>2</sup> | 0.0          | 0.0          | 0.0          | 0.0          |
| Outer surface area   | m <sup>2</sup> | 0.0          | 0.0          | 0.0          | 0.0          |
| Log mean surface area                                      | m <sup>2</sup> | 0            | 0            | 0            | 0            |
| <b>Wetted digester wall in contact with soil</b>           |                |              |              |              |              |
| Inner surface area   | m <sup>2</sup> | 4.8          | 4.8          | 4.8          | 4.8          |
| Outer surface area   | m <sup>2</sup> | 5.4          | 5.4          | 5.4          | 5.4          |
| Log mean surface area                                      | m <sup>2</sup> | <b>5.1</b>   | <b>5.1</b>   | <b>5.1</b>   | <b>5.1</b>   |
| <b>Wetted digester insulation wall / soil</b>              |                |              |              |              |              |
| Inner surface area   | m <sup>2</sup> | 0.0          | 0.0          | 0.0          | 0.0          |
| Outer surface area   | m <sup>2</sup> | 0.0          | 0.0          | 0.0          | 0.0          |
| Log mean surface area                                      | m <sup>2</sup> | <b>0.0</b>   | <b>0.0</b>   | <b>0.0</b>   | <b>0.0</b>   |
| <b>Wetted digester wall above ground</b>                   |                |              |              |              |              |
| Inner surface area   | m <sup>2</sup> | 476.8        | 476.8        | 476.8        | 476.8        |
| Outer surface area   | m <sup>2</sup> | 510.2        | 510.2        | 510.2        | 510.2        |
| Log mean surface area                                      | m <sup>2</sup> | <b>493.3</b> | <b>493.3</b> | <b>493.3</b> | <b>493.3</b> |
| <b>Wetted digester wall insulation in contact with air</b> |                |              |              |              |              |
| Inner surface area   | m <sup>2</sup> | 0.0          | 0.0          | 0.0          | 0.0          |
| Outer surface area   | m <sup>2</sup> | 0.0          | 0.0          | 0.0          | 0.0          |
| Log mean surface area                                      | m <sup>2</sup> | <b>0.0</b>   | <b>0.0</b>   | <b>0.0</b>   | <b>0.0</b>   |
| <b>Dry digester wall above ground</b>                      |                |              |              |              |              |
| Inner surface area   | m <sup>2</sup> | 44.8         | 44.8         | 44.8         | 44.8         |
| Outer surface area   | m <sup>2</sup> | 47.9         | 47.9         | 47.9         | 47.9         |
| Log mean surface area                                      | m <sup>2</sup> | <b>46.3</b>  | <b>46.3</b>  | <b>46.3</b>  | <b>46.3</b>  |
| <b>Dry digester wall insulation in contact with air</b>    |                |              |              |              |              |
| Inner surface area   | m <sup>2</sup> | 0.0          | 0.0          | 0.0          | 0.0          |
| Outer surface area   | m <sup>2</sup> | 0.0          | 0.0          | 0.0          | 0.0          |
| Log mean surface area                                      | m <sup>2</sup> | <b>0.0</b>   | <b>0.0</b>   | <b>0.0</b>   | <b>0.0</b>   |
| <b>Dry digester roof in contact with air</b>               |                |              |              |              |              |
| Inner surface area   | m <sup>2</sup> | 159.5        | 159.5        | 159.5        | 159.5        |
| Outer Surface area   | m <sup>2</sup> | 166.3        | 166.3        | 166.3        | 166.3        |
| Log mean surface area                                      | m <sup>2</sup> | <b>162.9</b> | <b>162.9</b> | <b>162.9</b> | <b>162.9</b> |
| <b>Roof insulation in contact with air</b>                 |                |              |              |              |              |
| Inner surface area   | m <sup>2</sup> | 0.0          | 0.0          | 0.0          | 0.0          |
| Outer Surface area   | m <sup>2</sup> | 0.0          | 0.0          | 0.0          | 0.0          |
| Log mean surface area                                      | m <sup>2</sup> | 0.0          | 0.0          | 0.0          | 0.0          |

**Heating requirements**

The typical equation for the Heat losses for wetted wall is

$$\text{Heat losses} = \frac{\text{Tin-Tout}}{\frac{1}{\text{Sludge film coef} \times \text{SA in}} + \frac{\text{Wall thickness}}{\text{Therm.cond}} + \frac{\text{Insulation thick}}{\text{Therm.cond}} + \frac{1}{\text{SAmean} \times \text{Air film coef}}}$$

*(this later is not taken into accounts in calcs)*

Notes: In the following calculations, this formula is corrected for dry surfaces and includes a Gas film coefficient instead of the sludge film coefficient. It is also corrected if there is no insulation.

The heat losses from digester floor consider that there is 1 meter thickness of wetted ground below the digester.

However, CHANGE FORMULA ACCORDING TO THE MATERIAL USED.

**Heat losses from digesters**

|   |    |             |              |             |                 |
|---|----|-------------|--------------|-------------|-----------------|
| Digester floor                                    | kW | 3.3         | 3.3          | 3.3         | 3.3             |
| Wetted digester wall in contact with soil         | kW | 0.1         | 0.1          | 0.1         | 0.1             |
| Wetted digester wall in contact with air          | kW | 29.5        | 66.4         | 29.5        | 66.4            |
| Dry Digester wall in contact with air (gas space) | kW | 0.0         | 0.0          | 0.0         | 0.0             |
| Dry Digester Roof in contact with air             | kW | 14.8        | 33.2         | 14.8        | 33.2            |
| Sub - total                                       | kW | 47.7        | 103.1        | 47.7        | 103.1           |
| Heat required by feed sludge                      | kW | 0.0         | 0.0          | 0.0         | 0.0             |
| Miscellaneous losses (pipes etc)                  | kW | 9.5         | 20.6         | 4.8         | 10.3 (Estimate) |
| <b>TOTAL HEAT REQUIRED FOR SITE</b>               | kW | <b>95.4</b> | <b>206.1</b> | <b>47.7</b> | <b>103.1</b>    |
| <b>TOTAL HEAT REQUIRED PER DIGESTER</b>           |    | <b>47.7</b> | <b>103.1</b> | <b>47.7</b> | <b>103.1</b>    |

**Quick heat losses estimation**

Assuming that a digester has been designed to loose not more than 1 degrees C per m3 per day in winter;

$$\text{Heat Loss (kW)} = \frac{\text{Specific Heat} \times \text{Digester Volume (m}^3\text{)} \times \text{Density} \times 1 \text{ deg C}}{24 \times 3600}$$

In summer, the heat losses are half the winter heatlosses (approximately).

| kW | Maximum flow |        | Minimum flow |        | single digester |
|----|--------------|--------|--------------|--------|-----------------|
|    | Summer       | Winter | Summer       | Winter |                 |
|    | 97.4         | 194.9  | 97.4         | 194.9  |                 |
|    |              |        | 48.7         | 97.4   |                 |

The estimated values are very close from the calculated values. The calculations will take into account the calculated values.



| <b>DIGESTER GAS PRODUCTION</b>                                     |                       |        |        |        |        |
|--|-----------------------|--------|--------|--------|--------|
|  |                       | Case 1 | Case 2 | Case 3 | Case 4 |
| Total Sludge Volatile Solids                                       | kg VS/d               | 10298  | 8737   | 8391   | 5091   |
| Specific Gas Yield   | m <sup>3</sup> /kg VS | 1.00   | 1.00   | 1.00   | 1.00   |
| Net Gas Calorific Value  | MJ/m <sup>3</sup>     | 22.50  | 22.50  | 22.50  | 22.50  |
| <b>Minimum Volatile Solids Destruction</b>                         |                       |        |        |        |        |
| Minimum Volatile Solids Reduction                                  | %                     | 40     | 40     | 40     | 40     |
| Minimum Volatile Solids Destroyed                                  | kg VS/d               | 4119   | 3495   | 3357   | 2037   |
| Minimum Gas Yield (Total)  | m <sup>3</sup> /d     | 4119   | 3495   | 3357   | 2037   |
| Minimum Net Gas Fuel Value (Total)                                 | kW                    | 1073   | 910    | 874    | 530    |
| <b>Average Volatile Solids Destruction</b>                         |                       |        |        |        |        |
| Average Volatile Solids Reduction                                  | %                     | 45     | 45     | 45     | 45     |
| Average Volatile Solids Destroyed                                  | kg VS/d               | 4634   | 3932   | 3776   | 2291   |
| Average Gas Yield (Total)  | m <sup>3</sup> /d     | 4634   | 3932   | 3776   | 2291   |
| Average Net Gas Fuel Value (Total)                                 | kW                    | 1207   | 1024   | 983    | 597    |
| <b>Maximum Volatile Solids Destruction</b>                         |                       |        |        |        |        |
| Maximum Volatile Solids Reduction                                  | %                     | 50     | 50     | 50     | 50     |
| Maximum Volatile Solids Destroyed                                  | kg VS/d               | 5149   | 4369   | 4196   | 2546   |
| Maximum Gas Yield (Total)  | m <sup>3</sup> /d     | 5149   | 4369   | 4196   | 2546   |
| Maximum Net Gas Fuel Value (Total)                                 | kW                    | 1341   | 1138   | 1093   | 663    |
| <b>Gas Production Per Digester (All Digesters in Service)</b>      |                       |        |        |        |        |
| Minimum Gas Production   | m <sup>3</sup> /d     | 2060   | 1747   | 1678   | 1018   |
| Average Gas Production   | m <sup>3</sup> /d     | 2517   | 1966   | 1888   | 1146   |
| Maximum Gas Production   | m <sup>3</sup> /d     | 2574   | 2184   | 2098   | 1273   |
| <b>Gas Production Per Digester (Some Digesters Out of Service)</b> |                       |        |        |        |        |
| Minimum Gas Production   | m <sup>3</sup> /d     | 4119   | 3495   | 3357   | 2037   |
| Average Gas Production   | m <sup>3</sup> /d     | 4634   | 3932   | 3776   | 2291   |
| Maximum Gas Production   | m <sup>3</sup> /d     | 5149   | 4369   | 4196   | 2546   |
| <b>Digester Outlet Solids Concentration</b>                        |                       |        |        |        |        |
| Digesters Feed Volume  | m <sup>3</sup> /d     | 246.47 | 209.04 | 201.52 | 122.39 |
| Digesters Feed Dry Solids  | kg DS/d               | 14247  | 12086  | 11625  | 7056   |
| Digesters Feed Volatile Solids                                     | kg VS/d               | 10298  | 8737   | 8391   | 5091   |
| Reduction of Volatile Solids                                       | %                     | 40     | 40     | 40     | 40     |
| Volatile Solids Destroyed  | kg VS/d               | 4119   | 3495   | 3357   | 2037   |
| Volatile Solids in Digesters Outlet                                | kg VS/d               | 6179   | 5242   | 5035   | 3055   |
| Dry Solids in Digester Outlet                                      | kg DS/d               | 10128  | 8591   | 8268   | 5019   |
| Digester Outlet Dry Solids Concentration                           | % DS                  | 4.11   | 4.11   | 4.10   | 4.10   |
| Reduction of Volatile Solids                                       | %                     | 45     | 45     | 45     | 45     |
| Volatile Solids Destroyed  | kg VS/d               | 4634   | 3932   | 3776   | 2291   |
| Volatile Solids in Digesters Outlet                                | kg VS/d               | 5664   | 4805   | 4615   | 2800   |
| Dry Solids in Digester Outlet                                      | kg DS/d               | 9613   | 8154   | 7849   | 4765   |
| Digester Outlet Dry Solids Concentration                           | % DS                  | 3.90   | 3.90   | 3.89   | 3.89   |
| Reduction of Volatile Solids                                       | %                     | 50     | 50     | 50     | 50     |
| Volatile Solids Destroyed  | kg VS/d               | 5149   | 4369   | 4196   | 2546   |
| Volatile Solids in Digesters Outlet                                | kg VS/d               | 5149   | 4369   | 4196   | 2546   |
| Dry Solids in Digester Outlet                                      | kg DS/d               | 9098   | 7717   | 7429   | 4510   |
| Digester Outlet Dry Solids Concentration                           | % DS                  | 3.69   | 3.69   | 3.69   | 3.69   |



**GAS HOLDER, EXCESS GAS BURNER AND DIGESTER PRESSURE/VACUUM RELIEF VALVES SIZING**

|   |                   | Case 1 | Case 2 | Case 3 | Case 4 |
|---|-------------------|--------|--------|--------|--------|
| <b>Gas Holder</b>                         |                   |        |        |        |        |
| Number of Gas Holders                     |                   | 1      | 1      | 1      | 1      |
| Average Gas Production Rate               | m <sup>3</sup> /h | 193    | 164    | 157    | 95     |
| Retention Time in each Gas Holder         | min               | 60     | 60     | 60     | 60     |
| Capacity of each Gas Holder               | m <sup>3</sup>    | 193    | 164    | 157    | 95     |
| Selected Capacity of each Gas Holder      | m <sup>3</sup>    | 200    | 200    | 200    | 200    |
| Retention Time at Minimum Production Rate | min               | 70     | 82     | 86     | 141    |
| Retention Time at Average Production Rate | min               | 62     | 73     | 76     | 126    |
| Retention Time at Maximum Production Rate | min               | 56     | 66     | 69     | 113    |

**Excess Gas Burner**

|                              |                   |     |     |     |     |
|------------------------------|-------------------|-----|-----|-----|-----|
| Maximum Gas Production Rate  | m <sup>3</sup> /h | 215 | 182 | 175 | 106 |
| Gas Burner Oversizing Margin | %                 | 25  | 25  | 25  | 25  |
| Gas Burner Capacity Required | m <sup>3</sup> /h | 268 | 228 | 219 | 133 |

**Digester Pressure/Vacuum Relief Valve - Pressure Relief Condition**

|                               |                   |     |     |     |    |  |
|-------------------------------|-------------------|-----|-----|-----|----|--|
| Maximum Gas Production Rate   | m <sup>3</sup> /h | 107 | 91  | 87  | 53 |  |
| Mixing Compressor Flowrate    | m <sup>3</sup> /h | 0   | 0   | 0   | 0  | Mechanical Mixing                      |
| Digester Feed Volume          | m <sup>3</sup> /h | 15  | 15  | 15  | 15 | Ref: Pasteurisation design sheets 8420 |
| Pressure Relief Rate Required | m <sup>3</sup> /h | 122 | 106 | 102 | 68 |  |

**Digester Pressure/Vacuum Relief Valve - Vacuum Relief Condition**

|   |    |        |        |        |        |
|---|----|--------|--------|--------|--------|
| Digester Height (Centre of Cone to TWL) | m  | 13.173 | 13.173 | 13.173 | 13.173 |
| Drain Pipe Diameter (ID)                | m  | 0.20   | 0.20   | 0.20   | 0.20   |
| Drain Pipe Length                       | m  | 10.0   | 15.0   | 18.0   | 20.0   |
| Roughness                               | mm | 0.5    | 0.5    | 0.5    | 0.5    |
| Fittings K <sub>T</sub>                 |    | 2      | 2      | 2      | 2      |

Maximum vacuum relief rate will occur when the friction loss in the outlet line is equal to the static head above the outlet. To evaluate this, the flowrate at which the static head is equal to the friction loss must be determined. Note that the friction factor and hence the friction loss is dependent on the flowrate so the equations must be solved by iteration.

To solve, use the following procedure :

- From "Tools" menu choose "Goal Seek"
- In "Set cell" box enter "C64", "D64", "E64", "F64"
- In "To value" box enter number contained in cell C39, D39, E39, F39
- In "By changing cell" box enter "C56", "D56", "E56", "F56"

|                                 |                    |         |         |         |         |
|---------------------------------|--------------------|---------|---------|---------|---------|
| Maximum Flowrate                | m <sup>3</sup> /h  | 882     | 824     | 794     | 776     |
| Water Temperature for Design    | °C                 | 35.0    | 35.0    | 35.0    | 35.0    |
| Water Density                   | kg/m <sup>3</sup>  | 994     | 994     | 994     | 994     |
| Water Viscosity                 | mNs/m <sup>2</sup> | 0.7204  | 0.7204  | 0.7204  | 0.7204  |
| Velocity                        | m/s                | 7.80    | 7.28    | 7.02    | 6.86    |
| Reynolds Number                 |                    | 2152745 | 2010124 | 1937033 | 1892508 |
| Friction Factor                 | f us               | 0.02495 | 0.02495 | 0.02496 | 0.02496 |
| Dynamic Head Loss               | m H <sub>2</sub> O | 13.17   | 13.17   | 13.17   | 13.17   |
| Vacuum Relief Flowrate Required | m <sup>3</sup> /h  | 882     | 824     | 794     | 776     |



## 1. SCOPE

To calculate the dewaterer duties for the Waterford scheme

## 2. SUMMARY

### 2.1. Scheme [Thickeners]

|                           | Min.  | Avg.  | Max.                                 |
|---------------------------|-------|-------|--------------------------------------|
| No. of duty units =       | 1     | 1     | 2                                    |
| Thickener feed flow =     | 6.04  | 10.35 | 10.35 m <sup>3</sup> h <sup>-1</sup> |
| Thickener feed solids =   | 3.9%  | 4.1%  | 4.1% by wt                           |
| ≡                         | 238.3 | 429.6 | 429.4 kg h <sup>-1</sup>             |
| Thickened solids =        | 23.0% | 23.0% | 23.0% by wt                          |
| Filtrate solids consent = | 3697  | 3923  | 3923 mg L <sup>-1</sup>              |

## 3. REFERENCES

### 3.1. Duty [From Digester]

#### 3.1.1. Sludge Feed

|                        | Min.    | Avg.    | Max.     |  |
|------------------------|---------|---------|----------|--|
| Sludge production =    | 4765.00 | 8591.00 | 10128.00 | kg d <sup>-1</sup> Ref: 8413 Sludge Digestion Gas Production |
| ≡                      | 198.5   | 358.0   | 422.0    | kg h <sup>-1</sup>   |
| Solids concentration = | 3.9%    | 4.1%    | 4.1%     | by wt  |
| Sludge density =       | 1011.3  | 1011.9  | 1011.9   | kg m <sup>-3</sup>   |
| Sludge =               | 5.03    | 8.63    | 10.17    | m <sup>3</sup> h <sup>-1</sup>                               |

#### 3.1.2. Digested Sludge Buffer Tank

|                         | Min.   | Avg.    | Max.    |                            |
|-------------------------|--------|---------|---------|----------------------------|
| Days operation =        | 5.0    | 5.0     | 5.0     | d Ref: Vol 4 section 7.9.3 |
| Hours production =      | 24.0   | 24.0    | 24.0    | h d <sup>-1</sup>          |
| No. of duty tanks =     | 1      | 1       | 1       |                            |
| Sludge storage volume = | 604.09 | 1035.41 | 1220.65 | m <sup>3</sup>             |

#### 3.1.2. Dewaterer Feed Rate

|                               | Min.   | Avg.   | Max.   |  |
|-------------------------------|--------|--------|--------|--|
| Days operation =              | 7.0    | 7.0    | 7.0    | d week <sup>-1</sup>   |
| Hours operation =             | 20.0   | 20.0   | 11.8   | h d <sup>-1</sup> Clause 7.9.7 treat average sludge load in < 20 hours |
| No. of duty units =           | 1      | 1      | 2      |  |
| Thickener unit feed flow =    | 6.04   | 10.35  | 10.35  | m <sup>3</sup> h <sup>-1</sup> per machine                             |
| Solids concentration =        | 3.9%   | 4.1%   | 4.1%   | by wt  |
| Sludge density =              | 1011.3 | 1011.9 | 1011.9 | kg m <sup>-3</sup>   |
| Thickener block feed solids = | 238.3  | 429.6  | 429.4  | kg h <sup>-1</sup>   |


**3.1.3. Thickened Solids**

|                           | Min.         | Avg.         | Max.         |  |
|---------------------------|--------------|--------------|--------------|--|
| Thickener recovery =      | 92.0%        | 92.0%        | 92.0%        | by wt of inlet solids                      |
| Cake solids =             | 219.2        | 395.2        | 395.0        | kg h <sup>-1</sup> per machine             |
| Solids concentration =    | <b>23.0%</b> | <b>23.0%</b> | <b>23.0%</b> | by wt                                      |
| Sludge density =          | 1070.3       | 1070.3       | 1070.3       | kg m <sup>-3</sup>                         |
| Thickened sludge volume = | <b>0.89</b>  | <b>1.61</b>  | <b>1.60</b>  | m <sup>3</sup> h <sup>-1</sup> per machine |

**3.1.4. Thickener Filtrate**

|                                      | Min.        | Avg.        | Max.        |  |
|--------------------------------------|-------------|-------------|-------------|--|
| Filtrate solids =                    | 19.1        | 34.4        | 34.4        | kg h <sup>-1</sup>                         |
| Approx. centrate density =           | 1000.0      | 1000.0      | 1000.0      | kg m <sup>-3</sup>                         |
| Filtrate flow =                      | <b>5.16</b> | <b>8.76</b> | <b>8.76</b> | m <sup>3</sup> h <sup>-1</sup> per machine |
| Filtrate solids concentration =      | <b>3.70</b> | <b>3.92</b> | <b>3.92</b> | kg m <sup>-3</sup>                         |
| ≡                                    | <b>3697</b> | <b>3923</b> | <b>3923</b> | mg L <sup>-1</sup>                         |
| Solids concentration =               | 0.37%       | 0.39%       | 0.39%       | by wt                                      |
| Return Load =                        | 381.2       | 687.3       | 810.2       | kg/d                                       |
| Wash water and make-up consumption = | 20.3        | 20.3        | 20.3        | Sernagiotto Literature (BPF 2000)          |
| Total filtrate return =              | 25.4        | 29.0        | 58.0        | m <sup>3</sup> h <sup>-1</sup>             |

For inspection purposes only.  
Consent of copyright owner required for any other use.

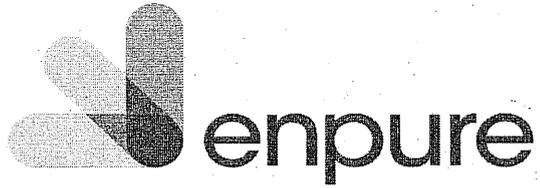

**PROCESS DESIGN CALCULATION**

**Contract Name :** Waterford

**Contract No:** C1197

**Document Reference:** 8422



**Title :** Return Liquor Tank

| Revision  | No. of Pages<br>(Excluding Cover) | Date of Issue | Purpose of Issue | Originator | Checked            | Approved           |
|---|-----------------------------------|---------------|------------------|------------|--------------------|--------------------|
| 1   | 1                                 | 01/02/2007    | Contract Issue   | DGH        | <i>[Signature]</i> | <i>[Signature]</i> |
| For inspection purposes only.<br>Consent of copyright owner required for any other use. |                                   |               |                  |            |                    |                    |

All Copyright and Design Right subsisting in this document is the property of Enpure Limited of Enpure House, Birmingham Road, Kidderminster Worcestershire, DY10 2SH and may not be re-produced without Enpure's written consent. This document and the information contained within it is confidential to Enpure Limited and may not be disclosed to any third party without Enpure's written consent.



DO NOT SCALE - IF IN DOUBT ASK

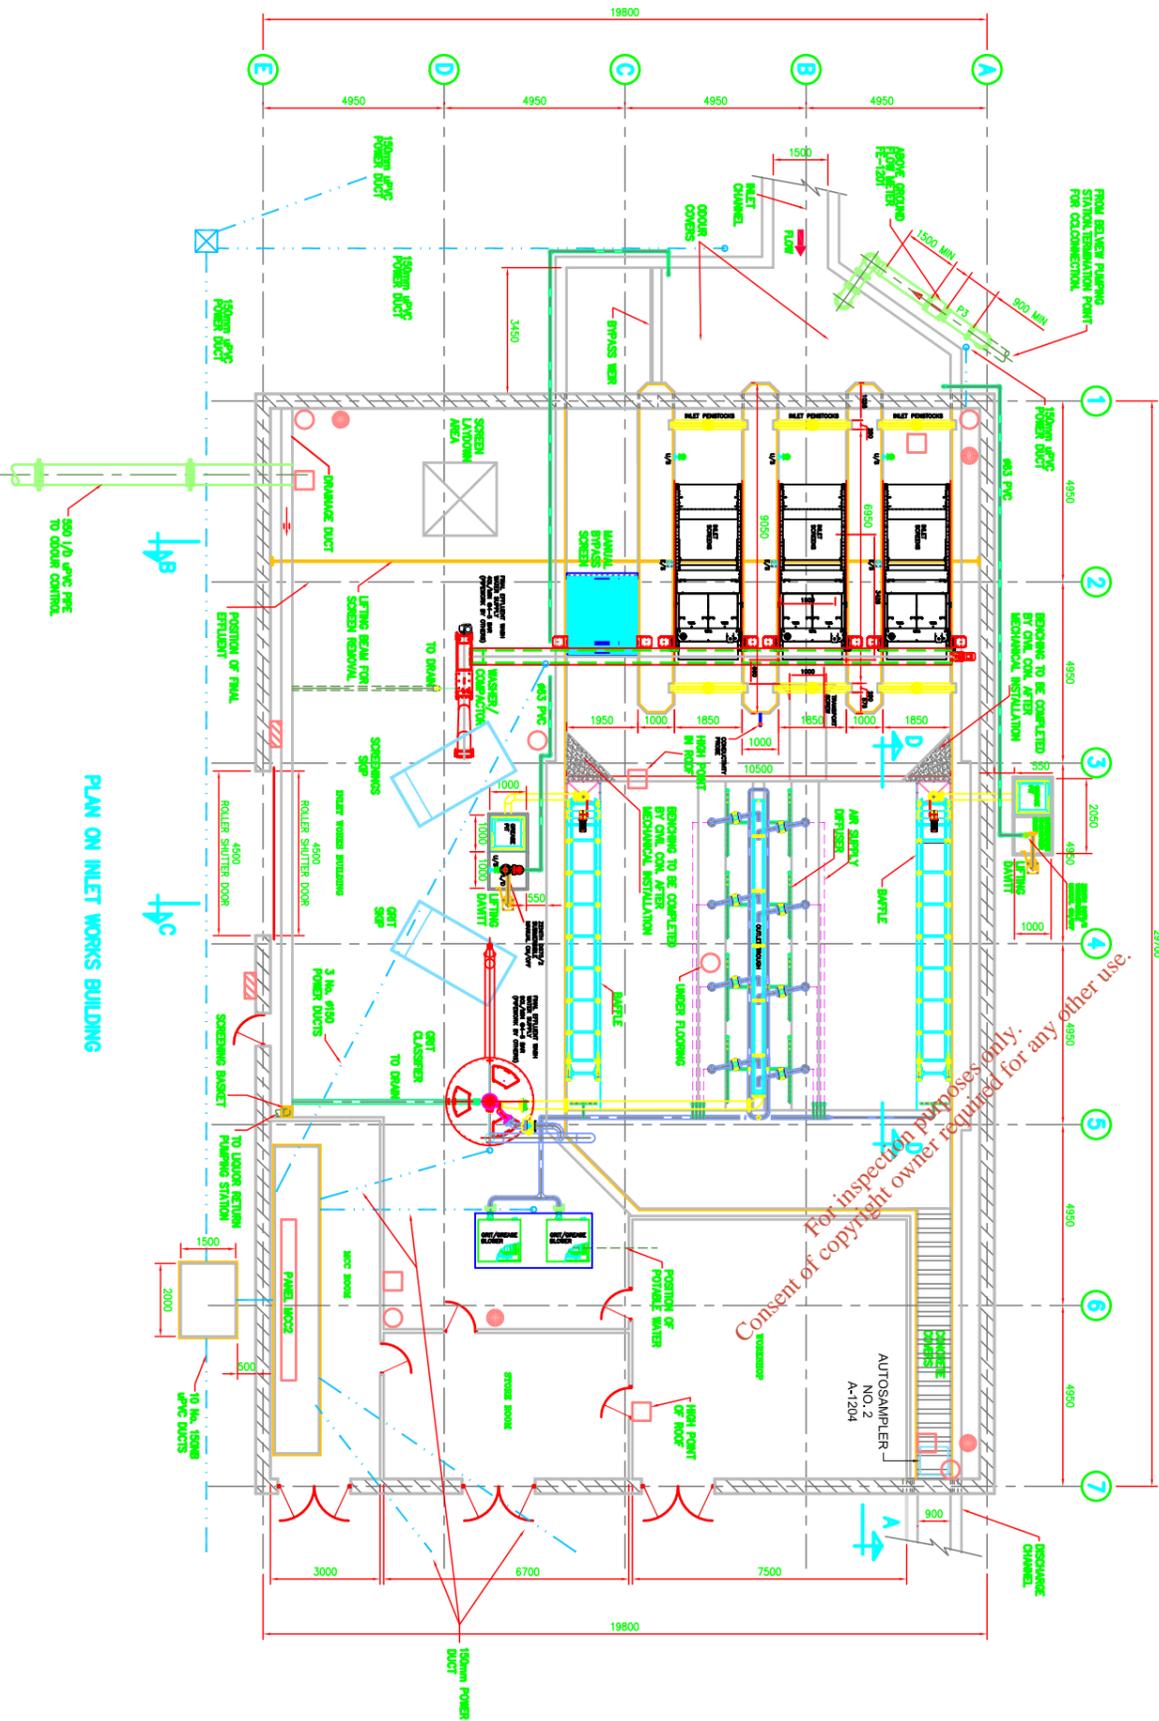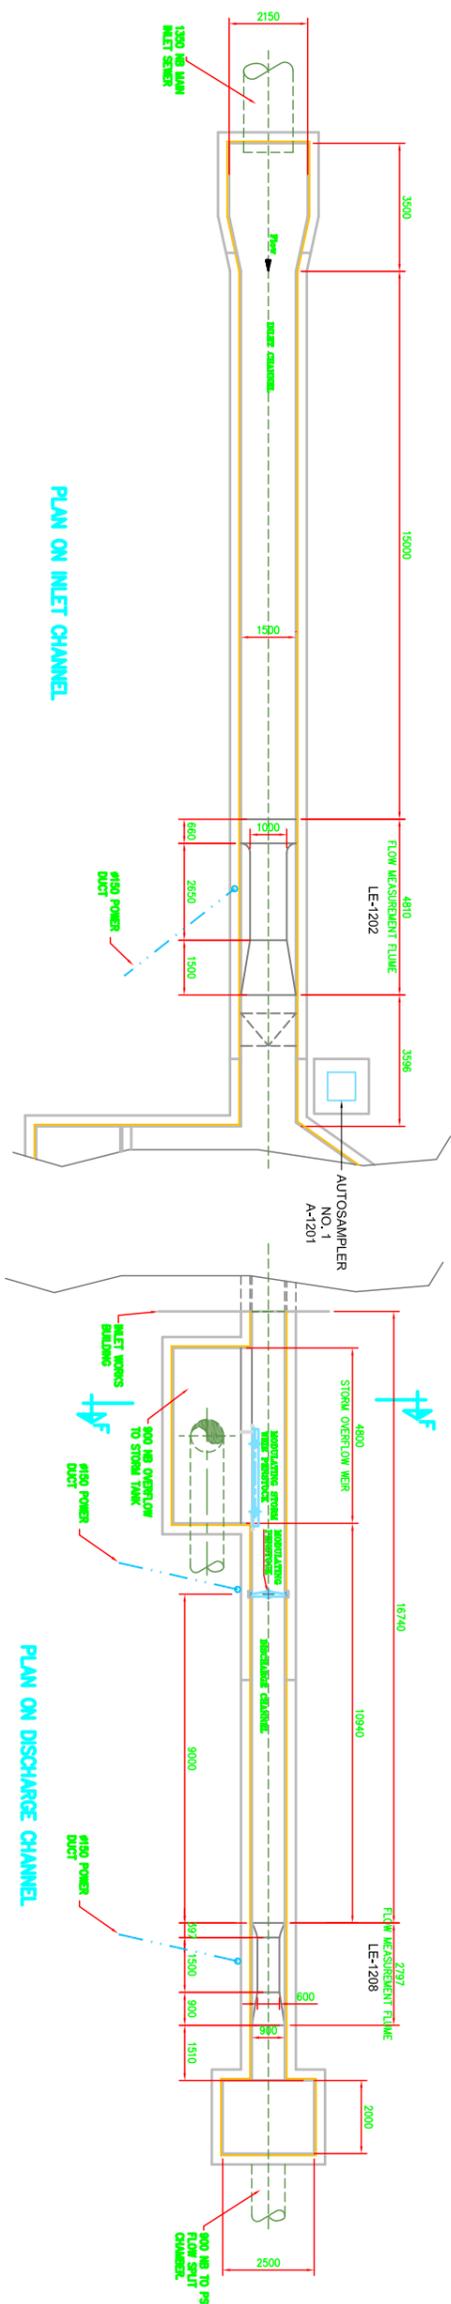

For inspection purposes only.  
Consent of copyright owner required for any other use.

| Rev | Date | Description                 | Drawn |
|-----|------|-----------------------------|-------|
| 9   |      | GAS DETECTION SYSTEM ADDED. |       |

NOTES  
1. SEE DRAWING NO C1197-9403 FOR DUCT SIZING AND ROUTING INFORMATION.

- H<sub>2</sub> (LOW LEVEL)
- O<sub>2</sub> (1.5 - 1.8m)
- CH<sub>4</sub> (HIGH LEVEL)
- ▨ STATUS INDICATOR

APPROVED FOR CIVIL DESIGN  
REV. 6 DATE 03/07/2007  
SIGNATURE JMNORTON

ISSUED APPROVED FOR CONSTRUCTION/ SHE 2 REVIEW  
COMPLETED  
DATE: 08/09/2007 SIGNATURE: JMNORTON

A.W.I. CONTRACT No 1002

enpure

enpure

Enpire Limited  
Enpire House,  
Birmingham Road,  
Kiddeminstor, DY10 2SH,  
UK  
Tel: +44 (0)1562 820 010  
Fax: +44 (0)1562 820 008  
Internet: www.enpire.co.uk

Customer:  
WATERFORD CITY COUNCIL  
Title:  
INLET WORKS  
GENERAL ARRANGEMENT - PLAN  
WATERFORD WWTW


| Drawn            | Checked | Approved | Scale        |
|------------------|---------|----------|--------------|
| DJ/Tildesley     |         |          | A1           |
| Date: 07/11/2006 | Date:   | Date:    | Scale: 1:100 |

AFC UNDER REVISION

Dr. No. C1197-2000

Rev. 9

DO NOT SCALE - IF IN DOUBT ASK

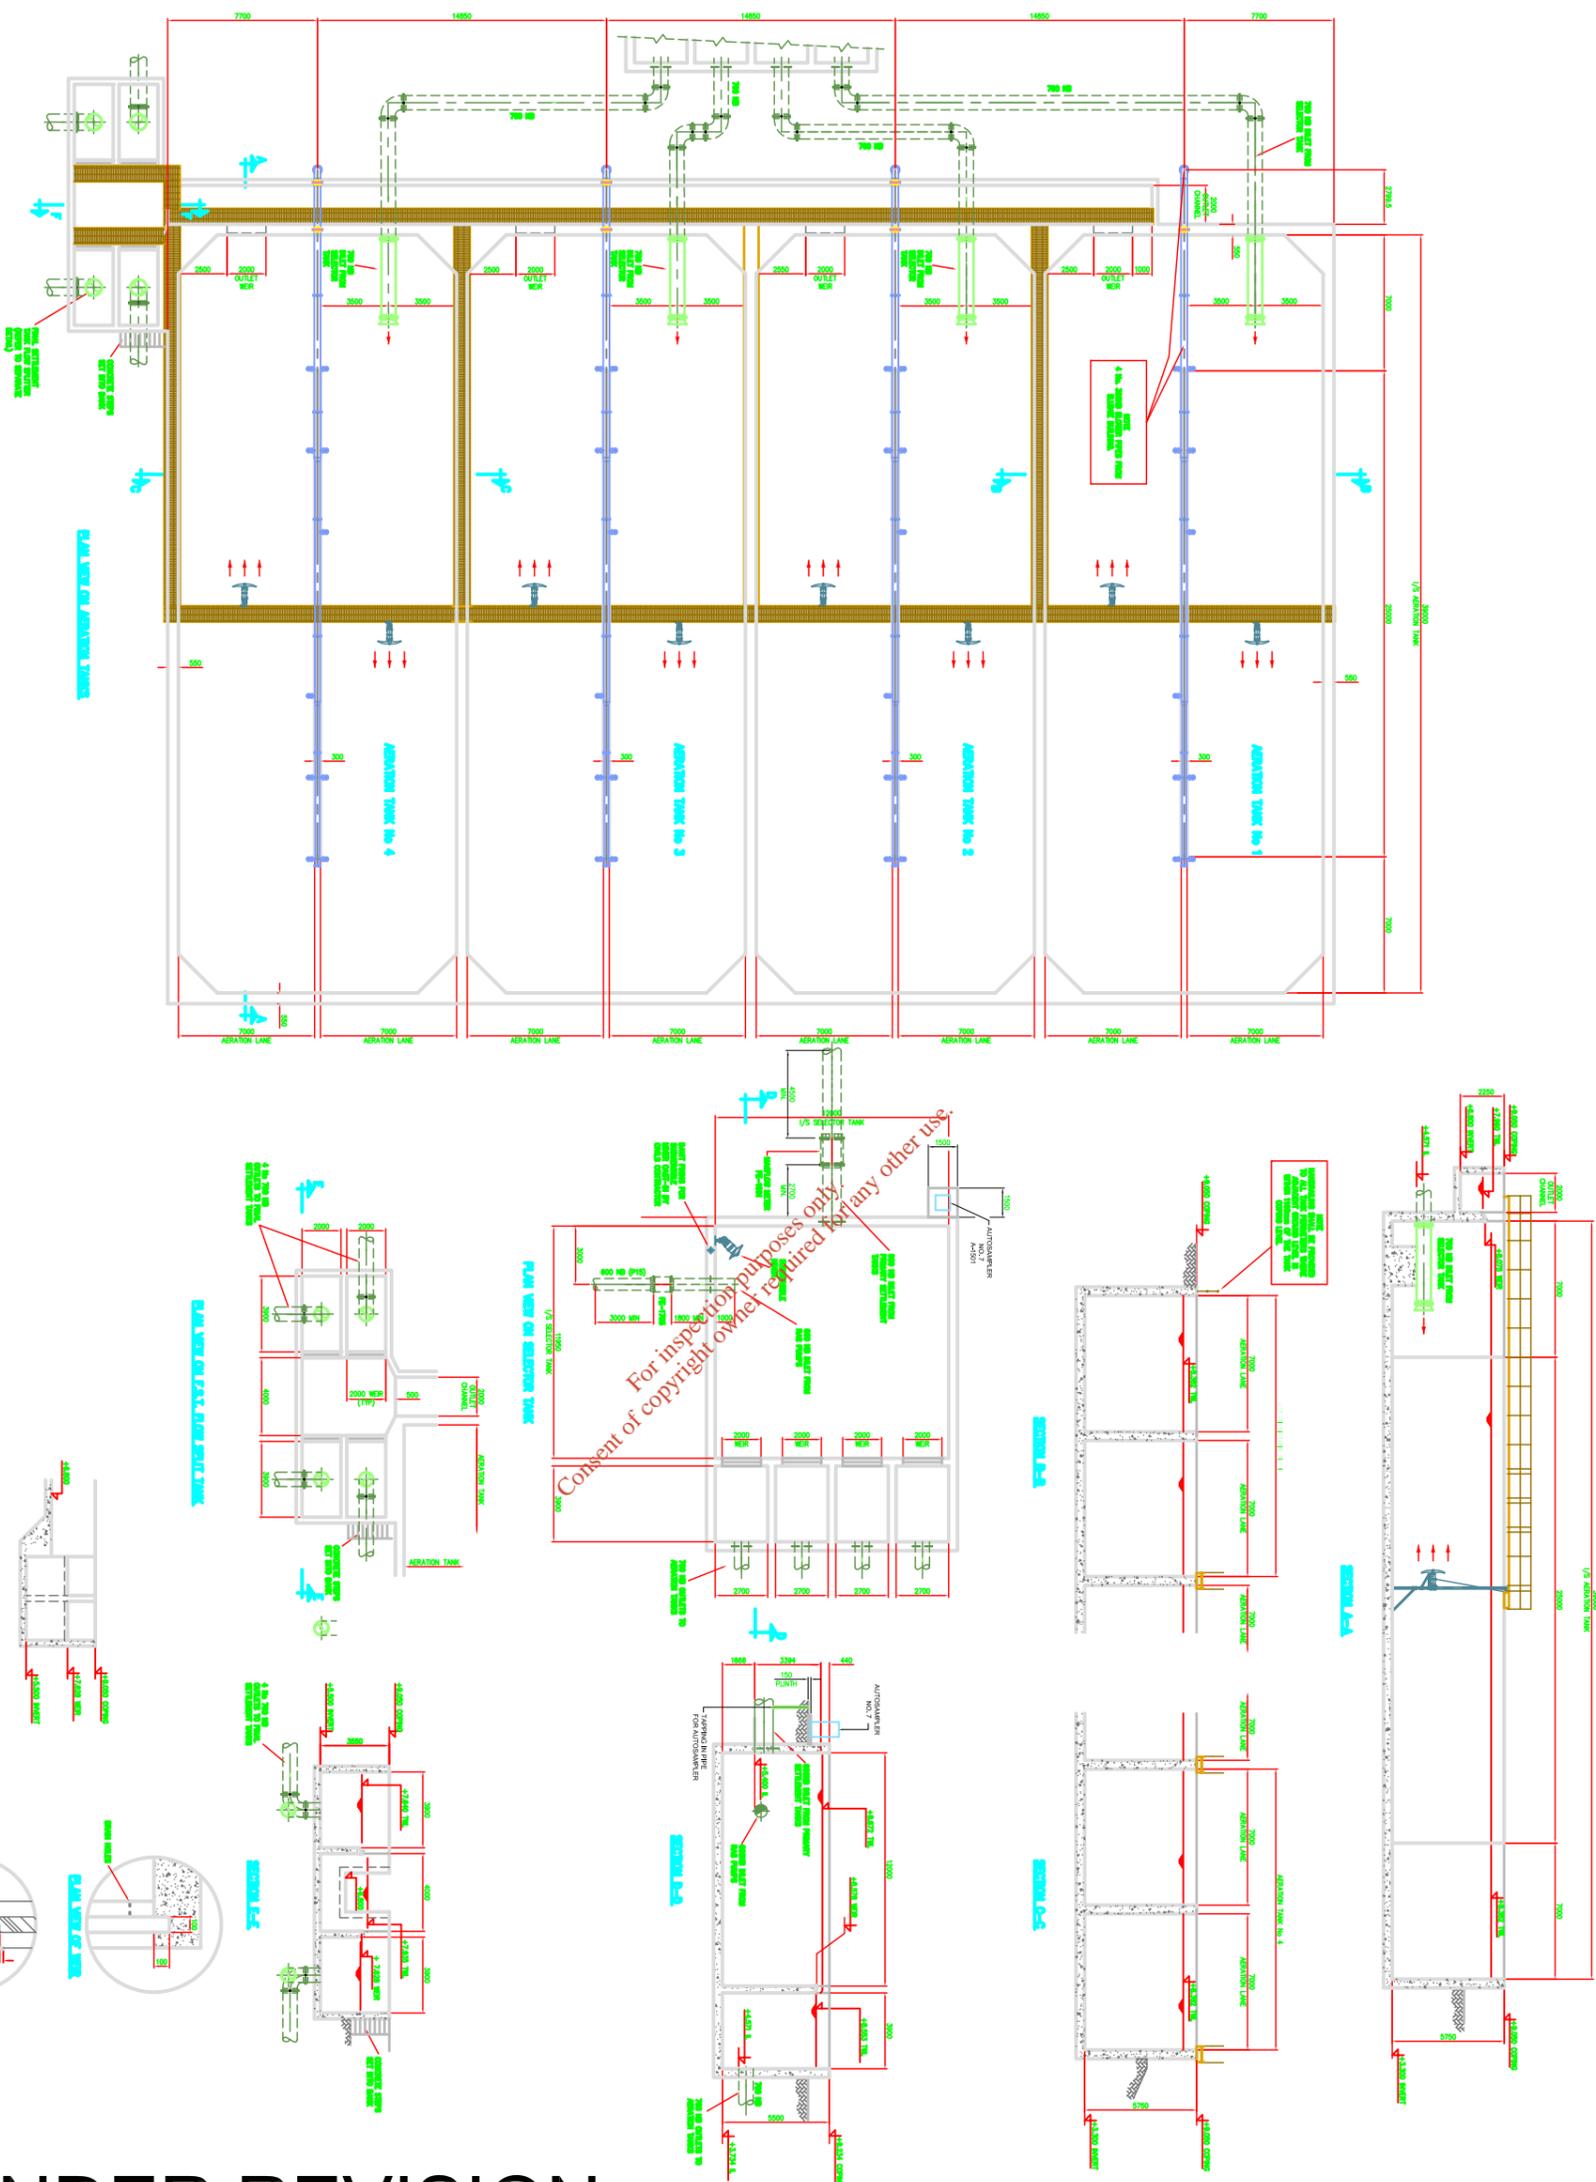

# AFC UNDER REVISION

| Rev. | Date                       | Description                        | Drawn |
|------|----------------------------|------------------------------------|-------|

**APPROVED FOR CIVIL DESIGN**  
 REV. 5      DATE \_\_\_\_\_  
 SIGNATURE \_\_\_\_\_

ISSUED APPROVED FOR CONSTRUCTION, SHEET REVIEW  
 OF **AWP 1, CONTRACT No 1002**  
 DATE: 03/07/2007 SIGNATURE: DUTTIDESLEY




**enpure**



Empure Limited  
 Empure House,  
 Birmingham Road,  
 Kidderminster, DY10 2SH,  
 UK  
 Tel: +44 (0)1562 820 010  
 Fax: +44 (0)1562 820 008  
 Internet: [www.empure.co.uk](http://www.empure.co.uk)

Client: **WATERFORD CITY COUNCIL**  
 Title: **SELECTOR AND AERATION TANKS  
 GENERAL ARRANGEMENTS  
 WATERFORD WWTW**

| Drawn                      | Checked | Approved | Checked<br>Scale |
|----------------------------|---------|----------|------------------|
| DUTTIDESLEY                |         |          | A1               |
| Date: 07/11/2006           | Date:   | Date:    | Scale: 1:175     |
| Dwg. No. <b>C1197-2006</b> |         |          | Rev. <b>5</b>    |

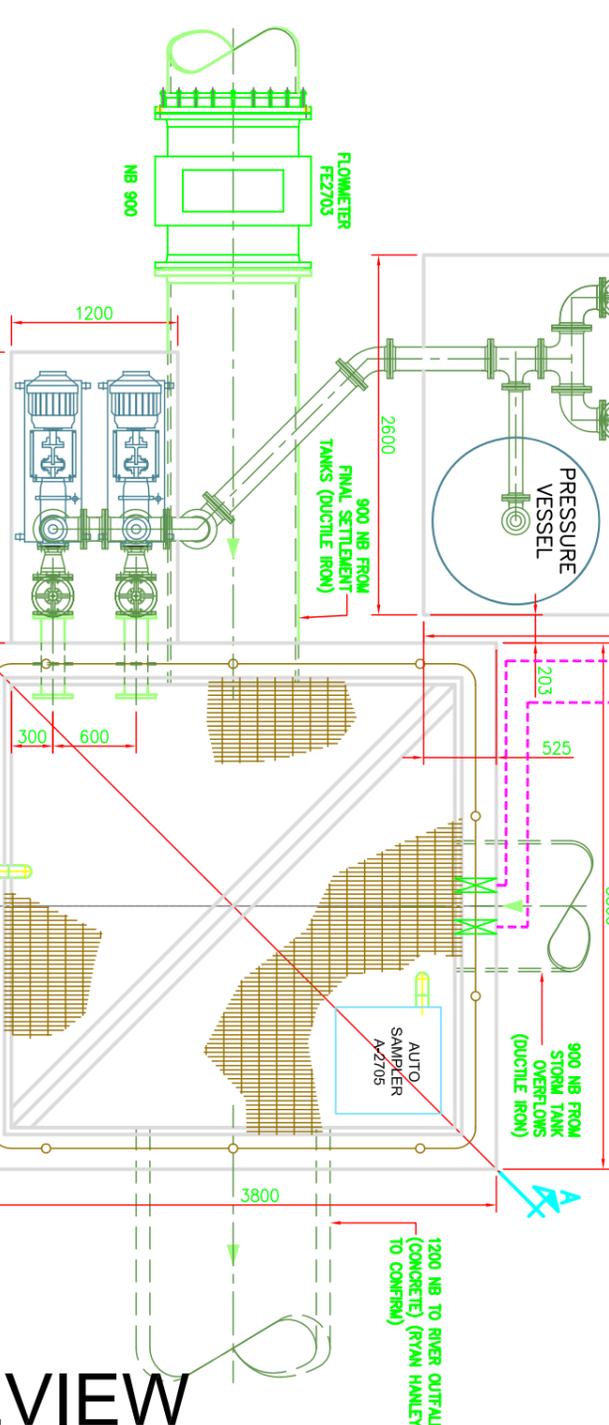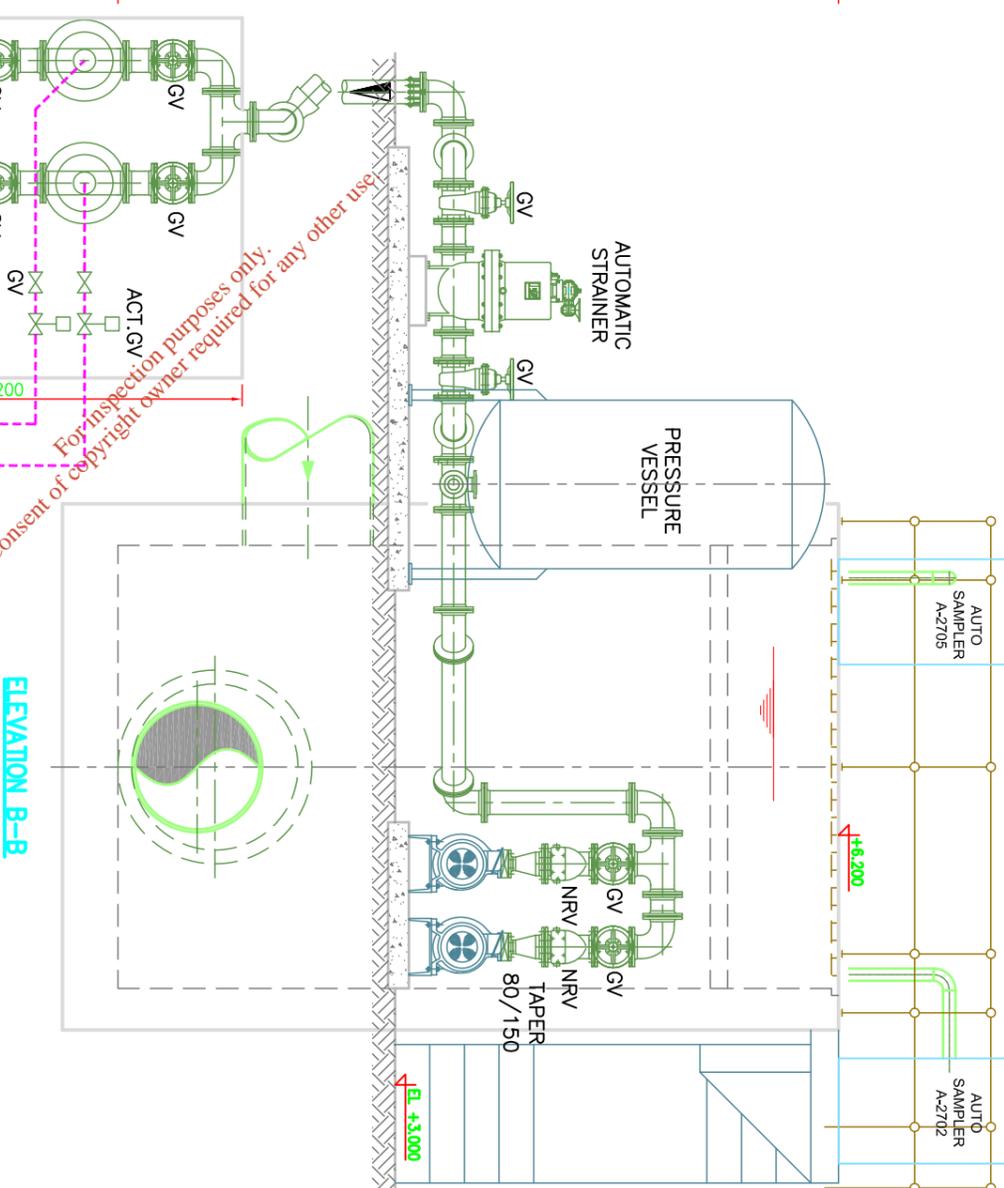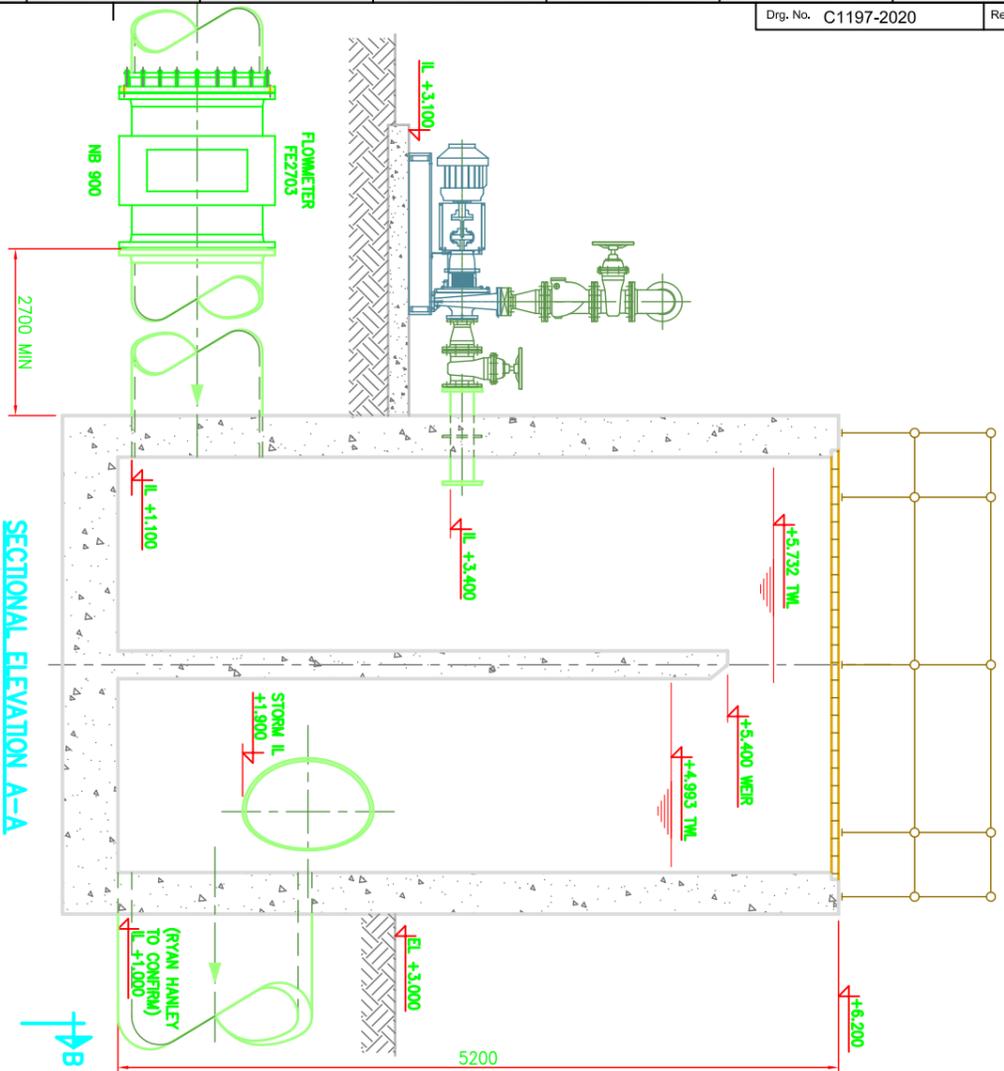

DO NOT SCALE - IF IN DOUBT ASK

| Rev. | Date | Description       | Drawn |
|------|------|-------------------|-------|
| C    |      | PRELIMING UPDATES |       |

A.W.I. CONTRACT No 1002

enpure  
 enpure logo  
 Enpure Limited  
 Enpure House,  
 Birmingham Road,  
 Internet: www.enpure.co.uk

WATERFORD CITY COUNCIL  
 WATERFORD WWTTW

FINAL EFFLUENT WASHWATER PUMPING CHAMBER  
 GENERAL ARRANGEMENTS  
 WATERFORD WWTTW








| Date       | Checked | Approved | Sheet No. |
|------------|---------|----------|-----------|
| 07/11/2006 |         |          | A1        |

Dwg. No. C1197-2020  
 Scale 1:25  
 Rev. C

IN REVIEW

DO NOT SCALE - IF IN DOUBT ASK

| Rev. | Date                | Description | Drawn |
|------|---------------------|-------------|-------|
| 3    | TWL 9.941 WAS 9.909 |             |       |

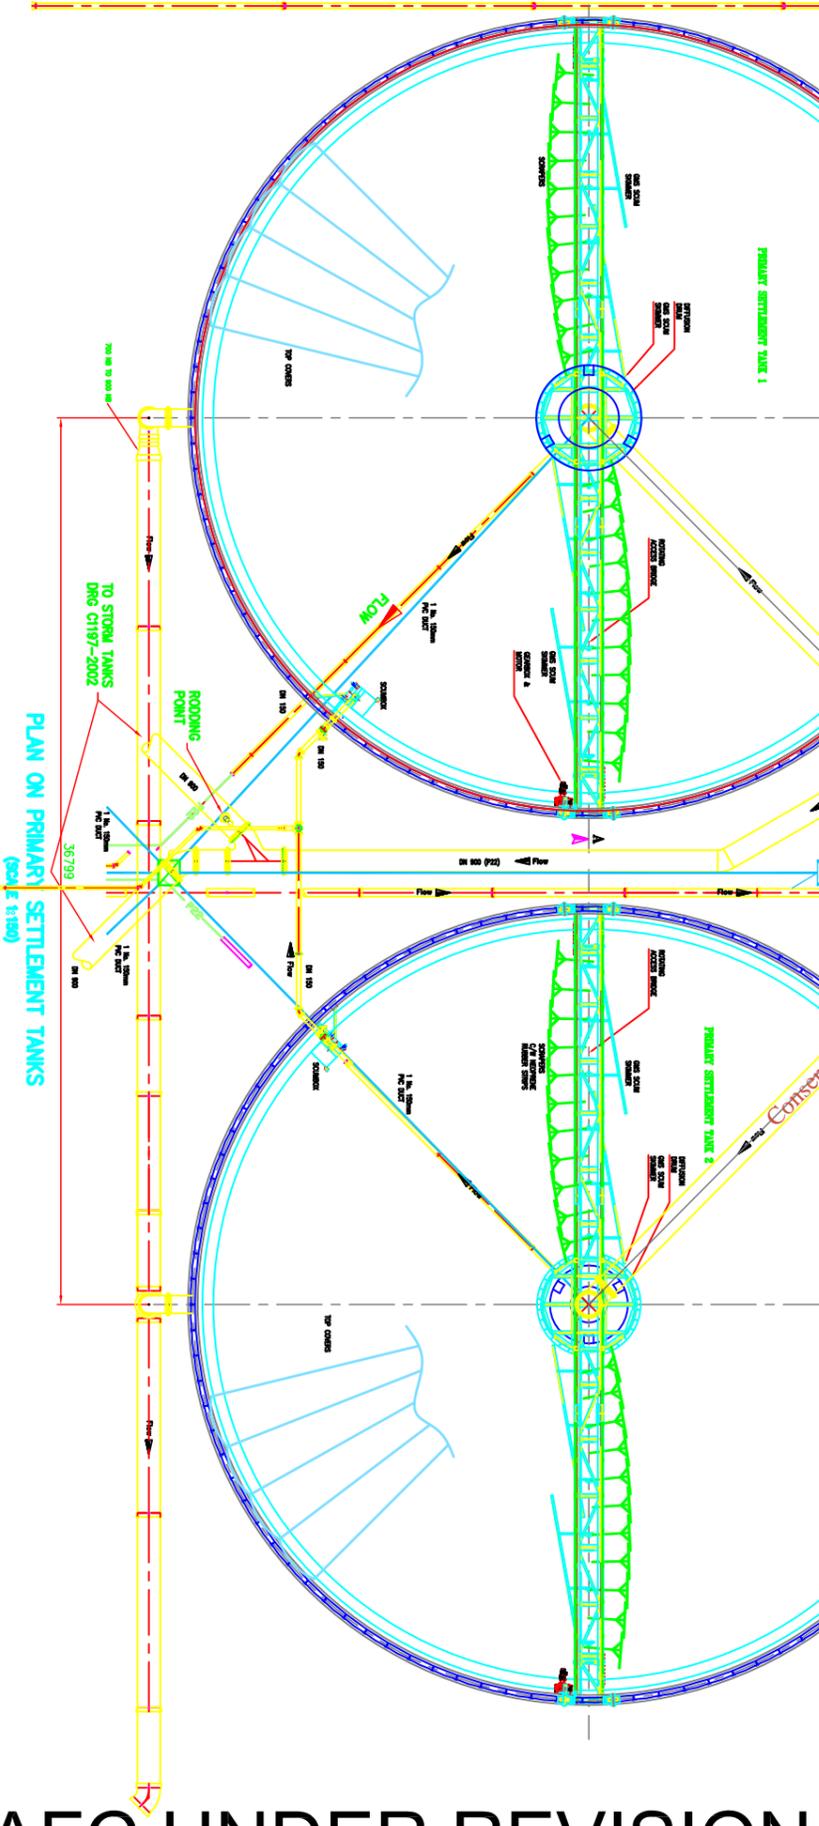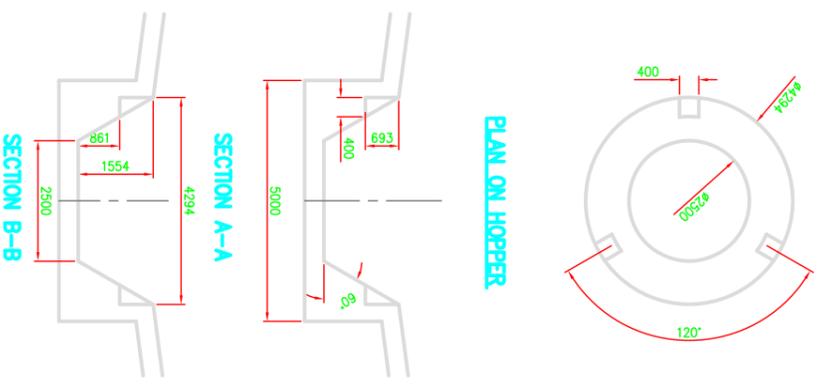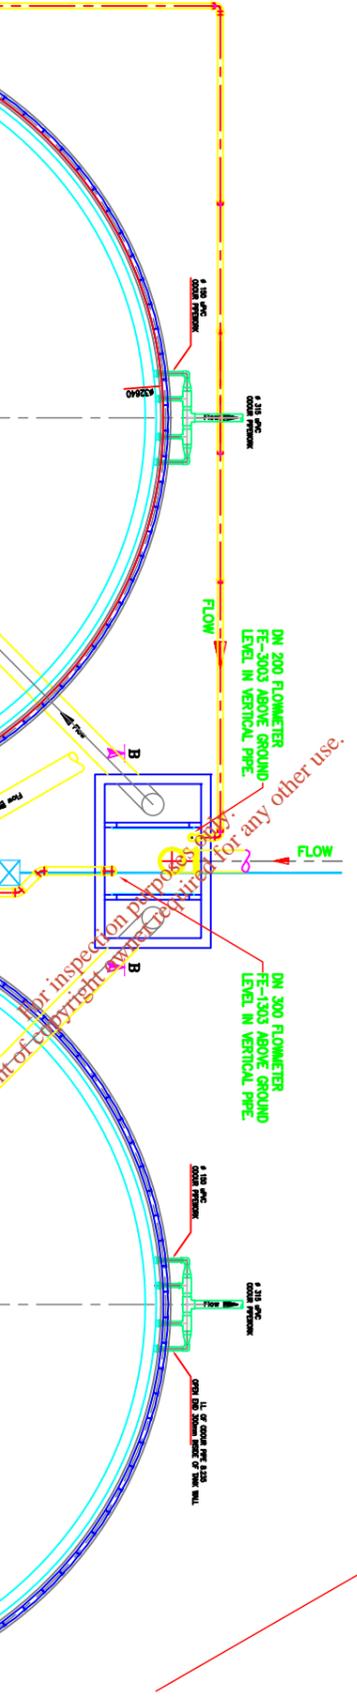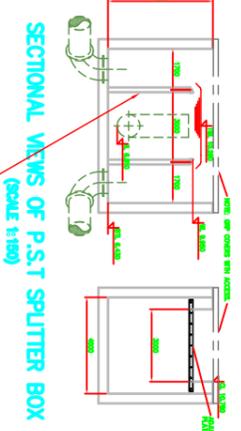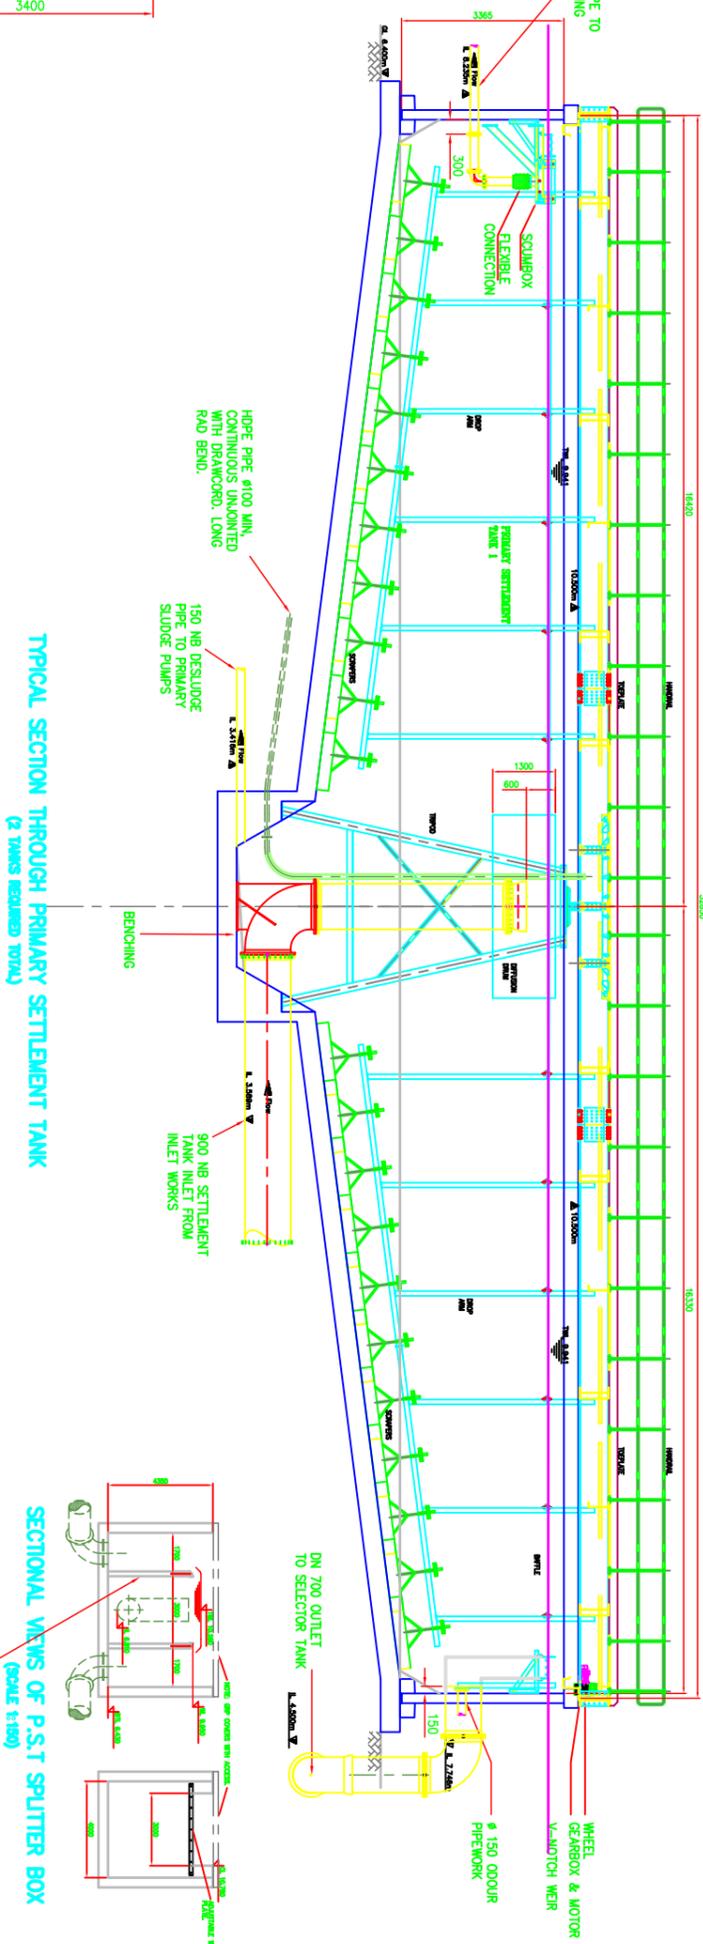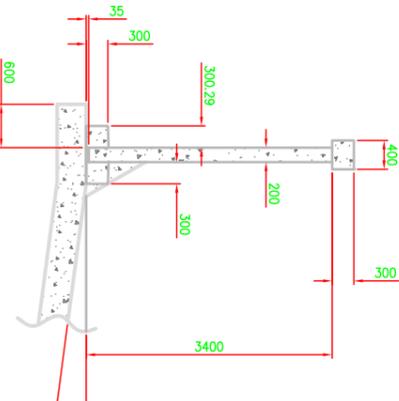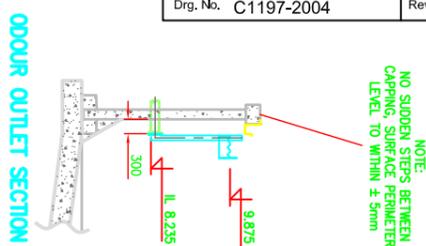

**AFC UNDER REVISION**

APPROVED FOR CIVIL DESIGN  
 REV. 3  
 DATE  
 SIGNATURE

ISSUED APPROVED FOR CONSTRUCTION / SHE 2 REVIEW  
 COMPLETED  
 DATE: 05/11/2007 SIGNATURE: JIMMORION

**A.W.I. CONTRACT No 1002**

**enpure**

Enpure Limited  
 Enpure House  
 Birmingham Road,  
 Kidderminster, DY10 2SH,  
 Tel: +44 (0)1562 820 010  
 Fax: +44 (0)1562 820 008  
 Internet: www.enpure.co.uk


WATERFORD CITY COUNCIL

PRIMARY SETTLEMENT TANKS  
 GENERAL ARRANGEMENTS  
 WATERFORD WWTW

| Date       | Checked        | Approved | Original Size | Original Scale | Rev. |
|------------|----------------|----------|---------------|----------------|------|
| 07/11/2006 | D.J. Tildesley |          | A1            | 1:75           | 3    |

Drg. No. **C1197-2004**

DO NOT SCALE - IF IN DOUBT ASK

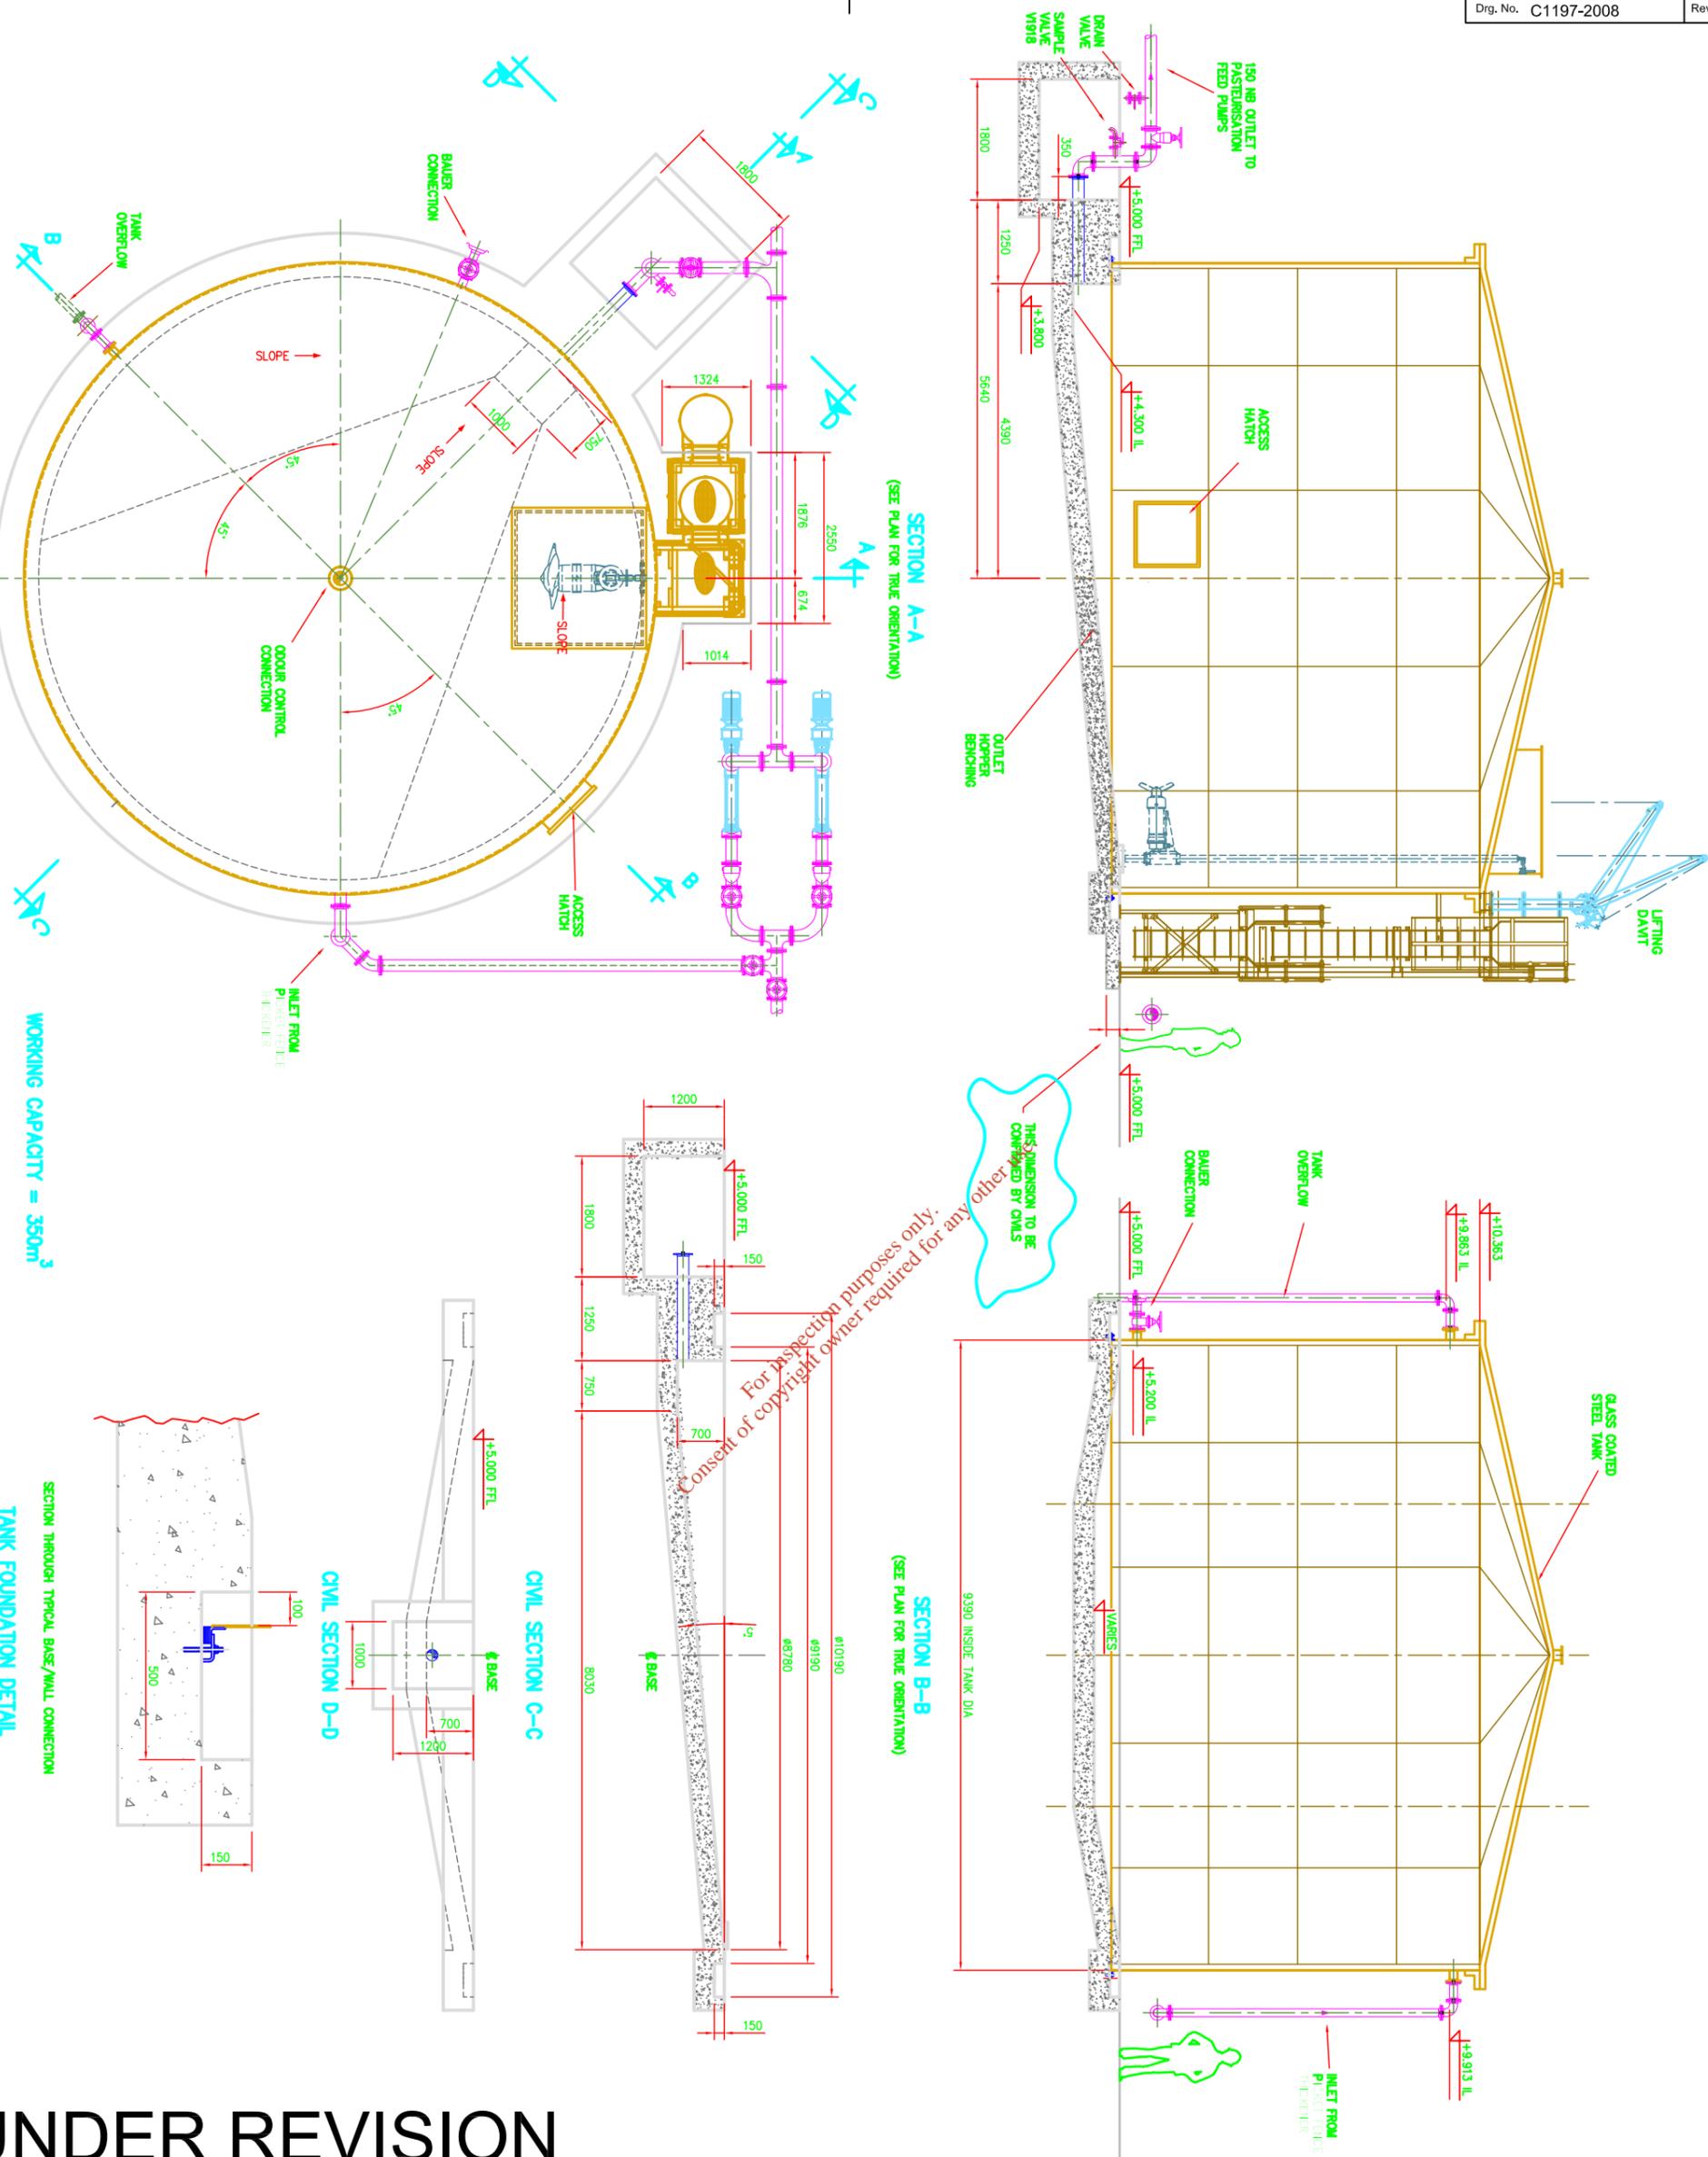

For inspection purposes only.  
Consent of copyright owner required for any other.

**UNDER REVISION**

| See Previous Issues For Past Revision Details |      |                            |
|---|------|----------------------------|
| Rev   | Date | Description                |
| G   |      | SAMPLE VALVE TAG NO. ADDED |

APPROVED FOR CIVIL DESIGN  
REV. G DATE \_\_\_\_\_  
SIGNATURE \_\_\_\_\_

A.W.I. CONTRACT No 1002

enpure



Empure Limited  
Empure House,  
Birmingham Road,  
Kiddeminstor, DY10 2SH,  
UK  
Tel: +44 (0)1562 820 010  
Fax: +44 (0)1562 820 008  
Internet: www.empure.co.uk

All Copyright and Design Right subsisting in this document is the property of Empure Limited of Empure House, Birmingham Road, Kiddeminstor, DY10 2SH, UK. This document and the information contained within it is confidential to Empure Limited and may not be disclosed to any third party without Empure's written consent.


Customer: WATERFORD CITY COUNCIL

Title: EMERGENCY PRIMARY SLUDGE HOLDING TANK (T1903)  
GENERAL ARRANGEMENTS  
WATERFORD WWTTW

| Drawn            | Checked | Approved | Scale       |
|------------------|---------|----------|-------------|
| DJL/Tidesley     |         |          | A1          |
| Date: 07/11/2008 | Date:   | Date:    | Scale: 1:50 |

Dwg. No. C1197-2008

DO NOT SCALE - IF IN DOUBT ASK

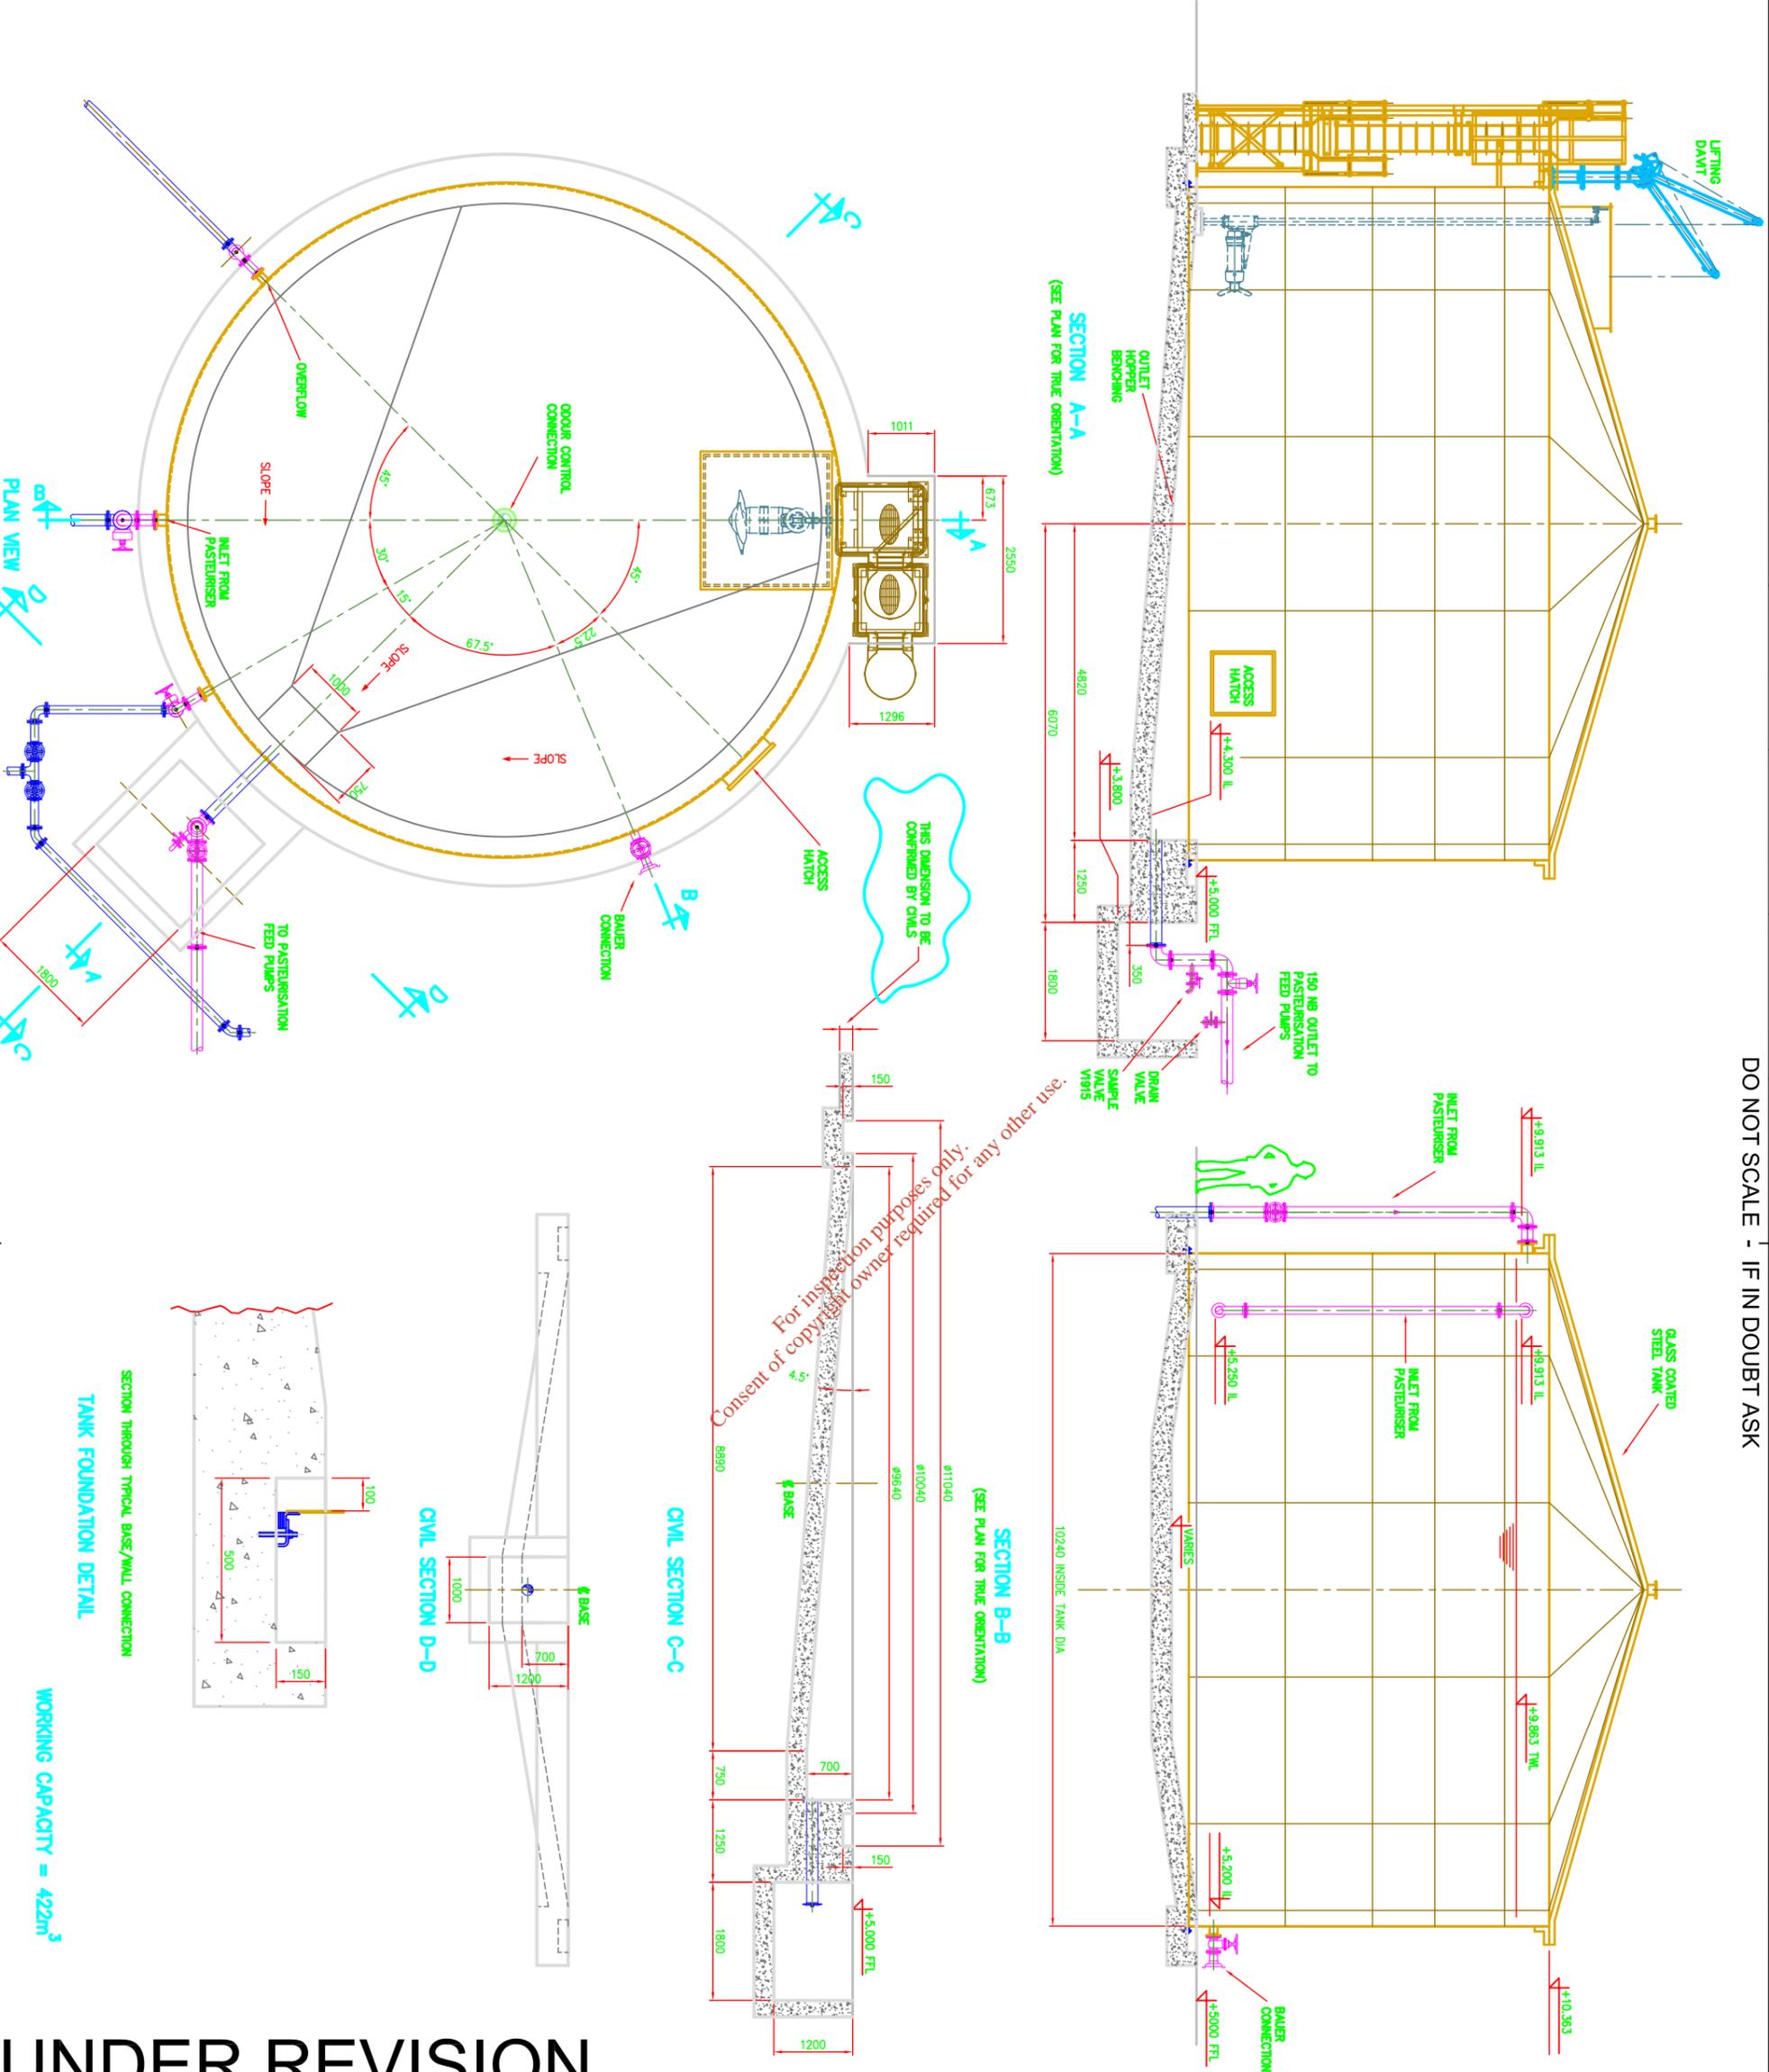

**UNDER REVISION**

| Rev | Date | Description                | Drawn |
|-----|------|----------------------------|-------|
| G   |      | SAMPLE VALVE TAG NO. ADDED | PW    |

See Previous Issues For Past Revision Details

APPROVED FOR CIVIL DESIGN  
 REV. G DATE  
 SIGNATURE

A.W.I. CONTRACT No 1002

enpure



Empure Limited  
 Empure House,  
 Birmingham Road,  
 Kidderminster, DY11 2SH,  
 UK  
 Tel: +44 (0)1562 820 010  
 Fax: +44 (0)1562 820 008  
 Internet: WWW.EMPURE.CO.UK


Customer: WATERFORD CITY COUNCIL  
 Title: EMERGENCY SECONDARY SLUDGE HOLDING TANK (T1902) GENERAL ARRANGEMENTS  
 WATERFORD WWTTW

| Date       | Checked | Approved | Scale |
|------------|---------|----------|-------|
| 07/11/2008 |         |          | 1:50  |

Proj. No. C1197-2009



DO NOT SCALE - IF IN DOUBT ASK

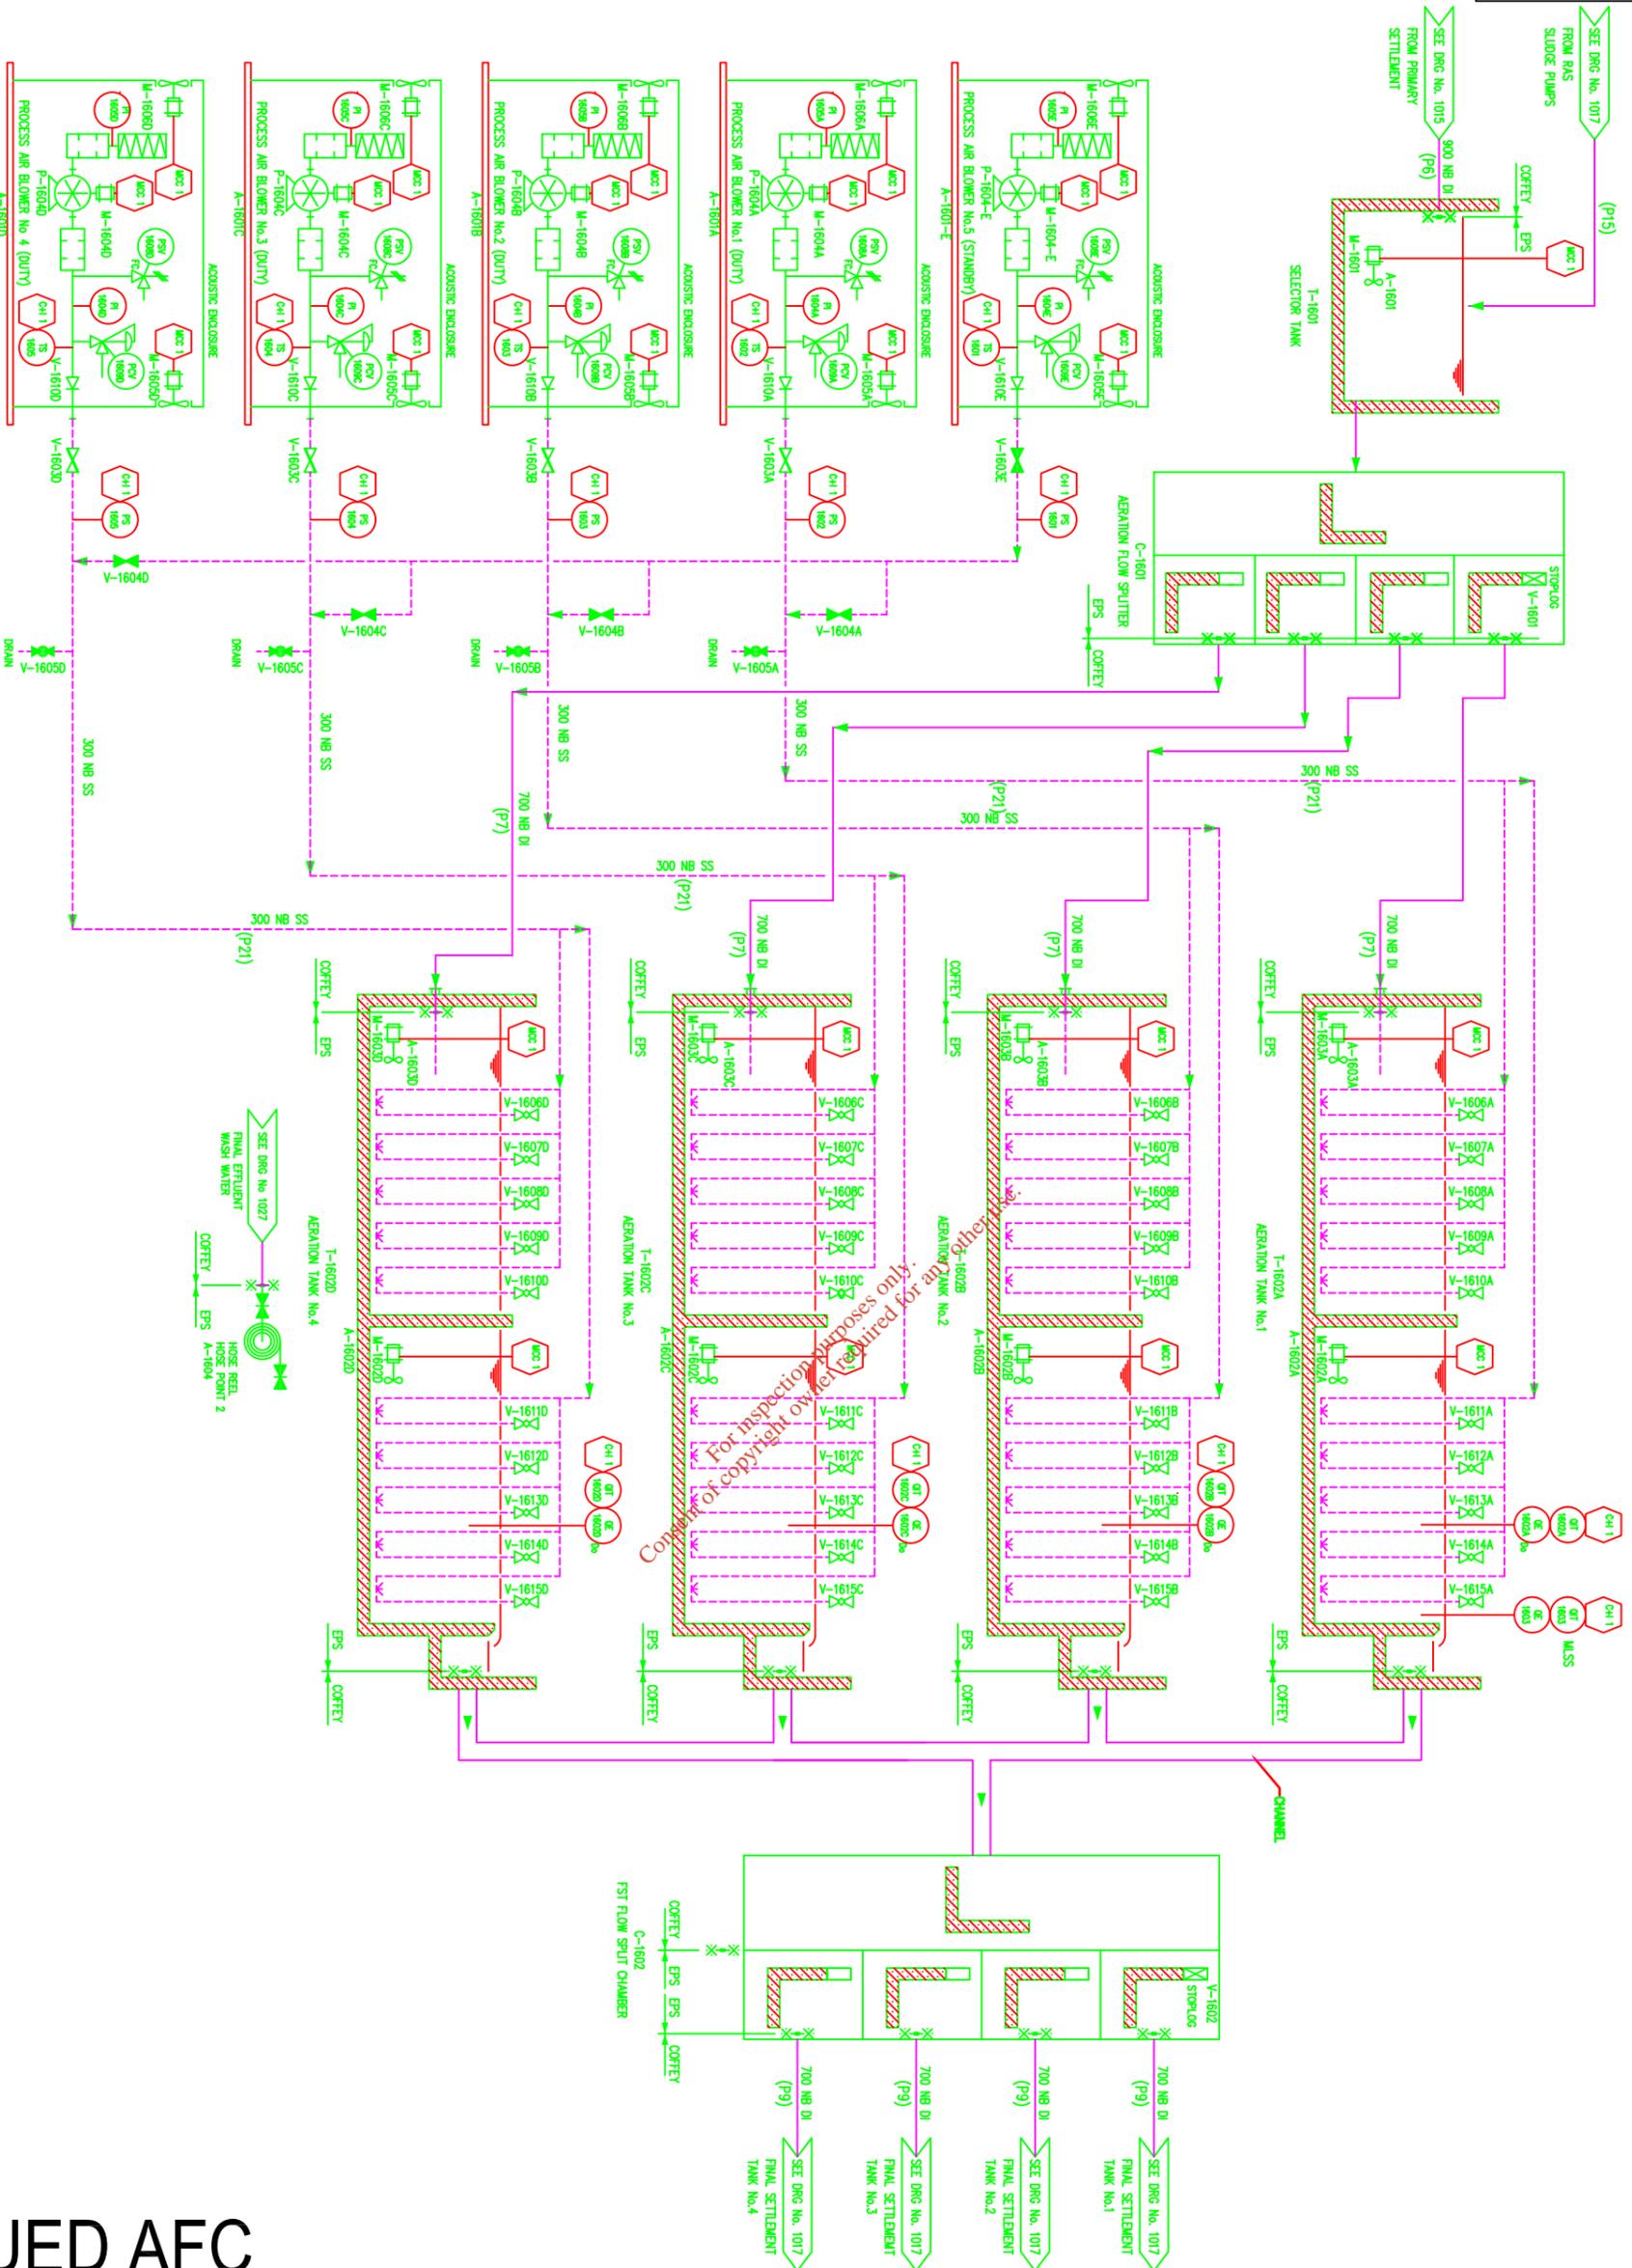

- NOTES**
- 1. REMOVED
  - 2. REMOVED
  - 3. REMOVED

**LEGEND:**  
 NEW PIPEWORK/CHANNEL BY CIVILS CONTRACTOR.  
 NEW PIPEWORK BY M&E CONTRACTOR.

|                    |                  |
|--------------------|------------------|
| PROCESS ENG. DGH   | PROJECT MAN. CGP |
| PROJECT ENG. JMN   | MECH ENG MAN. BM |
| LEAD MECH ENG. JAM | ELEC ENG MAN. JL |
| LEAD ELEC ENG. AMT |                  |

**A.W.I. CONTRACT No 1002**



Empure Limited  
 Empire House,  
 Birmingham Road,  
 Birmingham, B11 0 2SH,  
 UK  
 Tel: +44 (0)1562 820 010  
 Fax: +44 (0)1562 820 008  
 Internet: www.empure.co.uk

Customer: WATERFORD CITY COUNCIL  
 Title: AERATION TANKS P & I DIAGRAM  
 WATERFORD WWTTW


|                    |                   |                     |                     |
|--------------------|-------------------|---------------------|---------------------|
| Drawn: DUTlidesley | Checked: RUMiller | Approved: RAlweahin | Original Size: A1   |
| Date: 20/10/2008   | Date: 26/06/2008  | Date: 27/06/2008    | Original Scale: NTS |

**ISSUED AFC**

Drg. No. C1197-1016

| Rev | Date       | Description                       | Drawn |
|-----|------------|-----------------------------------|-------|
| 1   | 27/06/2008 | TS-1601 to 5 & PS-1601 to 5 ADDED |       |

DO NOT SCALE - IF IN DOUBT ASK

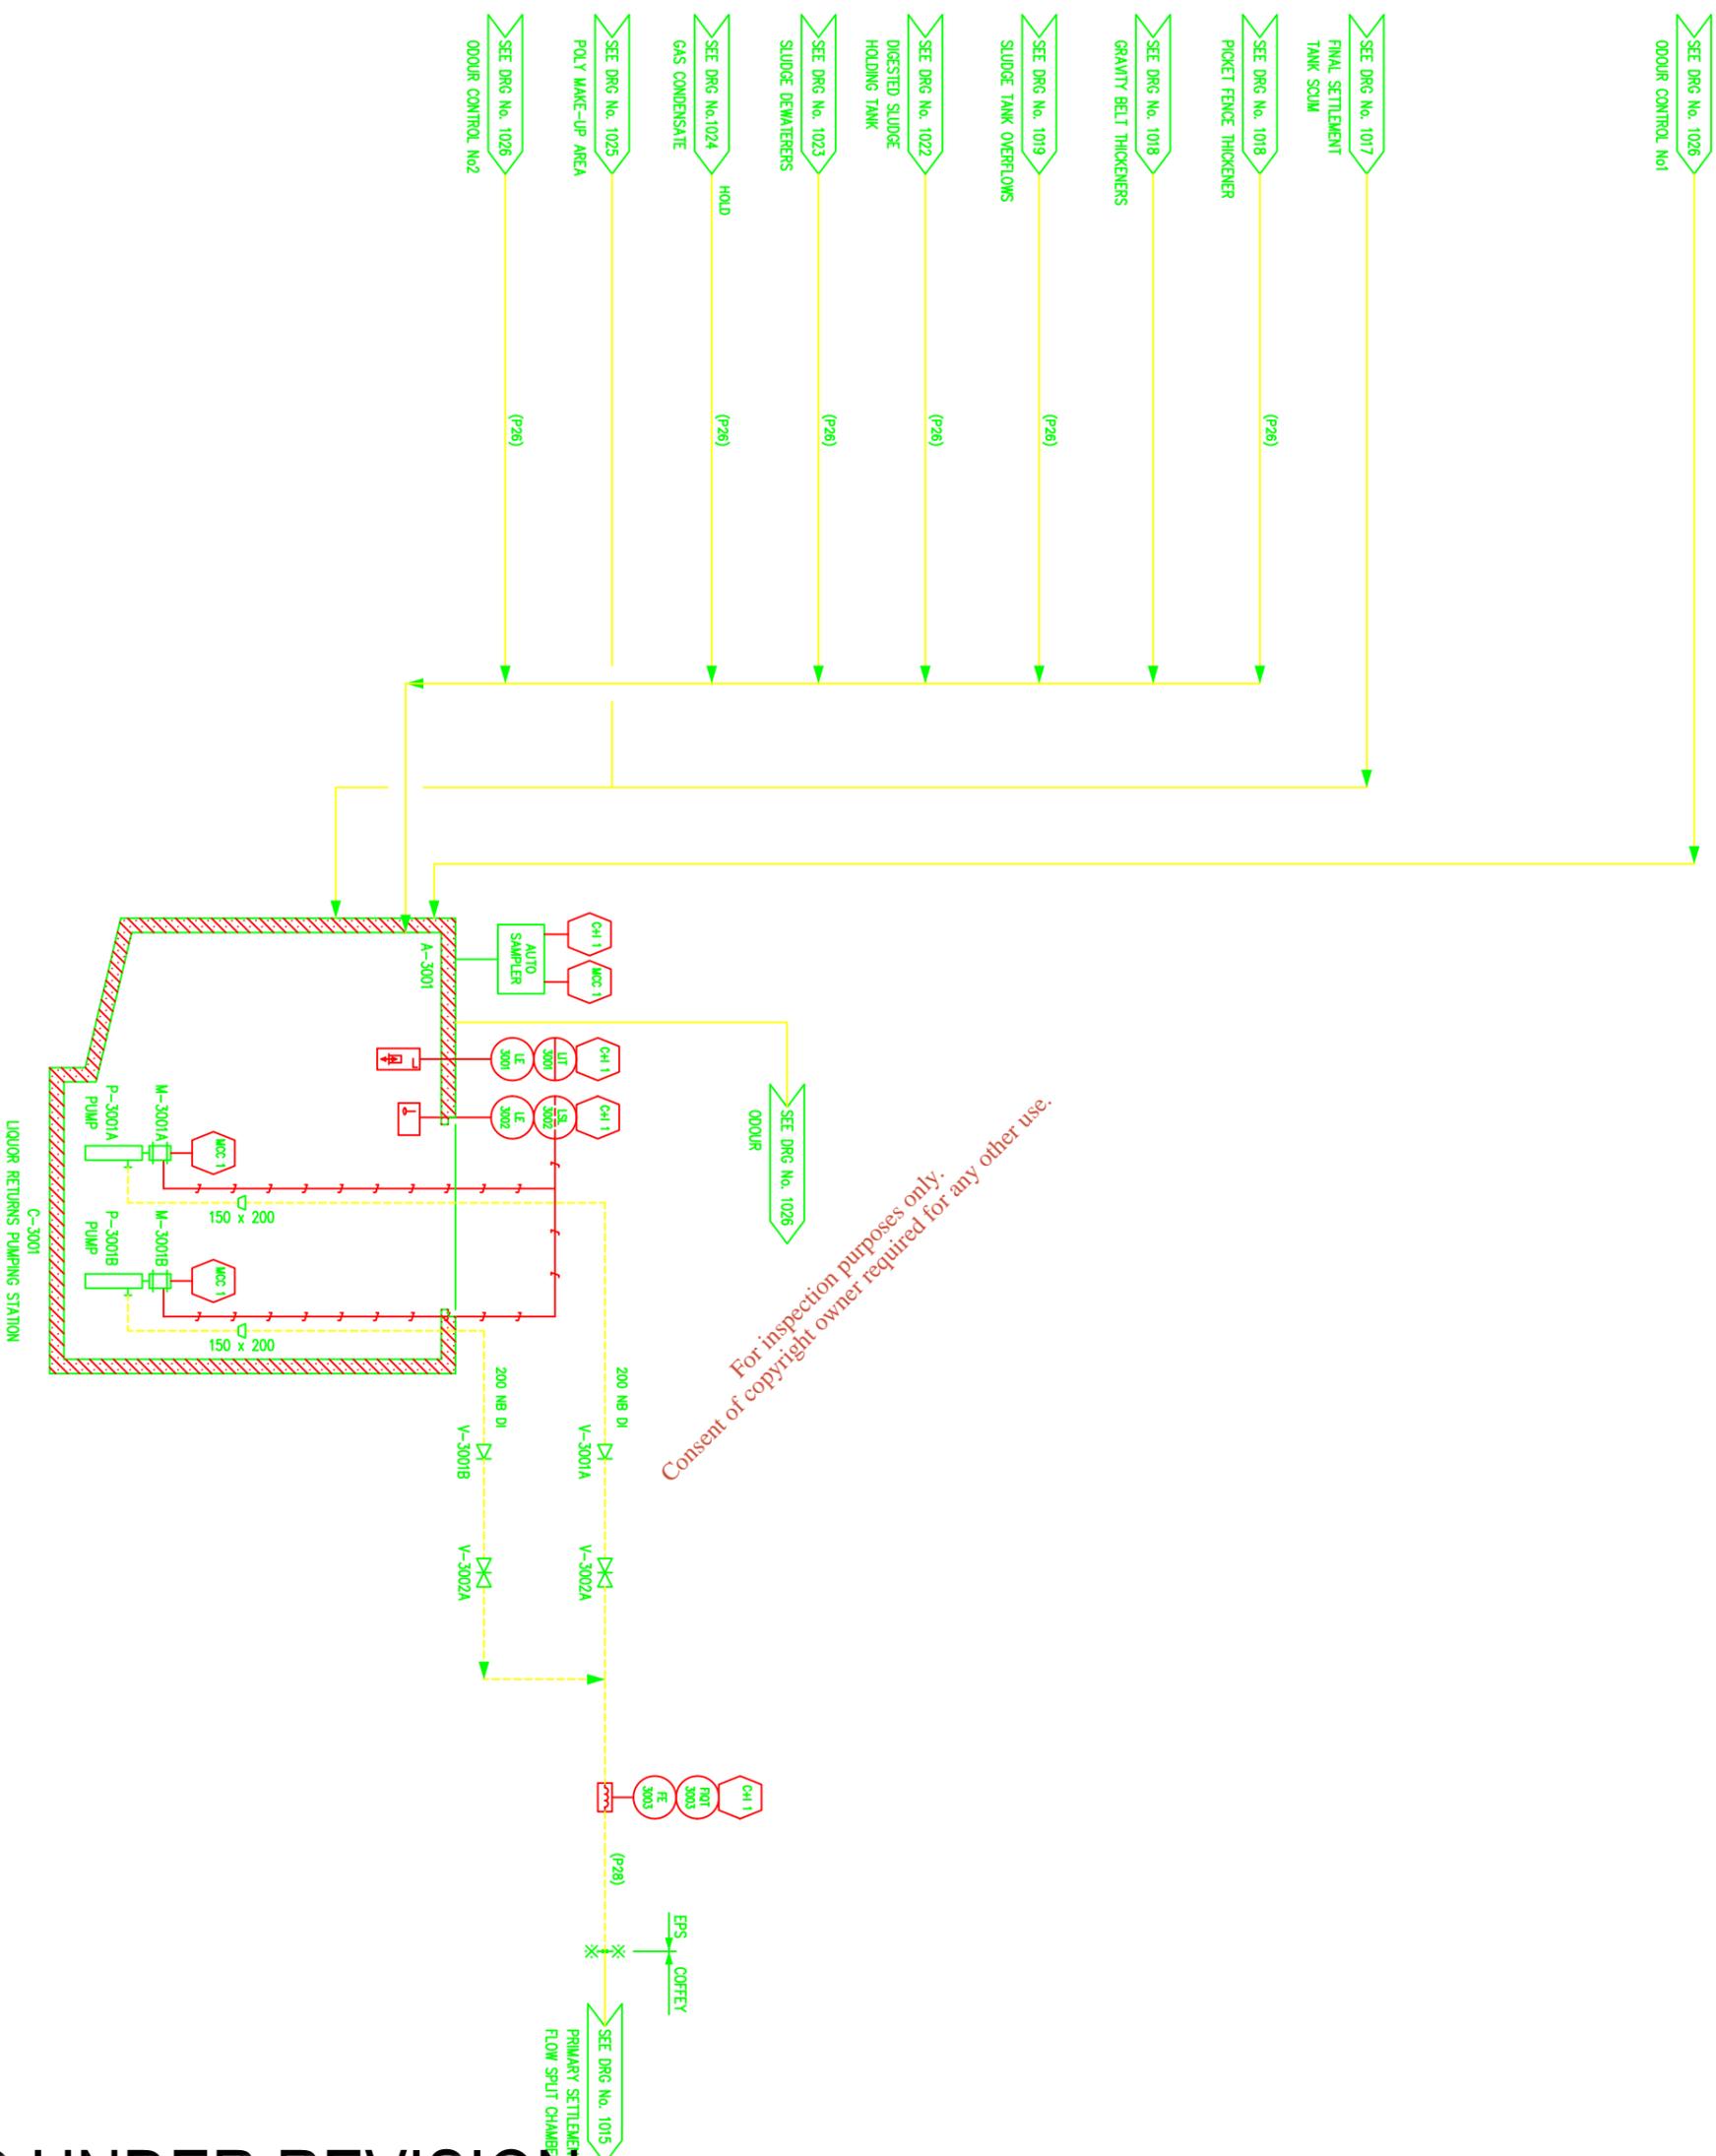

See Previous Issues For Past Revision Details

| Rev | Date | Description                | Drawn |
|-----|------|----------------------------|-------|
| 2   |      | ODOUR CONTROL LINE REMOVED |       |

NOTES  
1. REMOVED  
2. REMOVED

LEGEND:  
NEW PIPEWORK/CHANNEL BY CIVILS CONTRACTOR  
NEW PIPEWORK BY MECH CONTRACTOR

| CHECKED        |     | APPROVED               |     |
|----------------|-----|------------------------|-----|
| PROCESS ENG.   | DGH | PROCESS TECH SPEC/MAN. | DGG |
| PROJECT ENG.   | JMN | PROJECT MAN.           | CGP |
| LEAD MECH ENG. | JAM | MECH ENG MAN.          | BM  |
| LEAD ELEC ENG. | AMT | ELEC ENG MAN.          | JL  |

A.W.I. CONTRACT No 1002

enpure

enpure

enpure

enpure

Empure Limited  
Empire House,  
Berrington Road,  
Kilderminster, DY11 2SH,  
Tel: +44 (0)1562 820 010  
Fax: +44 (0)1562 820 008  
Internet: www.empure.co.uk


Customer: WATERFORD CITY COUNCIL

Title: LIQUOR RETURNS P & I DIAGRAM WATERFORD WWTTW

| Drawn            | Checked | Approved | Original Size       |
|------------------|---------|----------|---------------------|
| DUTTLESLEY       |         |          | A1                  |
| Date: 20/10/2008 | Date:   | Date:    | Original Scale: NTS |

Drg. No. C1197-1030 Rev. 2

AFC UNDER REVISION

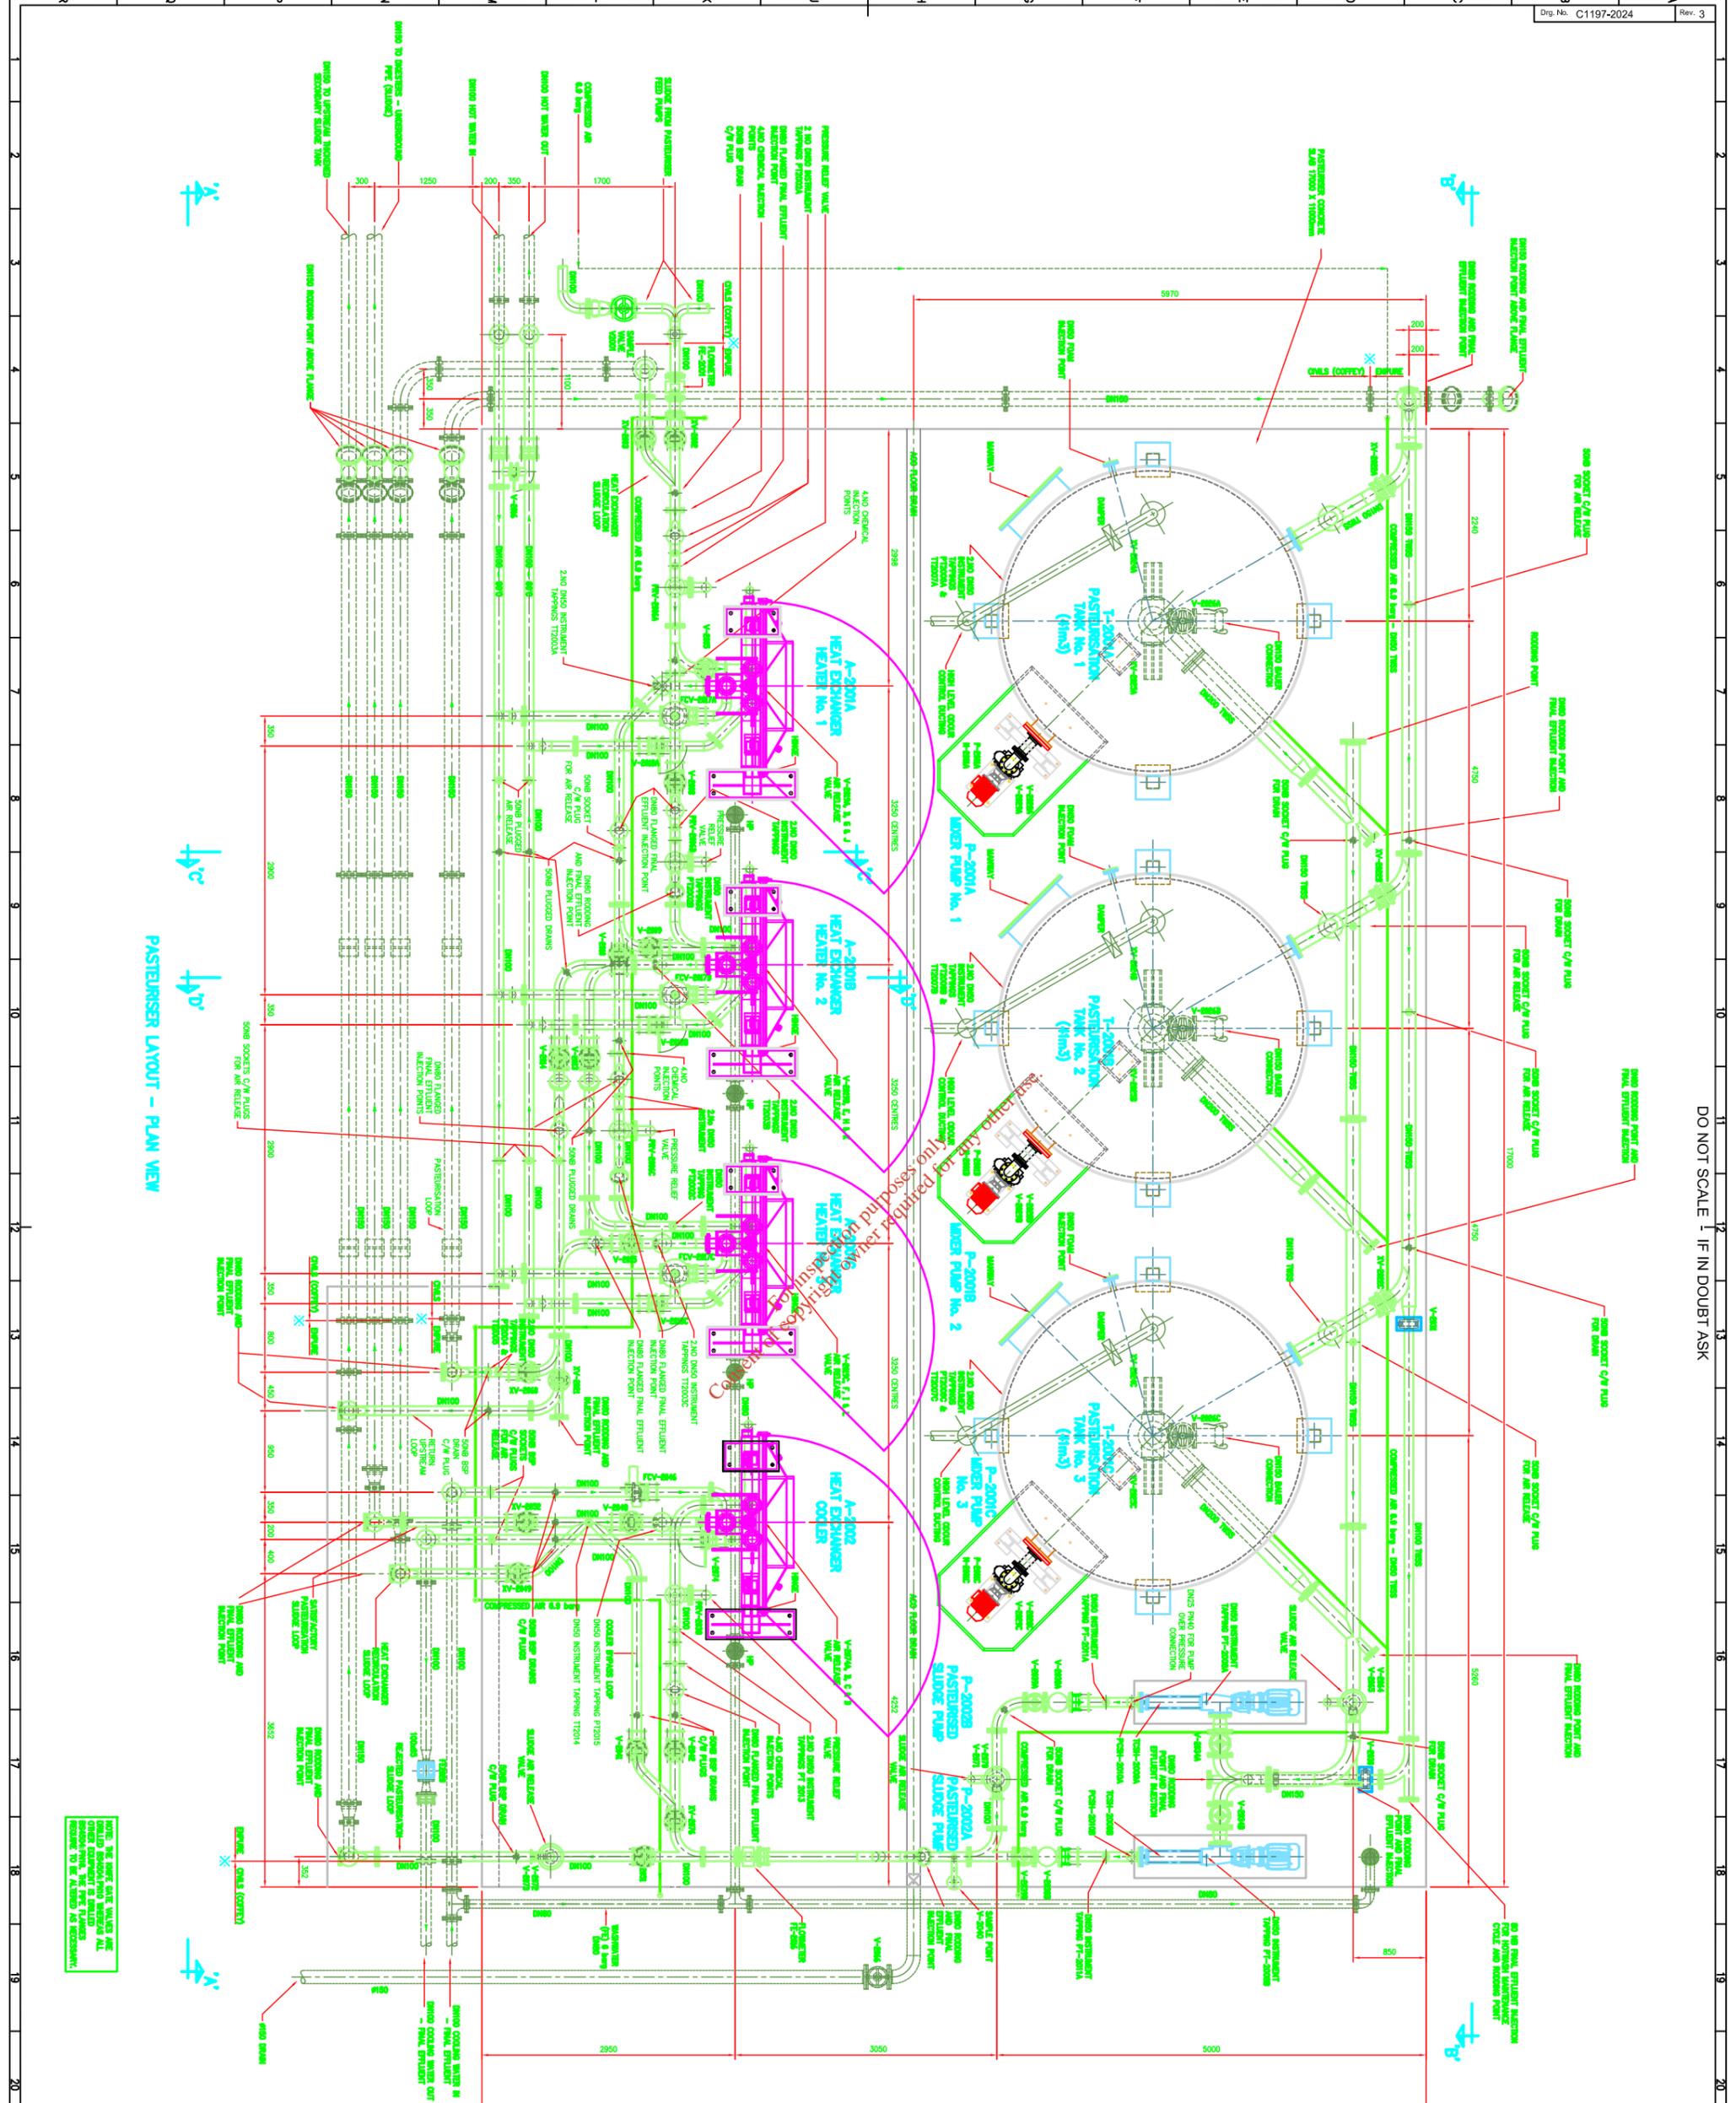

PASTEURISER LAYOUT - PLAN VIEW

DO NOT SCALE 1 IF IN DOUBT ASK

NOTE: THE NAME DATE VALUES ARE  
 ENTERED AUTOMATICALLY AND SHOULD  
 NOT BE CHANGED. THE NAME VALUES  
 SHOULD BE CHANGED AS NECESSARY.


- NOTES
1. ALL PASTEURISER FLAMES SHOULD BE
  2. HEAT EXCHANGERS TO BE INSULATED AT THE HIGHEST POINT OF SLUDGE AND WATER SIDE.
  3. PASTEURISER HEAT EXCHANGER PIPE TO BE COVERED WITH 100mm INSULATION TO PREVENT FROST.



**A.W.I. CONTRACT No 1002**

WATERFORD CITY COUNCIL  
 WATERFORD WWTW  
 PASTEURISER LAYOUT MARK 2  
 PLAN VIEW

Enpire  
 Enpire  
 Enpire

12/06/2007  
 C1197-2024  
 3

Table 07\_4084 3.a(iii) Monitoring, Measuring & Sampling Information Sheet

Rev 4 09.09.08

|                            | Measuring                      | Location   | Measurement Type                      | Description   | Size        | Type    | Pipe Ref | Drawing Ref. | P & ID Ref | Sampling Interval  |
|----------------------------|--------------------------------|--|---------------------------------------|---------------|-------------|---------|----------|--------------|------------|--|
| <b>Primary Treatment</b>   |                                |  |                                       |               |             |         |          |              |            |  |
| 1A                         | Raw Sewage                     | Inlet Channel  | Volumetric                            | Open Flume    | 1m throat   | Arkon   | n/a      | C1197-2000   | C1197-1012 | Continuous   |
| 1C                         | Screened Sewage                | Inlet Channel  | Flow Rate                             | Flume         | 0.6m throat | Arkon   | n/a      | C1197-2000   | C1197-1012 | Continuous   |
| 1B                         | Raw Sewage                     | Inlet Works  | Flow Rate                             | Flowmeter     | 300 NB      | Siemans | P3       | C1197-2000   | C1197-1012 | Continuous   |
| 1A/1B                      | Raw Sewage                     | Inlet Works  | Temperature<br>BOD<br>COD<br>ph<br>SS | Auto Sampler  |             |         | n/a      |              | C1197-1012 | Weekly<br>Monthly<br>Weekly<br>Weekly<br>Weekly              |
| 17                         | Screenings                     | Inlet Works  | % TDS                                 |               |             |         |          |              |            | Spot   |
| 18                         | Grit                           | Inlet Works  | % TDS<br>% VS                         |               |             |         |          |              |            | Spot<br>Spot   |
| 28                         | Inlet air                      | Inlet Works OCU  | H2S                                   | Gas monitor   | TBC         | TBC     |          |              | C1197-1026 | Continuous   |
| 29                         | Outlet air                     | Inlet Works OCU  | H2S                                   | Gas monitor   | TBC         | TBC     |          |              | C1197-1026 | Continuous   |
| 1C                         | Screened Sewage                | Post Grit channel  | Temperature<br>BOD<br>COD<br>SS       | Auto Sampler  |             |         | n/a      | C1197- 2000  | C1197-1012 | Twice weekly<br>Weekly<br>5 times/week (reducing)<br>Weekly  |
| <b>Secondary Treatment</b> |                                |  |                                       |               |             |         |          |              |            |  |
| 4A                         | Storm Return                   | At PST chamber   | Flow Rate                             | Flowmeter     | 300 NB      | Siemans | P27      | C1197-2004   | C1197-1013 | Continuous   |
| 6                          | Storm Overflow                 | After Storm tanks  | Flow Rate                             | Flowmeter     | 900 NB      | Siemans | P8       | C1197-2002   | C1197-1013 | Continuous   |
| 6                          | Storm Overflow                 | After Storm tanks  | BOD                                   | Auto Sampler  |             |         | P8       | C1197-2002   | C1197-1013 | Intermittent   |
| 4                          | Flow to Storm                  | Not measured. Calc. will be made by deducting storm overflow from flow to storm to give storm return for treatment |                                       |               |             |         |          |              |            |  |
|                            |                                |  | SS                                    |               |             |         |          |              |            | Intermittent   |
| 7                          | Settled Sludge (PST to PFT)    | After Primary Pumps  | Flow Rate                             | Flowmeter     | 150 NB      | Siemans | P22      | C1197-3006   | C1197-1018 | Continuous   |
| 7                          | Settled Sludge (PST to PFT)    | At PFT   | % TDS                                 | Manual Sample | 25 NB       | B/valve | P22      | C1197-3006   | C1197-1018 | Intermittent   |
| 5                          | Settled Sewage                 | At Aeration chamber  | Flow Rate                             | Flowmeter     | 900 NB      | Siemans | P6       | C1197-2006   | C1197-1015 | Continuous   |
| 5                          | Settled Sewage                 | At Aeration chamber  | BOD<br>COD<br>ph<br>SS                | Auto Sampler  |             |         | P6       | C1197-2006   | C1197-1015 | Intermittent<br>Intermittent<br>Intermittent<br>Intermittent |
| 8                          | RAS to Aeration Selector Tank  | At Selector Tank   | Flow Rate                             | Flowmeter     | 600 NB      | Siemans | P15      | C1197-2006   | C1197-1017 | Continuous   |
| 21                         | Mixed Liquor                   | On aeration tanks  | DO                                    | DO meter      |             | Siemans |          |              | C1197-1016 | Continuous   |
| 21                         | Mixed Liquor                   | On aeration tanks  | DO                                    | DO meter      |             | Siemans |          |              | C1197-1016 | Continuous   |
| 21                         | Mixed Liquor                   | On aeration tanks  | DO                                    | DO meter      |             | Siemans |          |              | C1197-1016 | Continuous   |
| 21                         | Mixed Liquor                   | On aeration tanks  | DO                                    | DO meter      |             | Siemans |          |              | C1197-1016 | Continuous   |
| 21                         | Mixed Liquor                   | On aeration tanks  | ph                                    |               |             |         |          |              |            | Weekly   |
| 21                         | Mixed Liquor                   | On aeration tanks  | SS                                    |               |             |         |          |              |            | 5 times per week   |
| 21                         | Mixed Liquor                   | On aeration tanks  | SSV                                   |               |             |         |          |              |            | Twice Weekly   |
| 21                         | Mixed Liquor                   | On aeration tanks  | SSI                                   |               |             |         |          |              |            | Twice Weekly   |
| 21                         | Mixed Liquor                   | On aeration tanks  | Microscopic Exam                      |               |             |         |          |              |            | Weekly   |
| 22                         | Aerated sewage                 | On aeration tanks  | MLSS                                  | MLSS meter    |             | Siemans |          |              | C1197-1016 | Continuous   |
| 2                          | Secondary Effluent             | Pre. FE Chamber  | Flow Rate                             | Flowmeter     | 900 NB      | Siemans | P12      | C1197-2020   | C1197-1027 | Continuous   |
| 2                          | Secondary Effluent             | FE Chamber   | BOD<br>COD<br>ph<br>SS                | Auto Sampler  |             |         | n/a      | C1197-2020   | C1197-1027 | Weekly<br>5 times/week (reducing)<br>5 times/week (reducing) |
| <b>Sludge Treatment</b>    |                                |  |                                       |               |             |         |          |              |            |  |
| 9                          | SAS To Gravity Belt Thickeners | Sludge Building  | Flow Rate                             | Flowmeter     | 150 NB      | Siemans | P16      | C1197-3006   | C1197-1018 | Continuous   |
| 9                          | SAS To Gravity Belt Thickeners | Sludge Building  | % TDS                                 | Manual Sample | 25NB        | B/valve | P16      | C1197-3006   | C1197-1018 | Intermittent   |
| 10                         | GBT to Sludge Blend Tank       | At S/Blend Tank  | Flow Rate                             | Flowmeter     | 100 NB      | Siemans | P19      | C1197-3006   | C1197-1018 | Continuous   |

|    |                                       |   |  |               |        |         |     |            |            |  |
|----|---------------------------------------|---|--|---------------|--------|---------|-----|------------|------------|--|
| 10 | GBT to Sludge Blend Tank              | At S/Blend Tank                                   | % TDS  | Manual Sample | 25NB   | B/valve | P19 | C1197-2010 | C1197-1019 | Intermittent   |
| 23 | Thickened Secondary Sludge            | Outlet of emergency secondary sludge holding tank | As Required  | Manual Sample | 50 NB  | B/valve |     | C1197-2009 | C1197-1019 | Spot   |
| 24 | Thickened Primary Sludge              | Outlet of emergency primary sludge holding tank   | As Required  | Manual Sample | 50 NB  | B/valve |     | C1197-2008 | C1197-1019 | Spot   |
| 25 | Thckened Primary Sludge               | After PFT   | % TDS  | Manual Sample | 50 NB  | B/valve | P25 | C1197-2007 | C1197-1018 | Spot   |
| 11 | RTN Liquor to PST Splitter            | At Splitter                                       | Flow Rate  | Flowmeter     | 200 NB | Siemans | P28 | C1197-2004 | C1197-1030 | Intermittent   |
| 11 | Return Liquors                        | At liquor chamber                                 | BOD<br>COD<br>SS   | Manual Sample |        |         | n/a | C1197-2018 | C1197-1030 | Intermittent<br>Intermittent<br>Intermittent   |
| 12 | Blended Sludge to Pasteuriser         | P/riser Skid                                      | Flow Rate  | Flowmeter     | 100 NB | Siemans | P40 | C1197-2024 | C1197-1020 | Continuous   |
| 12 | Blended Sludge to Pasteuriser         | P/riser Skid                                      | ph<br>Alk (mg CaCO3/l)<br>% TDS<br>% VS  | Manual Sample | 50mm   | B/valve | P40 | C1197-2010 | C1197-1019 | Monthly<br>Monthly<br>Weekly<br>Monthly  |
| 32 | Return from Cooler                    | Pasteuriser slab                                  | Flow rate  | Flow meter    | 65 NB  | Siemans | P32 | C1197-2024 | C1197-1020 | Continuous   |
| 33 | Pasteurised Sludge                    | Pasteuriser slab                                  | ph<br>Alkalinity<br>% TDS<br>% VS  | Manual Sample | 50 NB  | B/valve | P41 | C1197-2024 | C1197-1020 | Spot<br>Spot<br>Spot<br>Spot   |
| 13 | Digested Sludge to Dewaterer          | Sludge Building                                   | Flow Rate  | Flowmeter     | 150 NB | Siemans | P46 | C1197-3006 | C1197-1023 | Intermittent   |
| 13 | Digested Sludge to Dewaterer          | Sludge Building                                   | Flow Rate  | Flowmeter     | 150 NB | Siemans | P46 | C1197-3006 | C1197-1023 | Intermittent   |
| 13 | Digested Sludge to Dewaterer          | Digested Sludge Tank Outlet                       | % TDS<br>% VS  | Manual Sample | 50 NB  | B/valve | P20 | C1197-2014 | C1197-1022 | Intermittent<br>Intermittent   |
| 26 | Stored Digested Sludge to Dewaterer 1 | After dewaterer feed pump 1                       | As Required  | Manual Sample | 50 NB  | B/valve | P46 | C1197-2014 | C1197-1022 | Spot   |
| 27 | Stored Digested Sludge to dewaterer 2 | After dewaterer feed pump 2                       | As Required  | Manual Sample | 50 NB  | B/valve | P46 | C1197-2014 | C1197-1022 | Spot   |
| 30 | Inlet air                             | Sludge OCU  | H2S  | Gas monitor   | TBC    | TBC     |     |            | C1197-1026 | Continuous   |
| 31 | Outlet air                            | Sludge OCU  | H2S  | Gas monitor   | TBC    | TBC     |     |            | C1197-1026 | Continuous   |
| 34 | Liquor from GBT 1                     | Sludge Building                                   | pH   | Manual Sample | 25 NB  | B/valve |     |            | C1197-1018 | Spot   |
| 35 | Liquor from GBT 1                     | Sludge Building                                   | pH   | Manual Sample | 25 NB  | B/valve |     |            | C1197-1018 | Spot   |
| 20 | Potable Water                         | Pre Site Storage                                  | Flow Rate  | Flowmeter     |        |         |     |            |            | Continuous   |
| 3  | Final Effluent                        |   | Flow Rate  |               |        |         |     |            |            | Continuous   |
| 3  | Final Effluent                        | FE Chamber  | BOD<br>COD<br>ph<br>SS   | Auto Sampler  |        |         | n/a | C1197-2020 | C1197-1027 | Intermittent<br>Intermittent<br>Intermittent<br>Intermittent   |
| 14 | Final Sludge Product                  | access road                                       | Weight   | Weighbridge   |        |         |     | C1197-3002 | C1197-1023 | Intermittent   |
| 14 | Final Sludge Product                  | Discharge to skip                                 | Nitrogen<br>Phosphorous<br>Potassium<br>Temperature<br>% TDS<br>% VS<br>Dry Solids<br>Heavy Metals<br>Faecal Coliforms | Manual Sample | 150 NB | B/valve |     | C1197-2011 | C1197-1023 | Occasional<br>Occasional<br>Occasional<br>5 times per week<br>5 times per week<br>Weekly<br>5 times per week<br>Occasional<br>5 times per week |
| 14 | Final Sludge Product                  | Discharge to skip                                 | Nitrogen<br>Phosphorous<br>Potassium   | Manual Sample | 150 NB | B/valve |     | C1197-2011 | C1197-1023 | Occasional<br>Occasional<br>Occasional   |

|                  |                              |                  |  |               |       |         |     |            |            |  |
|------------------|------------------------------|------------------|--|---------------|-------|---------|-----|------------|------------|--|
|                  |                              |                  | Temperature<br>% TDS<br>% VS<br>Dry Solids<br>Heavy Metals<br>Faecal Coliforms |               |       |         |     |            |            | 5 times per week<br>5 times per week<br>Weekly<br>5 times per week<br>Occasional<br>5 times per week |
| 30               | Inlet air                    | Sludge OCU       | H2S  | Gas monitor   | TBC   | TBC     |     |            | C1197-1026 | Continuous   |
| 31               | Outlet air                   | Sludge OCU       | H2S  | Gas monitor   | TBC   | TBC     |     |            | C1197-1026 | Continuous   |
| 32               | Return from Cooler           | Pasteuriser slab | Flow rate  | Flow meter    | 65 NB | Siemans | P32 | C1197-2024 | C1197-1020 | Continuous   |
| 33               | Pasteurised Sludge           | Pasteuriser slab | ph<br>Alkalinity<br>% TDS<br>% VS  | Manual Sample | 50 NB | B/valve | P41 | C1197-2024 | C1197-1020 | Spot<br>Spot<br>Spot<br>Spot   |
| <b>Utilities</b> |                              |                  |  |               |       |         |     |            |            |  |
| 19               | Polymer Usage                | Sludge Building  |  |               |       |         |     |            |            | Intermittent   |
| 19A              | Mixed Polymer to GBT 1802A   | Sludge Building  | Flow Rate  | Flowmeter     | 50 NB |         |     | C1197-2011 | C1197-1018 | Continuous   |
| 19A              | Mixed Polymer to GBT 1802B   | Sludge Building  | Flow Rate  | Flowmeter     | 50 NB |         |     | C1197-2011 | C1197-1018 | Continuous   |
| 19B              | Mixed Polymer to dewaterer 1 | Sludge Building  | Flow Rate  | Flowmeter     |       |         |     | C1197-2011 | C1197-1023 | Continuous   |
| 19B              | Mixed Polymer to dewaterer 2 | Sludge Building  | Flow Rate  | Flowmeter     |       |         |     | C1197-2011 | C1197-1023 | Continuous   |

For inspection purposes only.  
Consent of copyright owner required for any other use.



|   |           |                                     |                              |                |
|---|-----------|-------------------------------------|------------------------------|----------------|
| <b>PURAC</b>  |           |                                     | <b>Project-Specific Data</b> |                |
| <b>IBA Plant Design</b>   |           |                                     | Document Ref                 | 8405           |
| Standard Process Calculation: Project-specific data input is permitted to highlight areas only. |           |                                     | Project No                   | C1197          |
| Calc Ref:   | PCS001    | Rev                                 | Process area code            |                |
| Author  | D Garnett | Refer to PCS index for full details | Tag No(s)                    |                |
| Calculation status:   |           |                                     | Process Engineer             | Dave Hemmings  |
|   |           |                                     | Date                         | 13th July 2005 |

**Inlet Data**

**Year 2005**

Dry Weather Flow, l/s  
Average Daily Flow, l/s  
Peak Flow For Biological Treatment, l/s

| Raw Sewage | Return Liquors | Total Flow |
|------------|----------------|------------|
| 196.7      | 12.3           | 209.0      |
| 255.7      | 21.3           | 277.0      |
| 590.0      | 21.3           | 611.3      |

From 8000-Design Basis +  
8050 Flow Diagram

**Year 2025 (Tender)**

Dry Weather Flow, l/s  
Average Daily Flow, l/s  
Peak Flow For Biological Treatment, l/s

| Raw Sewage | Return Liquors | Total Flow |
|------------|----------------|------------|
| 317.9      | 28.0           | 345.9      |
| 413.2      | 28.0           | 441.3      |
| 953.6      | 28.0           | 981.7      |

From 8000-Design Basis +  
8050 Flow Diagram

**Year 2025**

Dry Weather Flow, l/s  
Average Daily Flow, l/s  
Peak Flow For Biological Treatment, l/s

| Raw Sewage | Return Liquors | Total Flow |
|------------|----------------|------------|
| 317.9      | 28.0           | 345.9      |
| 413.2      | 28.0           | 441.3      |
| 953.6      | 28.0           | 981.7      |

From 8000-Design Basis +  
8050 Flow Diagram

|  | Raw Load<br>kg/d | RL's<br>kg/d | Load to PST<br>kg/d | Concentration, mg/l |              |
|--|------------------|--------------|---------------------|---------------------|--------------|
|  |                  |              |                     | Raw @DWF            | Raw+RLs @DWF |
| Average Daily BOD5 Load 2005                 | 6654             | 993.0        | 7647                | 346                 | 320          |
| Average Daily BOD5 Load 2025                 | 11436            | 1035.0       | 12471               | 349                 | 327          |
| Average Daily BOD5 Load 2025                 | 13724            | 1035.0       | 14759               | 413                 | 387          |
| Average Daily SS Load 2005                   | 4378             | 1163.0       | 5531                | 250                 | 231          |
| Average Daily SS Load 2025                   | 8005             | 1227.0       | 9232                | 259                 | 242          |
| Average Daily SS Load 2025                   | 9606             | 1227.0       | 10833               | 303                 | 284          |
| Average Daily TKN Load 2005                  |                  |              | 0                   | 0                   | 0            |
| Average Daily TKN Load 2025                  |                  |              | 0                   | 0                   | 0            |
| Average Daily TKN Load 2025                  |                  |              | 0                   | 0                   | 0            |
| Average Daily TN Load 2005                   |                  |              | 0                   | 0                   | 0            |
| Average Daily TN Load 2025                   |                  |              | 0                   | 0                   | 0            |
| Average Daily TN Load 2025                   |                  |              | 0                   | 0                   | 0            |
| Average Daily NH3 Load 2005                  | 1066             | 135.0        | 1201                | 54                  | 50           |
| Average Daily NH3 Load 2025                  | 1217             | 135.0        | 1352                | 38                  | 35           |
| Average Daily NH3 Load 2025                  | 1461             | 135.0        | 1596                | 45                  | 42           |
| Average Daily TP Load 2005                   |                  |              | 0                   | 0                   | 0            |
| Average Daily TP Load 2025                   |                  |              | 0                   | 0                   | 0            |
| Average Daily TP Load 2025                   |                  |              | 0                   | 0                   | 0            |
| Percentage Volatile Solids                   | %                |              |                     | 70                  |              |
| Percentage Volatile Solids in settled sewage | %                |              |                     | 80                  |              |
| Percentage Soluble BOD in raw sewage         | %                |              |                     | 30                  |              |
| Percentage Soluble BOD in return liquors     | %                |              |                     | 80                  |              |
| TKN:BOD Ratio                                |                  |              |                     | 0.0                 |              |
| Are return liquors sent to ASP or inlet      |                  |              |                     |                     | Inlet        |

DGHemmings:  
+20% extra load

DGHemmings:  
+20% extra load

DGHemmings:  
+20% extra load

For inspection purposes only. Consent of copyright owner required for all other uses.

| Effluent Consent Standard                |                        |                         | Average | 95 % 'ile     |      |               |       |
|--|------------------------|-------------------------|---------|---------------|------|---------------|-------|
| COD                                      | From 8000-Design Basis | mg/l                    | 62.5    | 125           |      |               |       |
| BOD                                      | From 8000-Design Basis | mg/l                    | 12.5    | 25            |      |               |       |
| SS                                       | From 8000-Design Basis | mg/l                    | 17.5    | 35            |      |               |       |
| NH3                                      |                        | mg/l                    | N/A     | #VALUE!       |      |               |       |
| TN                                       |                        |                         | N/A     | #VALUE!       |      |               |       |
| P  |                        |                         | N/A     | #VALUE!       |      |               |       |
| <b>Primary Tanks</b>                     |                        |                         |         |               |      |               |       |
| No. of Tanks                             |                        |                         | 2       |               |      |               |       |
| SS Removal Efficiency (max)              | %                      |                         | 60      | From 8403-PST |      |               |       |
| SS Removal Efficiency (min)              | %                      |                         | 55      | From 8403-PST |      |               |       |
| BOD5 Removal Efficiency (max)            | %                      |                         | 30      | From 8403-PST |      |               |       |
| BOD5 Removal Efficiency (min)            | %                      |                         | 25      | From 8403-PST |      |               |       |
| TKN/TN Removal Efficiency (max)          | %                      |                         | 0       |               |      |               |       |
| TKN/TN Removal Efficiency (min)          | %                      |                         | 0       |               |      |               |       |
| N-NH4 Removal Efficiency (max)           | %                      |                         | 0       |               |      |               |       |
| N-NH4 Removal Efficiency (min)           | %                      |                         | 0       |               |      |               |       |
| <b>Primary Sludge Production</b>         |                        |                         |         |               |      |               |       |
|  |                        | Sludge Production, m3/d |         |               |      |               |       |
| Percentage Dry Solids                    | %                      | 1.5                     | 2       | 3             | 5    |               |       |
| Max Removal in year 2005                 | kg/d                   | 3318                    | 221     | 166           | 111  | 66            |       |
| Min Removal in year 2005                 | kg/d                   | 3042                    | 203     | 152           | 101  | 61            |       |
| Max Removal in year 2025                 | kg/d                   | 5539                    | 369     | 277           | 185  | 111           |       |
| Min Removal in year 2025                 | kg/d                   | 5078                    | 339     | 254           | 169  | 102           |       |
| Max Removal in year 2025                 | kg/d                   | 6500                    | 433     | 325           | 217  | 130           |       |
| Min Removal in year 2025                 | kg/d                   | 5958                    | 397     | 298           | 199  | 119           |       |
| <b>SECONDARY TREATMENT</b>               |                        |                         |         |               |      |               |       |
|  |                        | Yr 2005                 |         | Yr 2025       |      | Yr 2025 + 20% |       |
|  |                        | Max                     | Min     | Max           | Min  | Max           | Min   |
| BOD Load To Secondary Stage              | kg/d                   | 5736                    | 5353    | 9353          | 8730 | 11069         | 10331 |
| Soluble BOD Component                    | kg/d                   | 2791                    | 2791    | 4259          | 4259 | 4945          | 4945  |
| Percentage Soluble BOD                   | %                      | 49                      | 52      | 46            | 49   | 45            | 48    |
| TKN Load To Secondary Treatment          | kg/d                   | 0                       | 0       | 0             | 0    | 0             | 0     |
| SS To Secondary Treatment Stage          | kg/d                   | 2489                    | 2212    | 4155          | 3693 | 4875          | 4333  |
| Volatile SS Component                    | %                      | 80                      |         |               |      |               |       |
| Volatile SS Component                    | kg/d                   | 1991                    | 1770    | 3324          | 2954 | 3900          | 3467  |
| Inorganic SS Component                   | kg/d                   | 498                     | 442     | 831           | 739  | 975           | 867   |
| NH4-N Load                               | kg/d                   | 1203                    | 1201    | 1352          | 1352 | 1596          | 1596  |
| TN Load                                  | kg/d                   | 0                       | 0       | 0             | 0    | 0             | 0     |
| <b>Concentrations at DWF</b>             |                        |                         |         |               |      |               |       |
|  |                        | Yr 2005                 |         | Yr 2025       |      | Yr 2025 + 20% |       |
|  |                        | Max                     | Min     | Max           | Min  | Max           | Min   |
| BOD concentration To Secondary Stage     |                        | 318                     | 296     | 313           | 292  | 370           | 346   |
| Soluble BOD Component                    |                        | 155                     | 155     | 143           | 143  | 165           | 165   |
| Percentage Soluble BOD                   |                        | 0                       | 0       | 0             | 0    | 0             | 0     |
| TKN concentration To Secondary Treatment |                        | 0                       | 0       | 0             | 0    | 0             | 0     |
| SS To Secondary Treatment Stage          |                        | 138                     | 123     | 139           | 124  | 163           | 145   |
| Volatile SS Component                    |                        |                         |         |               |      |               |       |
| Volatile SS Component                    |                        | 110                     | 98      | 111           | 99   | 130           | 116   |
| Inorganic SS Component                   |                        | 28                      | 25      | 28            | 25   | 33            | 29    |
| NH4-N concentration                      |                        | 67                      | 67      | 45            | 45   | 53            | 53    |
| <b>Concentrations at Average Flow</b>    |                        |                         |         |               |      |               |       |
|  |                        | Yr 2005                 |         | Yr 2025       |      | Yr 2025 + 20% |       |
|  |                        | Max                     | Min     | Max           | Min  | Max           | Min   |
| BOD concentration To Secondary Stage     |                        | 240                     | 224     | 245           | 229  | 290           | 271   |
| Soluble BOD Component                    |                        | 117                     | 117     | 112           | 112  | 130           | 130   |
| Percentage Soluble BOD                   |                        |                         |         |               |      |               |       |
| COD concentration To Secondary Treatment |                        | 0                       | 0       | 0             | 0    | 0             | 0     |
| SS To Secondary Treatment Stage          |                        | 104                     | 92      | 109           | 97   | 128           | 114   |
| Volatile SS Component                    |                        |                         |         |               |      |               |       |
| Volatile SS Component                    |                        | 83                      | 74      | 87            | 77   | 102           | 91    |
| Inorganic SS Component                   |                        | 21                      | 18      | 22            | 19   | 26            | 23    |
| NH4-N concentration                      |                        | 50                      | 50      | 35            | 35   | 42            | 42    |

**SLUDGE PRODUCTION**

**Extended Aeration** Not used in design

Note : This equation applies where primary tanks are not utilised and where extended aeration is practiced. It should not be used if trade effluents containing non-degradable or slowly biodegradable solids are present. For a more detailed calculation see spreadsheet entitled 'SAS Production Rate'.

|   |               |      |      |      |      |
|---|---------------|------|------|------|------|
| Sludge Loading (F/M Ratio)  | kgBOD/kgTSSd. | 0.3  |      |      |      |
| Temperature   | degrees C     | 8    | 10   | 12   | 20   |
| Ratio of non biodegradable solids in raw sewage / total SS in raw sewage. |               | 0.2  | 0.2  | 0.2  | 0.2  |
| Ratio of total raw sewage SS to raw sewage BOD (Fallback value =1.2)      |               | 0.72 |      |      |      |
| Temperature   | degrees C     | 8    | 10   | 12   | 20   |
| Sludge Yield  |               | 0.79 | 0.79 | 0.78 | 0.73 |
| Max Sludge Production (Yr 2005)   | kg/d          | 4556 | 4514 | 4466 | 4194 |
| Min Sludge Production (Yr 2005)   | kg/d          | 4252 | 4213 | 4168 | 3915 |
| Max Sludge Production (Yr 2025)   | kg/d          | 7422 | 7222 | 7022 | 6642 |
| Min Sludge Production (Yr 2025)   | kg/d          | 6934 | 6871 | 6798 | 6384 |
| Max Sludge Production (Yr 2025)   | kg/d          | 8792 | 8712 | 8619 | 8095 |
| Min Sludge Production (Yr 2025)   | kg/d          | 8206 | 8131 | 8045 | 7555 |

**Conventional Aeration**

For well settled sewage the following equation can be used. This applies for a temperature range of 7 to 25 C

|                                 |                            |       |      |      |      |
|---------------------------------|----------------------------|-------|------|------|------|
| Sludge Loading (F/M Ratio)      | kgBOD/kgTSSd.              | 0.27  |      |      |      |
| Temperature                     | degrees C                  | 8     | 10   | 12   | 20   |
| Sludge Yield                    | 0.75 used in tender design | 1.01  | 0.75 | 0.80 | 0.51 |
| Max Sludge Production (Yr 2005) | kg/d                       | 5810  | 4302 | 4569 | 2899 |
| Min Sludge Production (Yr 2005) | kg/d                       | 5423  | 4015 | 4264 | 2706 |
| Max Sludge Production (Yr 2025) | kg/d                       | 9475  | 7015 | 7454 | 4727 |
| Min Sludge Production (Yr 2025) | kg/d                       | 8844  | 6547 | 6954 | 4412 |
| Max Sludge Production (Yr 2025) | kg/d                       | 11213 | 8302 | 8817 | 5594 |
| Min Sludge Production (Yr 2025) | kg/d                       | 10466 | 7748 | 8229 | 5221 |

**Selector Tank Volume**

Design Basis : minimum of 30 mins at DWF plus RAS or 10 mins at max flow plus RAS

Assuming RAS remains constant for both flows.

|                                 |           |  |         |               |
|---------------------------------|-----------|--|---------|---------------|
| RAS Flow                        | m3/h      | Yr 2005  | Yr 2025 | Yr 2025 + 20% |
| 30 mins at DWF plus RAS         | m3        | 752  | 2036    | 2036          |
| 10 mins at max flow plus RAS    | m3        | 730  | 1590    | 1590          |
| 30 mins at DWF                  |           | 479  | 912     | 912           |
| Selector Zone Volume            | m3        | 354  | 572     | 572           |
|                                 |           | 730  | 1590    | <b>1590</b>   |
| MLSS                            | kg/m3     | 3.5  |         |               |
| Number of selector tanks        |           | 1  |         |               |
| Water Depth                     | m         | 5  |         |               |
| Tank Length                     | m         | 12   |         |               |
| Tank Width                      | m         | 10   |         |               |
| Actual Volume per tank          | m3        | 600  |         |               |
| Proposed Selector Tank Volume   | <b>m3</b> | <b>600</b> Selected to give floc loading >2.3        |         |               |
| Actual Retention Time           | mins      | DWF  | Average | Peak          |
| Actual Retention Time (inc RAS) | mins      | 51   | 39      | 17            |
| Floc Loading (>2.3)             |           | <b>4.5</b> (BOD kg/d /Mixed Liquor Mass in Selector) |         |               |

Note: The Floc Loading should be greater than 2.3 to encourage the growth of floc forming bacteria. This can be increased by lowering the selector volume or mixed liquor suspended solids.

|                    |     |
|--------------------|-----|
| Selected F/M ratio | 0.3 |
| Operating MLSS     | 3.5 |


|                 |                      |  |
|-----------------|----------------------|--|
| Volume Required | 10542 m <sup>3</sup> | Based upon 2025 load with 20% extra                          |
| Volume Selected | 10600                | as requirement to meet consent with one lane out of service. |

**Inclined Bubble Aeration Ditch**

|                                  |    |       |                           |
|----------------------------------|----|-------|---------------------------|
| Selector Volume Required         | m3 | 600   |                           |
| Total Volume For Oxidation ditch | m3 | 10600 |                           |
|                                  |    |       | Tender drawing shows tank |
| Number of streams                | m3 | 4     |                           |
| Volume Per stream                | m3 | 2650  |                           |
| Minimum Sewage Depth             | m  | 5     | 5                         |
| Width of each lane               | m  | 7     | 7                         |
| Straight Length of each tank     | m  | 38    | 48.5                      |
| Actual Volume Per Tank           | m3 | 2660  | 3395                      |
| Recycle Ratio (FST to ditch)     |    | 1     |                           |

Ref: Vol 4 section 7.7.1 minimum sludge 5 days @ 10 deg C

**Inclined Bubble Aeration Ditch - Tapered Ends**

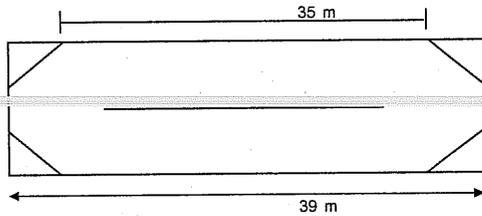

|                              |                               |
|------------------------------|-------------------------------|
| Area taken by corner baffles | 8 m <sup>2</sup>              |
| total length required        | 38.0 m                        |
| actual total tank length     | 39.1 m                        |
| Actual Volume                | 2690 m <sup>3</sup> per ditch |
|                              | 10760 m <sup>3</sup> total    |

**DGHemmings:**  
Includes 20% extra load

**Actual F/M Ratio**

|                  | kg/m3 | Average 2005 |      | Max Year 2025 |      | Max Year 2025 |      |
|------------------|-------|--------------|------|---------------|------|---------------|------|
|                  |       | Max          | Min  | Max           | Min  | Max           | Min  |
| MLSS in ASP      |       | 3.0          | 3.0  | 3.5           | 3.5  | 3.5           | 3.5  |
| Actual F/M Ratio |       | 0.18         | 0.17 | 0.25          | 0.23 | 0.29          | 0.27 |
| SRT              | d     | 8            | 8    | 5             | 6    | 5             | 5    |
| SRT              | d     | 8            | 8    | 5             | 6    | 5             | 5    |

SRT = Vol x MLSS/sludge prod  
SRT = 1/(yield x F:M)

**Operation With One Tank Out Of Service**


|                  |       |      |      |      |      |      |      |
|------------------|-------|------|------|------|------|------|------|
| MLSS in ASP      | kg/m3 | 3.0  | 3.0  | 4.0  | 4.0  | 4.8  | 4.8  |
| Actual F/M Ratio |       | 0.24 | 0.22 | 0.29 | 0.27 | 0.29 | 0.27 |
| SRT              | d     | 6    | 6    | 5    | 5    | 5    | 5    |
| SRT              | d     | 6    | 6    | 5    | 5    | 5    | 5    |

SRT = Vol x MLSS/sludge prod  
SRT = 1/(yield x F:M)

assumes all FST's will be in service when one activated sludge lane is taken out of service.

For inspection purposes only. Not for any other use.  
Consent of copyright owner required for any other use.

DO NOT SCALE - IF IN DOUBT ASK

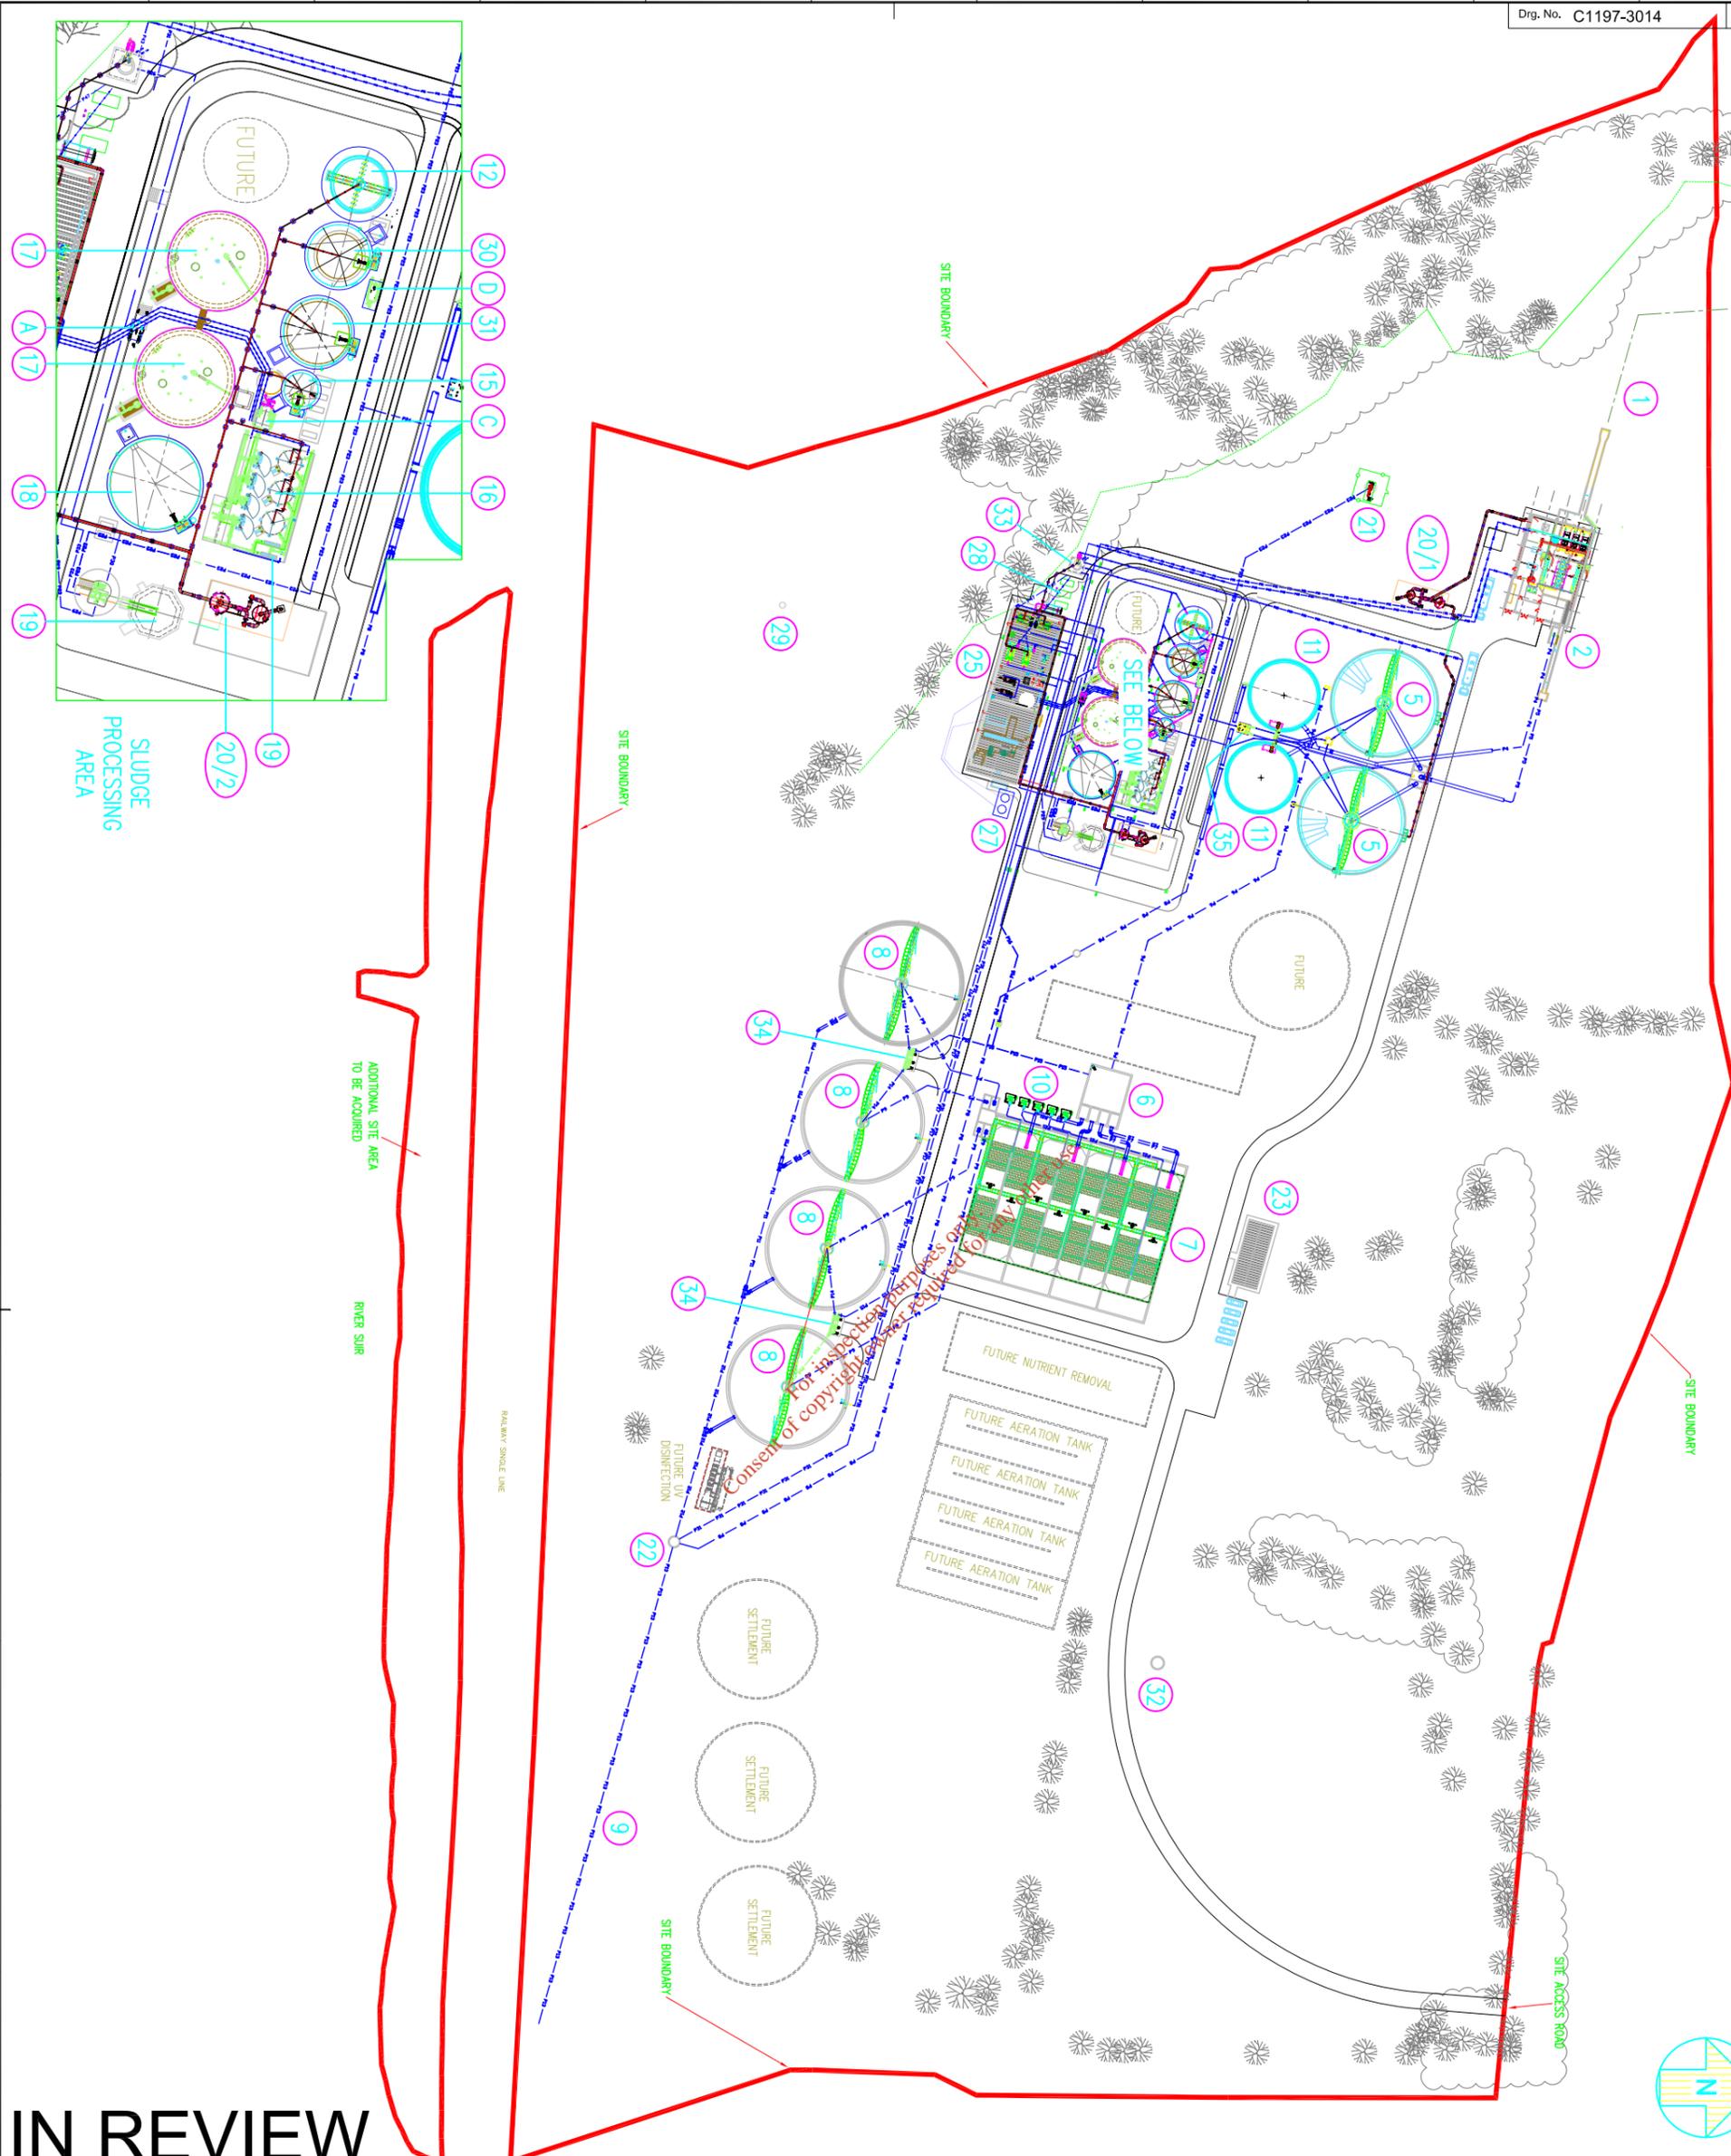

See Previous Issues For Past Revision Details

| Rev. | Date | Description | Drawn |
|------|------|-------------|-------|
| A    |      | FIRST ISSUE |       |

**NOTE**  
TREES INDICATED ARE TO BE RETAINED

**THIS DRAWING TO BE READ IN CONJUNCTION WITH TEXT OF 3 o) (i) WATER LICENCE**

- PLANT LEGEND:**
- 1 INLET CHANNEL
  - 2 SCREENING & GRT REMOVAL BUILDING
  - 3 PRIMARY SETTLEMENT TANK
  - 4 SELECTOR TANK
  - 5 AERATION TANK
  - 6 FINAL SETTLEMENT TANK
  - 7 OUTFALL
  - 8 AERATION BLOWERS (3 No.)
  - 9 STORMWATER TANK
  - 10 PICKET FENCE THICKENER
  - 11 SLUDGE BLENDING TANK
  - 12 SLUDGE PASTEURISATION
  - 13 SLUDGE DICESTER
  - 14 DICESTED SLUDGE TANK
  - 15 GAS HOLDING TANK
  - 16 ODOUR CONTROL UNIT - OULET
  - 17 ODOUR CONTROL UNIT - INLET
  - 18 ODOUR CONTROL UNIT - SLUDGE
  - 19 WASTE GAS BURNER
  - 20 DISCHARGE MONITORING CHAMBER
  - 21 ADMINISTRATION BUILDING
  - 22 SLUDGE THICKENING, Dewatering & Digestion CONTROL BUILDING
  - 23 FUEL TANK
  - 24 SFP HOLDING AREA
  - 25 SURFACE WATER MONITORING CHAMBER
  - 26 THICKENED PRIMARY SLUDGE TANK
  - 27 THICKENED SECONDARY SLUDGE TANK
  - 28 BETWEEN SEWER PUMPING STATION
  - 29 RETURN LIQUORS PUMPING CHAMBER
  - 30 RAS PUMPS (6 No. TOTAL)
  - 31 PRIMARY SLUDGE PUMPS (3 No.)

**A.W.I. CONTRACT No 1002**



Enpure Limited  
Empire House,  
Birmingham Road,  
UK  
Tel: +44 (0)1562 820 010  
Fax: +44 (0)1562 820 008  
Internet: www.enpure.co.uk






Customer:  
**WATERFORD CITY COUNCIL**

Title:  
**SITE LAYOUT  
MAIN FEATURES  
WATERFORD WWTW**

| Date       | Drawn   | Checked | Approved | Checked | Scale |
|------------|---------|---------|----------|---------|-------|
| 23/09/2008 | P/White |         |          |         | A1    |

**IN REVIEW**

Drg. No. **C1197-3014** Rev. **A**

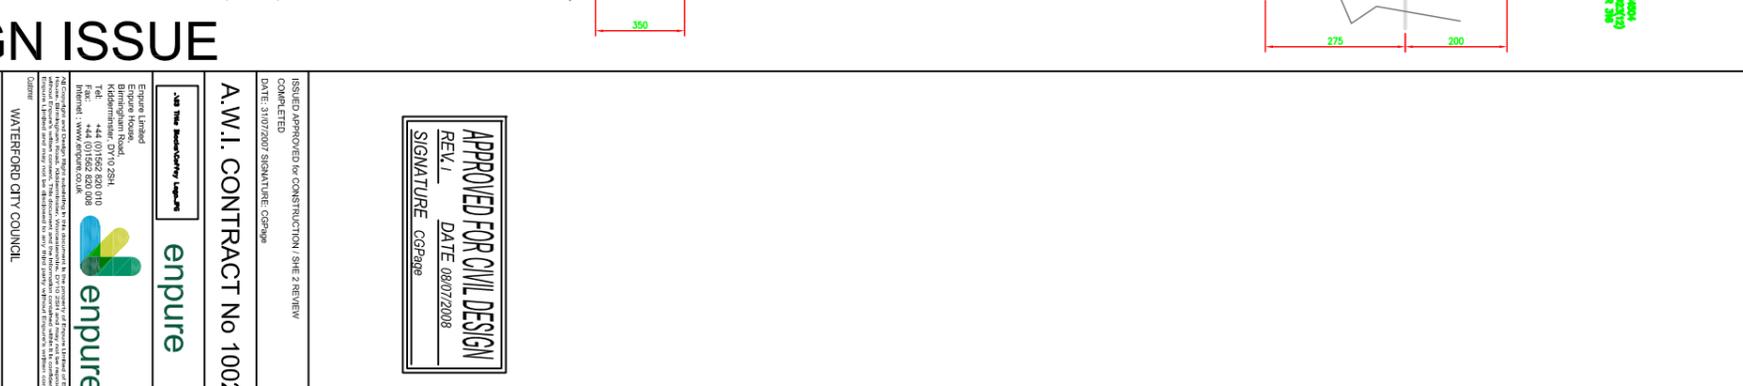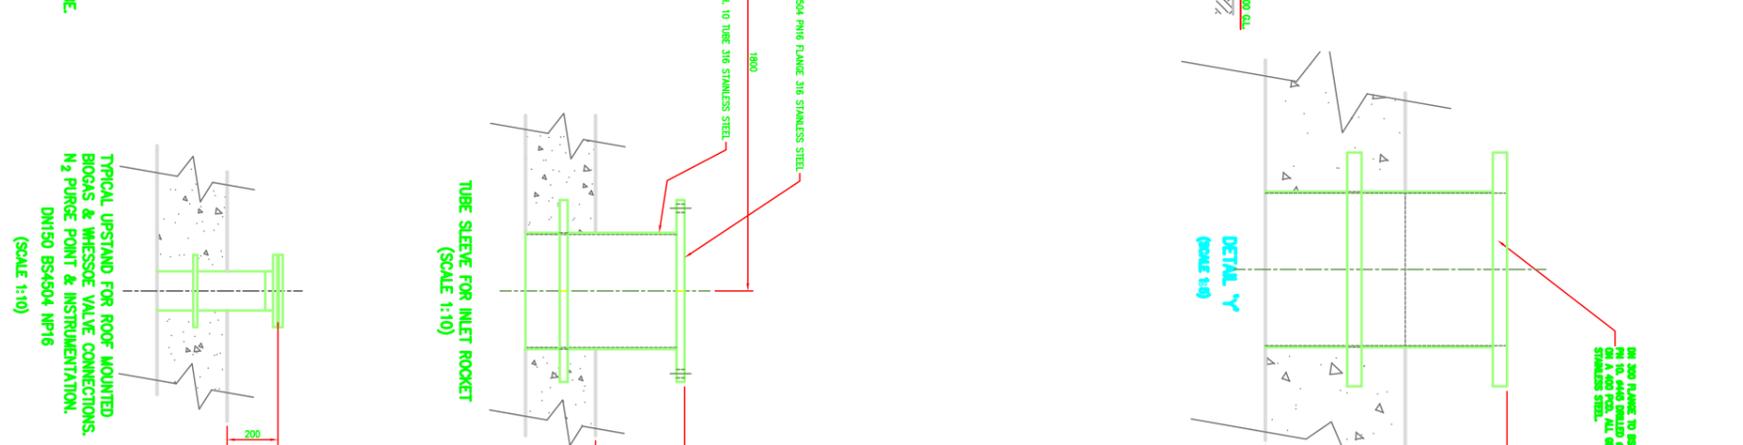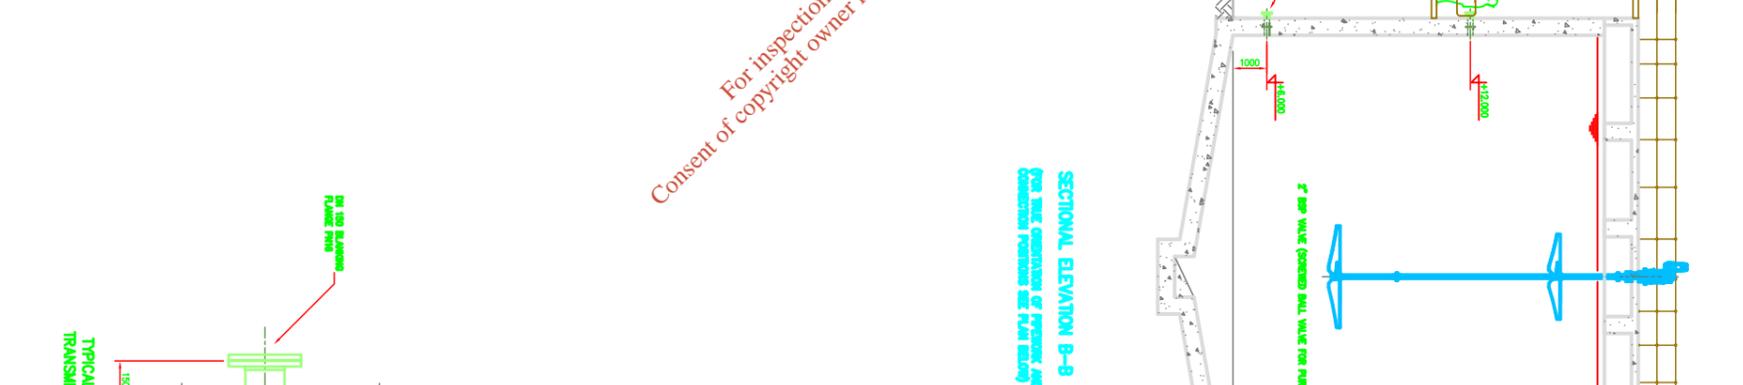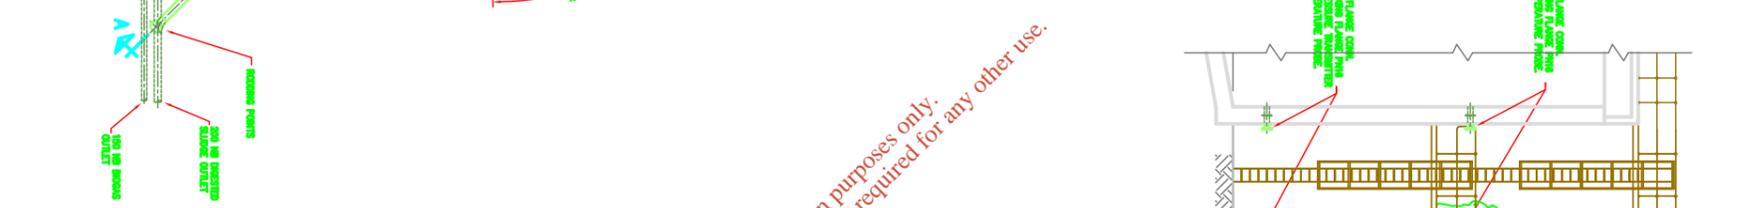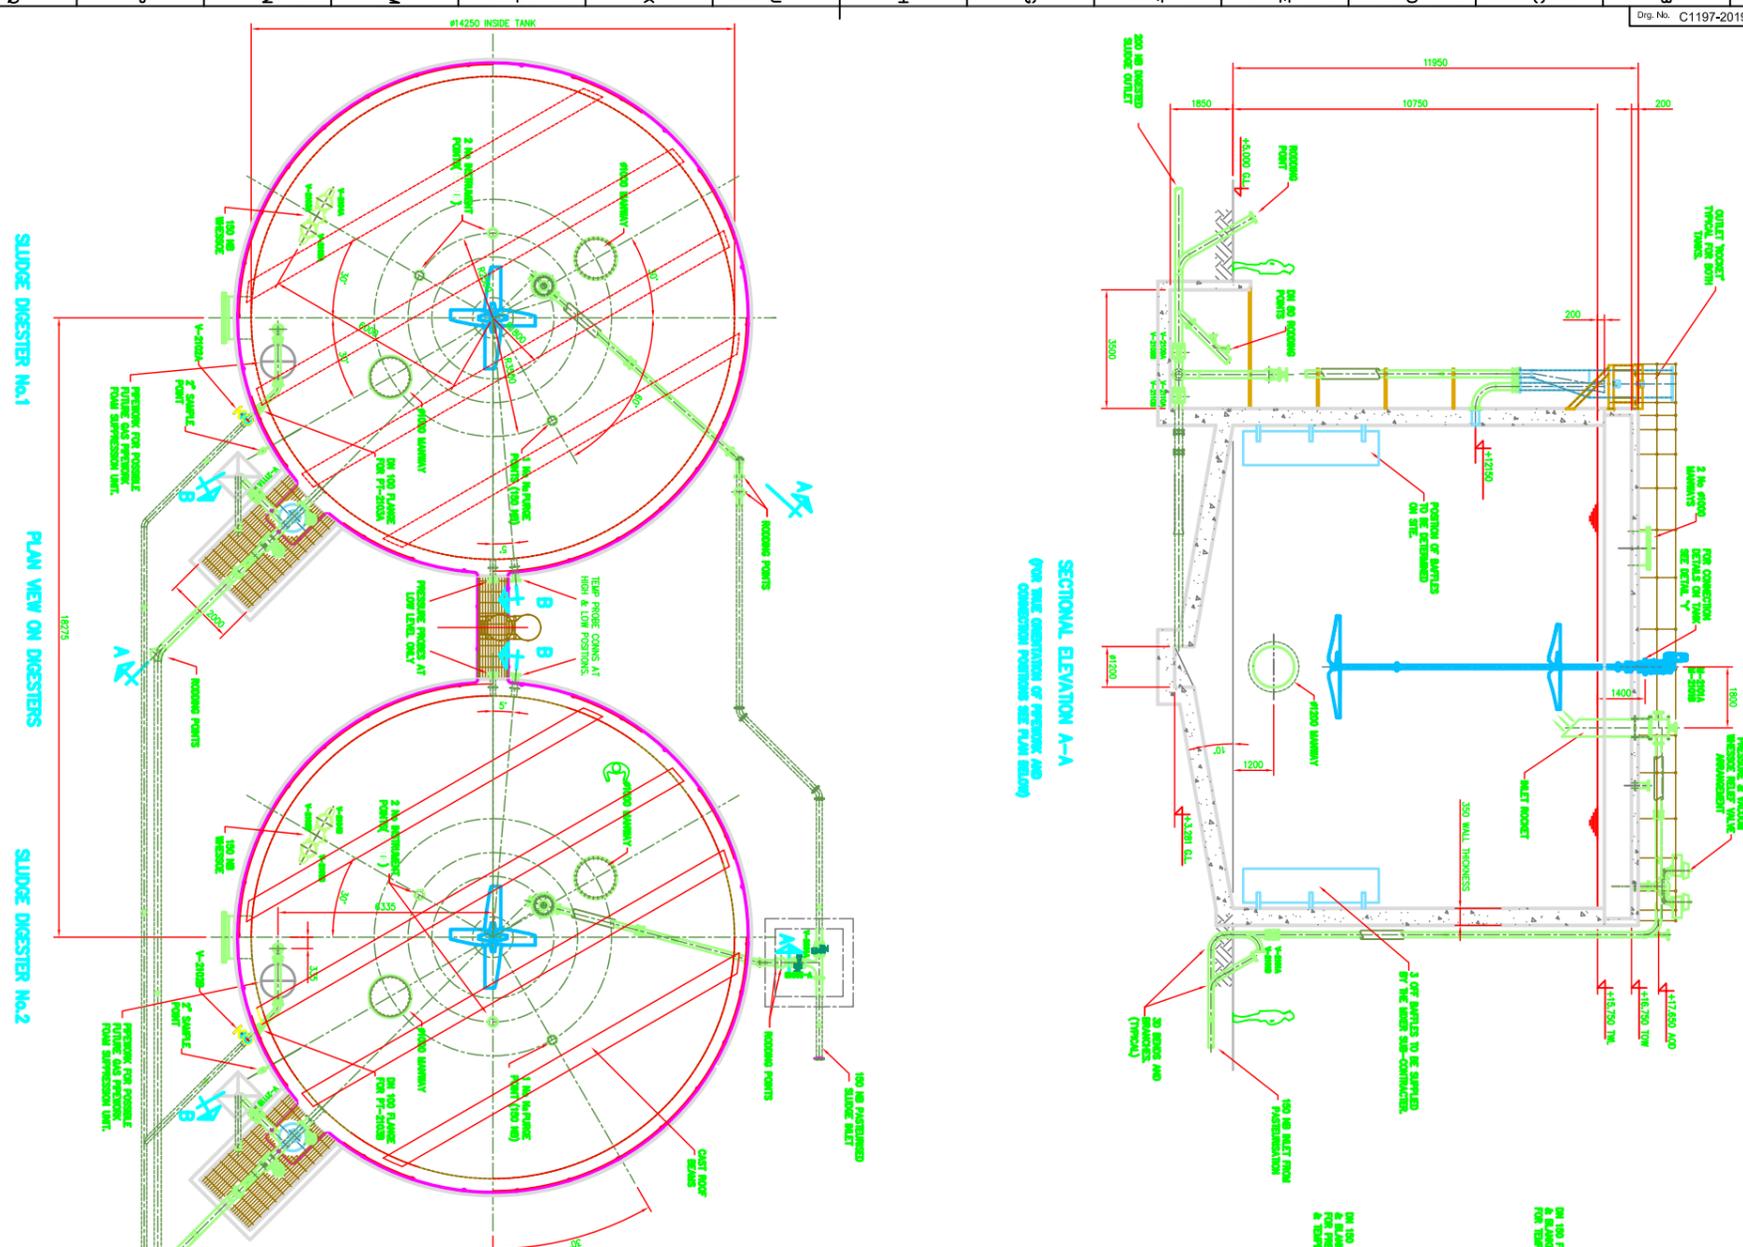

For inspection purposes only.  
 Consent of copyright owner required for any other use.

DO NOT SCALE IF IN DOUBT ASK


**DESIGN ISSUE**

|  |   |
|--|---|
| <p>Project No: C1197-2019</p>  | <p>Sheet No: 1</p>  |

**APPROVED FOR CIVIL DESIGN**  
 REV. L  



DO NOT SCALE - IF IN DOUBT ASK

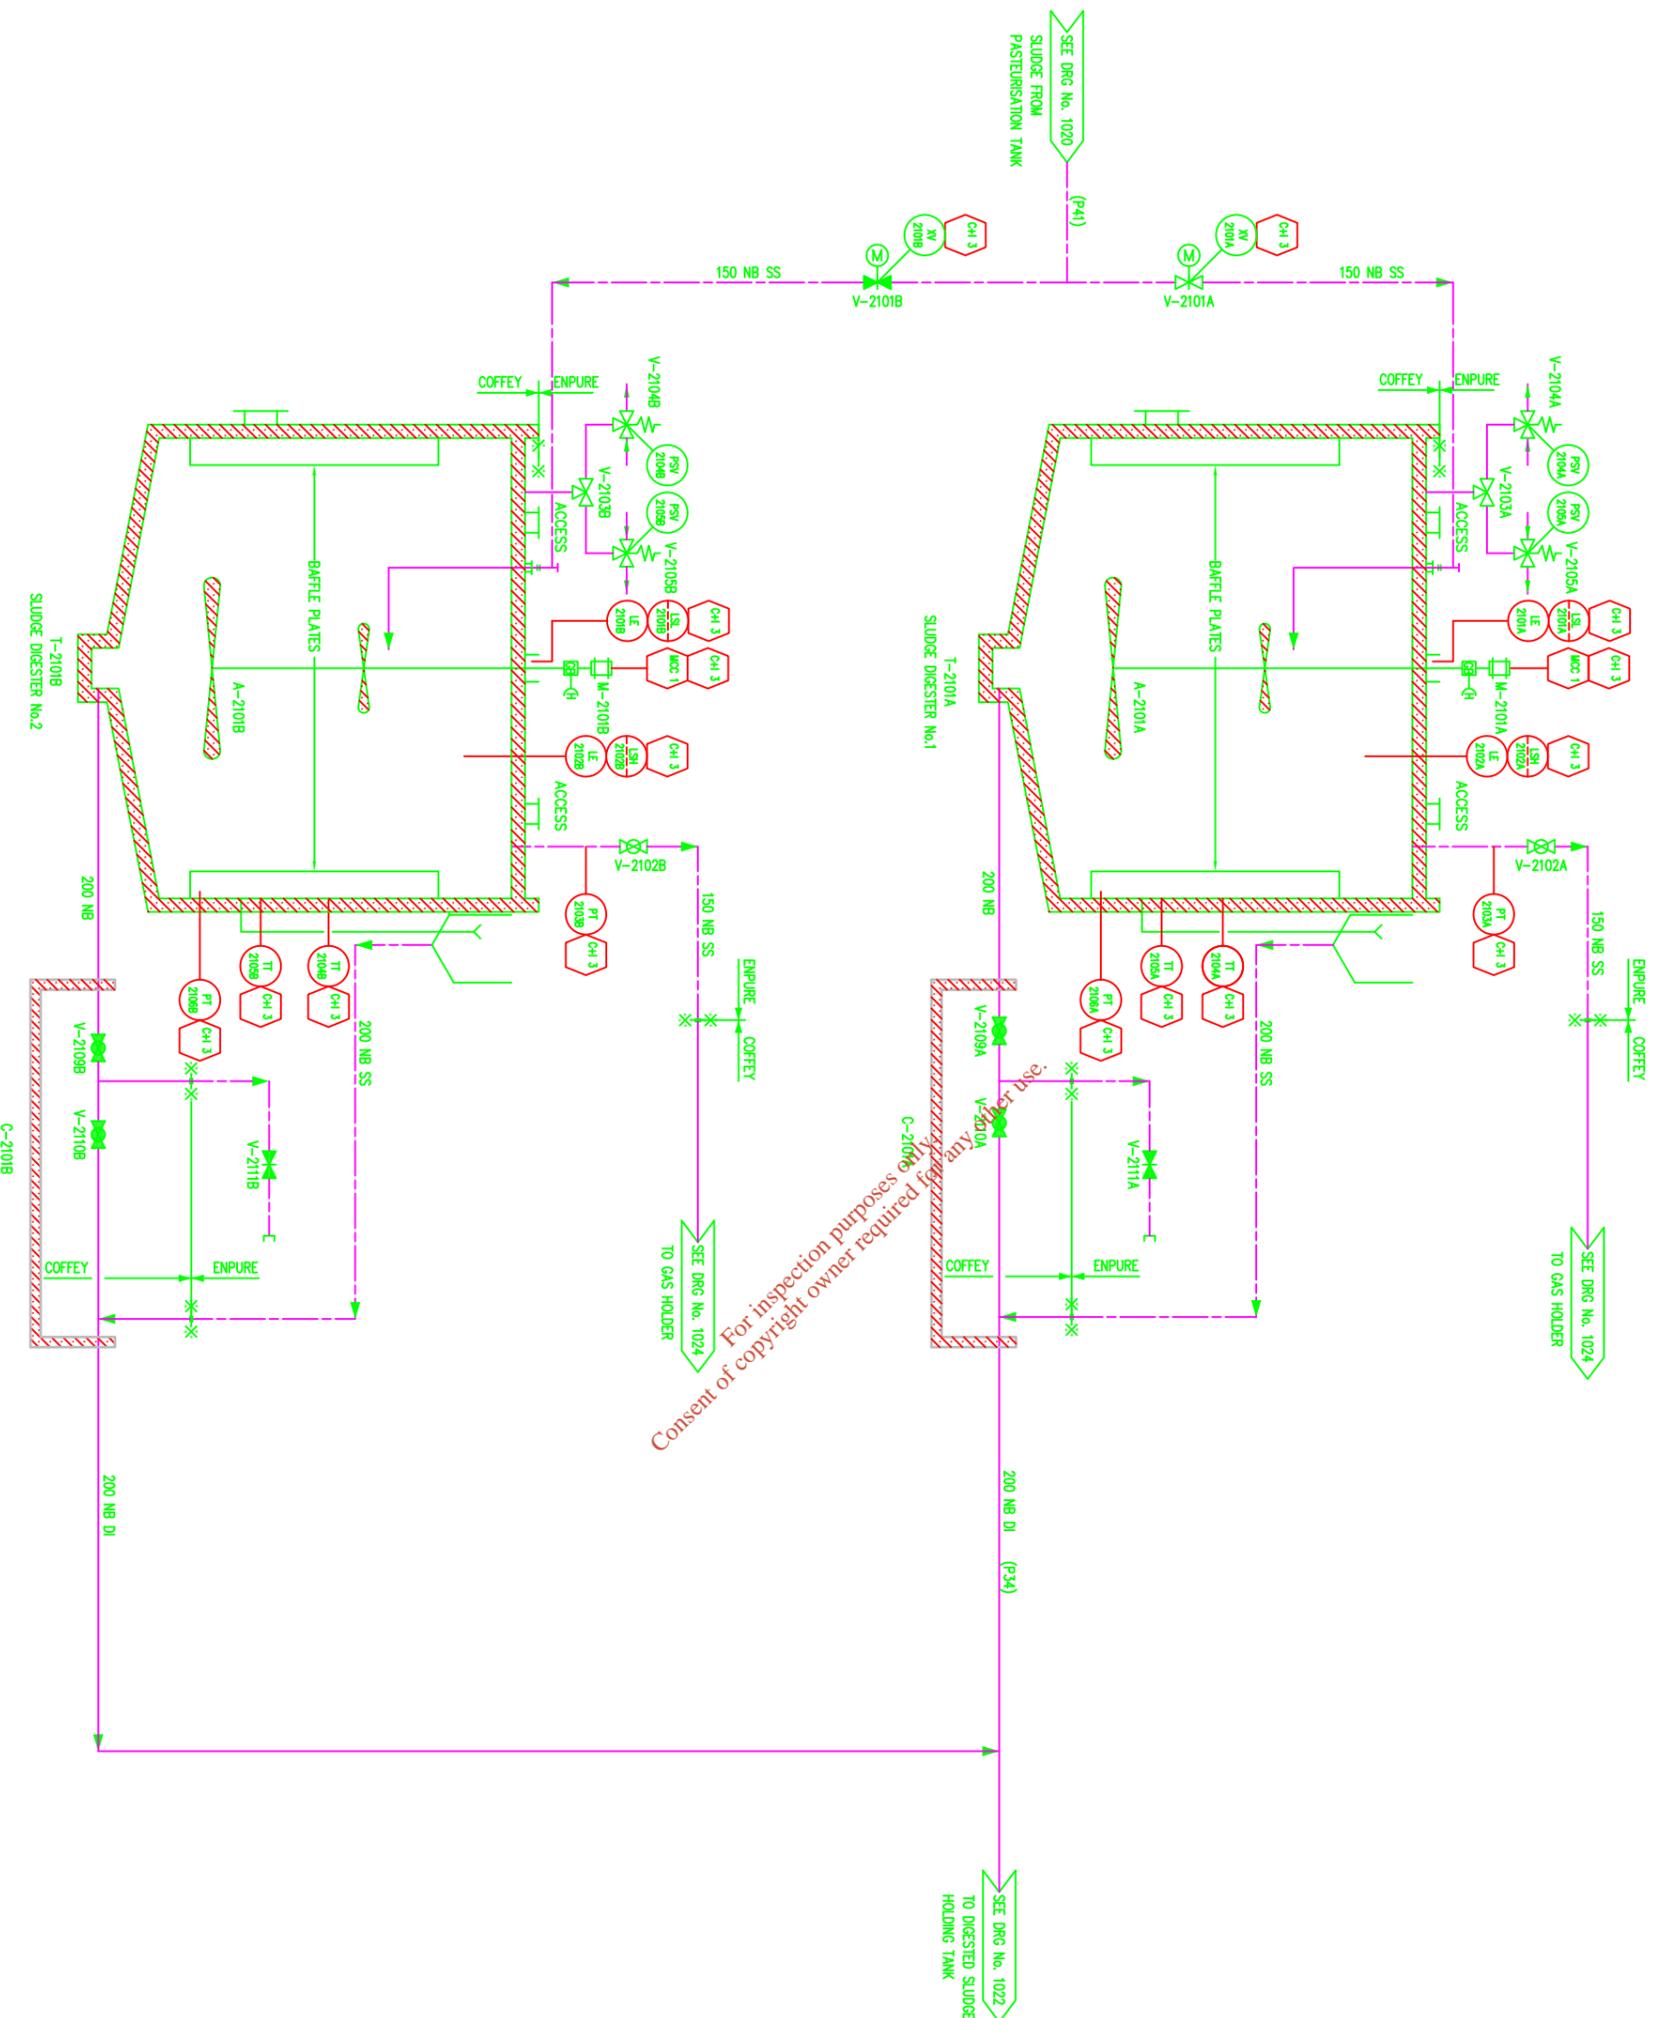

See Previous Issues For Past Revision Details

| Rev | Date       | Description  | Drawn |
|-----|------------|--------------|-------|
| 1   | 27/06/2008 | GENERAL MODS |       |

NOTES  
1. REMOVED

HOLDS  
1. ENPURE TO CONFIRM.

LEGEND:  
NEW PIPEWORK / CHANNEL BY CIVILS CONTRACTOR:  
NEW PIPEWORK BY M&E CONTRACTOR:  
ENPURE PREWORK

| CHECKED        |     | APPROVED                |     |
|----------------|-----|-------------------------|-----|
| PROCESS ENG.   | RAJ | PROCESS TECH SPECS/ASST | DGG |
| PROJECT ENG.   | JMN | PROJECT MAN.            | CGP |
| LEAD MECH ENG. | JAM | MECH ENG MAN.           | BM  |
| LEAD ELEC ENG. | AMT | ELEC ENG MAN.           | JL  |

A.W.I. CONTRACT No 1002



Empure Limited  
Empure House,  
Birmingham Road,  
Kidderrishin, D17 10 2SH,  
UK  
Tel: +44 (0)1562 820 010  
Fax: +44 (0)1562 820 008  
Internet: www.empure.co.uk

enpure  
All Copyright and Design Right subsisting in this document is the property of Empure Limited of Empure without Empure's written consent. This document and the information contained within it is confidential to Empure Limited and may not be disclosed to any third party without Empure's written consent.

CUSTOMER  
WATERFORD CITY COUNCIL  
Title  
SLUDGE DIGESTERS  
P & I DIAGRAM  
WATERFORD WWTTW


| Drawn       | Checked    | Approved   | Original Size  |
|-------------|------------|------------|----------------|
| DJL/idesley | RJ/Miller  | RA/Leakin  | A1             |
| Date        | Date       | Date       | Original Scale |
| 20/10/2006  | 26/06/2008 | 27/06/2008 | NTS            |

ISSUED AFC

Drg. No. C1197-1021

DO NOT SCALE - IF IN DOUBT ASK


Rev. 1  
C1197-2023

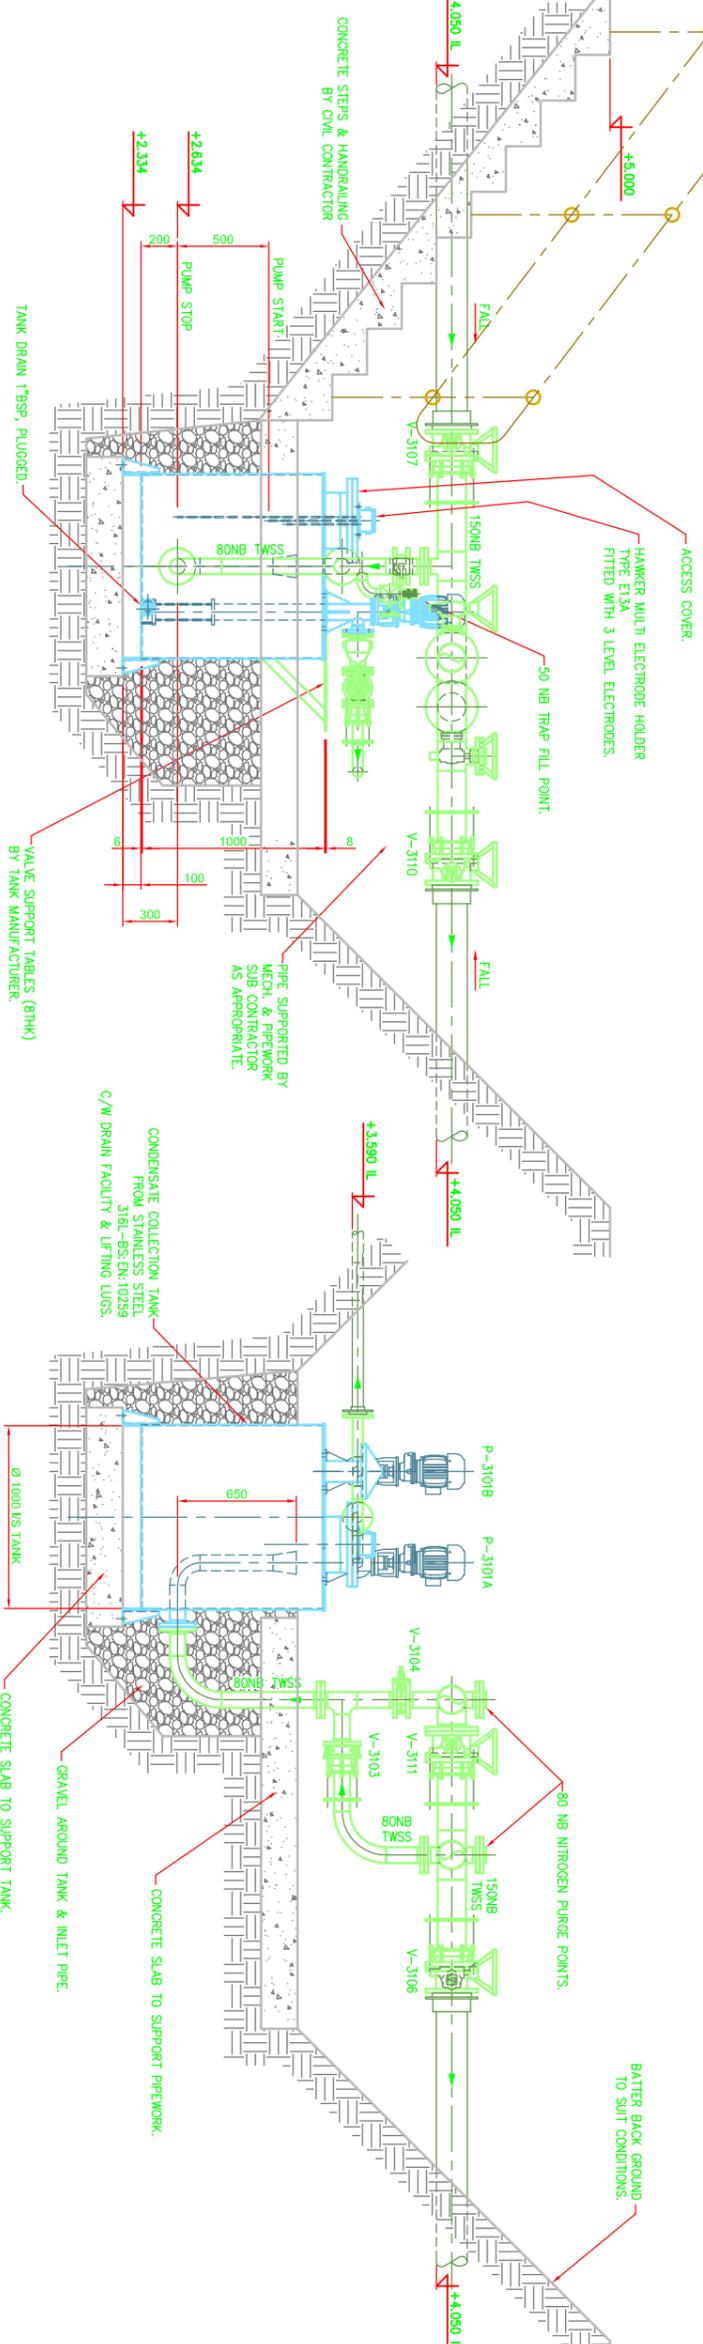

**SECTION B-B**

For inspection purposes only.  
Consent of copyright owner required for any other use.

SEEPEC CONDENSATE TRANSFER VERTICAL PUMPS  
PROGRESSIVE CAVITY PUMPS. TYPE:  
BE 5-6L / AS-A7-R0-GAM3.2-X  
DISCHARGE FLANGE: DN50 PN16 3m/1.36AR 224RPM  
FITTED GEARED MOTOR: 1.1KW 1390 RPM  
DRG. No. 271-A32/0020-C-018A3  
OFFER No. 1903/1322 OF 25/06/2007  
PUMPS TO BE FREE ISSUED TO TANK SUPPLIER FOR  
INSTALLATION INTO TANK BEFORE DELIVERY TO SITE.

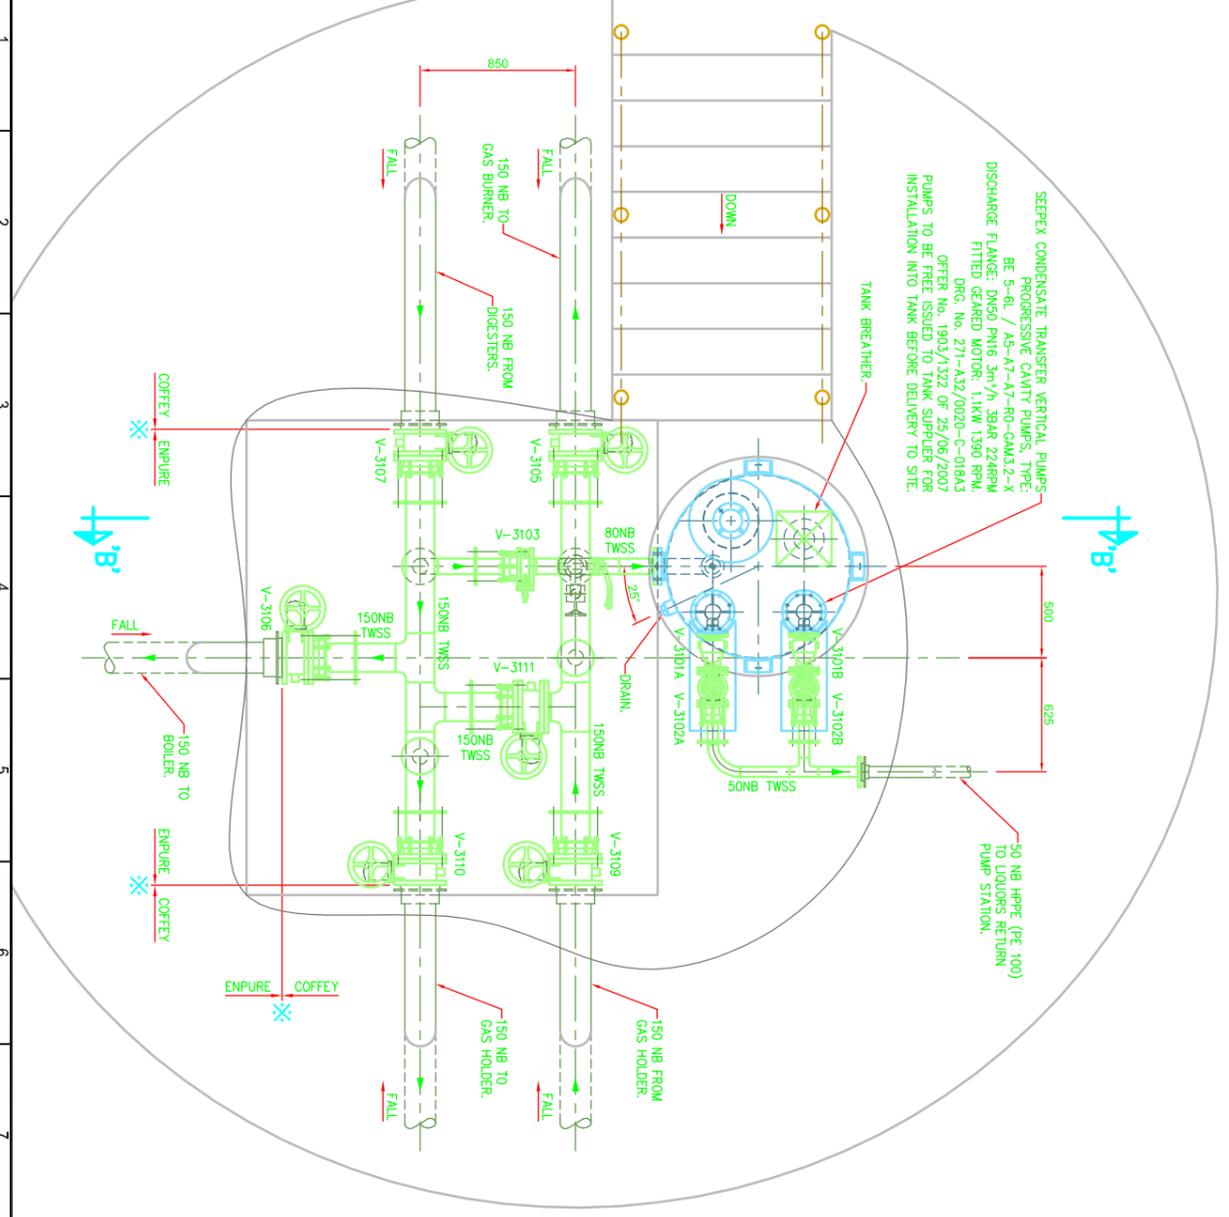

| Rev. | Date       | Description                  | Drawn |
|------|------------|------------------------------|-------|
| 1    | 24/09/2007 | REBRAM, WAS IN ROUND CHAMBER |       |

NOTE : THE DIGESTER BIOGAS IS AT A PRESSURE OF 200mm Wg (20 mBAR) ABOVE ATMOSPHERIC CONDITIONS AND THE DIGESTER PRESSURE RELIEF VALVES WILL BE SET TO DISCHARGE AT 275mm Wg.

NOTE : IT IS OF PARAMOUNT IMPORTANCE THAT THE BIOGAS PIPENWORK BETWEEN DIGESTERS AND CONDENSATE TRAP (CT), GROUND FLARE AND CT GAS HOLDER AND CT AND HOT WATER BOILERS AND CT ALL SLOPE, WITH CONSTANT GRADIENT "DOWN", TOWARDS THE PIPENWORK ABOVE THE CONDENSATE TRAP. TYPICAL CONSTANT GRADIENT 1:100. DIGESTER BIOGAS AT 36°C IS SATURATED WITH WATER VAPOUR AND ANY COOLING OF THE GAS WILL RESULT IN CONDENSATE CONTAINING SULPHUR. THIS LIQUOR MUST FLOW DOWNHILL TO THE CONDENSATE TRAP. ANY DIP IN THE GRADIENT MAY RESULT IN THE GAS FLOW/RATES BEING THROTTLED OR COMPLETELY STOPPED. DUE TO THE LIQUOR FORMING IN THE PIPELINE DEPRESSION, THE PURPOSE OF THE CT IS TO FULLY REMOVE THE LIQUOR FROM THE SYSTEM AND THEREBY ALLOW THE UNRESTRICTED FLOW OF BIOGAS THROUGH THE SYSTEM.

**ISSUED AFC**

ISSUED APPROVED FOR CONSTRUCTION / SHE 2 REVIEW  
COMPLETED  
DATE: 02/11/2007 SIGNATURE: JMK/ncn

**A.W.I. CONTRACT No 1002**

*was the* **enpure**

Enpure Limited  
Enpure House,  
Birmingham Road,  
Kidderminster, DY10 2SH,  
UK.  
Tel: +44 (0)1562 820 010  
Fax: +44 (0)1562 820 008  
Internet: [www.enpure.co.uk](http://www.enpure.co.uk)

**enpure**


Customer  
WATERFORD CITY COUNCIL

The  
CONDENSATE TRAP  
GENERAL ARRANGEMENTS  
WATERFORD WWTTW

| Date       | Checked   | Approved  | Scale      |
|------------|-----------|-----------|------------|
| 12/02/2007 | CW/Thomas | RJ/Weakin | CG/Pege    |
| 19/09/2007 |           |           | 24/09/2007 |

Scale: 1:20  
Rev: 1

DO NOT SCALE - IF IN DOUBT ASK

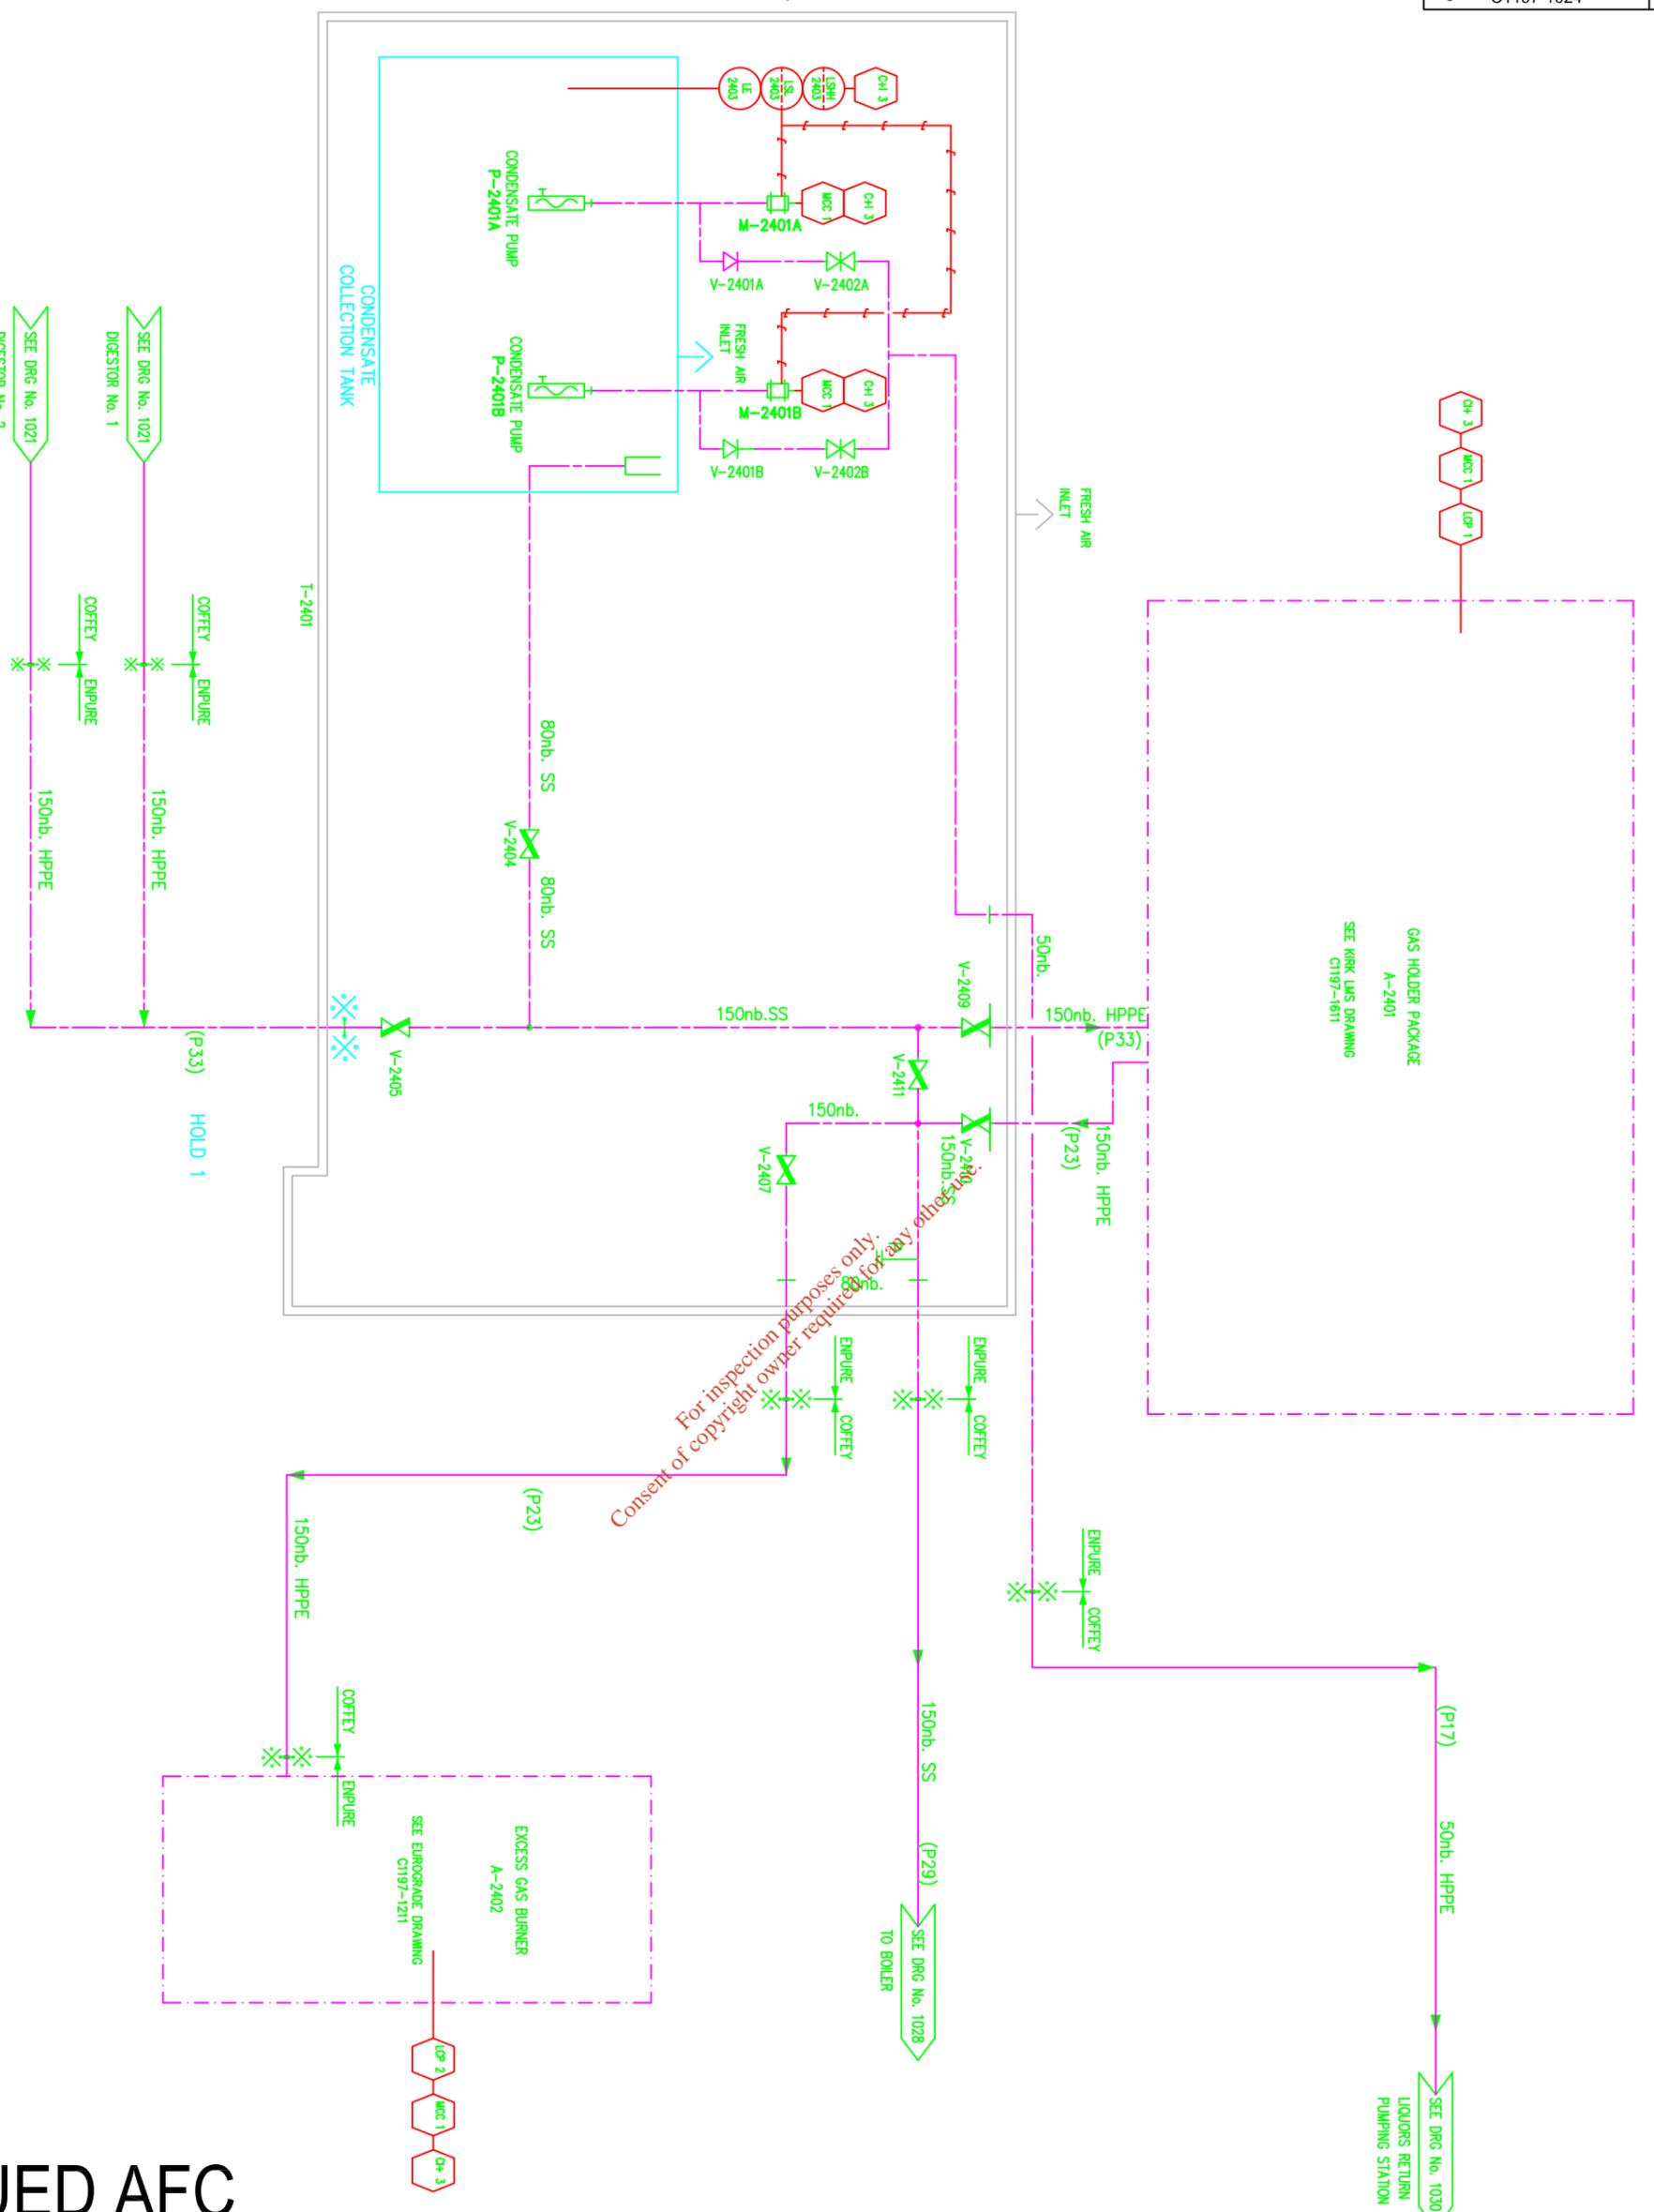

For inspection purposes only.  
Consent of copyright owner required for any other use.

| See Previous Issues For Past Revision Details |            |   |
|---|------------|---|
| Rev   | Date       | Description                               |
| 1   | 27/06/2008 | ELEC TAGS UPDATED AND GAS HOLDER REVISED. |

**NOTES**  
1. DRAWING PREVIOUSLY E8374-1024

**LEGEND:**  
 NEW PIPEWORK / CHANNEL BY CIVILS CONTRACTOR.  
 NEW PIPEWORK BY MAKE CONTRACTOR.  
 ENPURE PIPEWORK

|                    |                    |                           |                  |
|--------------------|--------------------|---------------------------|------------------|
| CHECKED            |                    | APPROVED                  |                  |
| PROCESS ENG. DGH   | PROJECT ENG. JMN   | PROCESS TECH SPECMAN. DGG | PROJECT MAN. CGP |
| LEAD MECH ENG. JAM | LEAD ELEC ENG. AMT | MECH ENG MAN. BM          | ELEC ENG MAN. JL |

**A.W.I. CONTRACT NO 1002**



Empure Limited  
 Empire House,  
 Berrington Road,  
 Kilderminstor, D11 0 ZSH,  
 Tel: +44 (0)1562 820 010  
 Fax: +44 (0)1562 820 008  
 Internet: www.empure.co.uk

**Customer:** WATERFORD CITY COUNCIL

**Title:** GAS HOLDING SYSTEM  
 P & I DIAGRAM  
 WATERFORD WWTTW

|              |            |            |                |
|--------------|------------|------------|----------------|
| Drawn        | Checked    | Approved   | Original Size  |
| DJ/Tildesley | RJ/Miller  | RAMeakin   | A1             |
| Date         | Date       | Date       | Original Scale |
| 20/10/2008   | 26/06/2008 | 27/06/2008 | NTS            |

**ISSUED AFC**

Drg. No. **C1197-1024**



| <b>BOILER SIZING</b>  |                    |          |          |          |          |                                 |
|---|--------------------|----------|----------|----------|----------|---------------------------------|
|   |                    | Case 1   | Case 2   | Case 3   | Case 4   |                                 |
| Total Heat Required by all Digesters  | kW                 | 253      | 314      | 744      | 921      | Ref: 8416 Heat Exchanger Design |
| Number of Duty Boilers Selected   |                    | 1        | 1        | 2        | 2        |                                 |
| Output Required by Each Boiler  | kW                 | 253      | 314      | 372      | 461      |                                 |
| Boiler output required to be specified to suppliers. Suppliers to select actual boiler model to meet the required output and advise actual output, efficiency and fuel input requirements. Calculation given below is for preliminary assessment purposes only. |                    |          |          |          |          |                                 |
| Boiler Output Selected (Each)   | kW                 | 500      | 500      | 500      | 500      |                                 |
| Boiler Efficiency (Assumed)   | %                  | 80       | 80       | 80       | 80       |                                 |
| Estimated Fuel Input Required (Each)  | kW                 | 625      | 625      | 625      | 625      |                                 |
| <b>Sludge Gas Usage</b>   |                    |          |          |          |          |                                 |
| Gas Net Calorific Value   | MJ/Nm <sup>3</sup> | 22.5     | 22.5     | 22.5     | 22.5     |                                 |
| Approximate Gas Flowrate (Each)   | Nm <sup>3</sup> /h | 100      | 100      | 100      | 100      |                                 |
| Approximate Gas Flowrate (Total)  | Nm <sup>3</sup> /h | 100      | 100      | 200      | 200      |                                 |
| Minimum Gas Yield (Total)   | m <sup>3</sup> /d  | 2291     | 2291     | 3776     | 3776     | 8413 Gas Production             |
| Proportion of Minimum Gas Yield Consumed by all Boilers   | %                  | 105      | 105      | 127      | 127      |                                 |
| <b>Standby Fuels</b>  |                    |          |          |          |          |                                 |
| Fuel Oil Net Calorific Value  | MJ/m <sup>3</sup>  | 36900.00 | 36900.00 | 36900.00 | 36900.00 |                                 |
| Fuel Oil Flowrate (approx)  | m <sup>3</sup> /h  | 0.06     | 0.06     | 0.06     | 0.06     |                                 |
|   | l/h                | 61       | 61       | 61       | 61       |                                 |
| LPG Net Calorific Value   | MJ/m <sup>3</sup>  | 93.90    | 93.90    | 93.90    | 93.90    |                                 |
| LPG Flowrate (approx)   | Nm <sup>3</sup> /h | 23.96    | 23.96    | 23.96    | 23.96    |                                 |
| Natural Gas Net Calorific Value   | MJ/Nm <sup>3</sup> | 38.62    | 38.62    | 38.62    | 38.62    |                                 |
| Natural Gas Flowrate (approx)   | Nm <sup>3</sup> /h | 58.26    | 58.26    | 58.26    | 58.26    |                                 |

For inspection purposes only. Consent of copyright owner required for any other use.



**GAS HOLDER, EXCESS GAS BURNER AND DIGESTER PRESSURE/VACUUM RELIEF VALVES SIZING**

|   |                   | Case 1 | Case 2 | Case 3 | Case 4 |
|---|-------------------|--------|--------|--------|--------|
| <b>Gas Holder</b>                         |                   |        |        |        |        |
| Number of Gas Holders                     |                   | 1      | 1      | 1      | 1      |
| Average Gas Production Rate               | m <sup>3</sup> /h | 193    | 164    | 157    | 95     |
| Retention Time in each Gas Holder         | min               | 20     | 20     | 20     | 20     |
| Capacity of each Gas Holder               | m <sup>3</sup>    | 64     | 55     | 52     | 32     |
| Selected Capacity of each Gas Holder      | m <sup>3</sup>    | 65     | 65     | 65     | 65     |
| Retention Time at Minimum Production Rate | min               | 23     | 27     | 28     | 46     |
| Retention Time at Average Production Rate | min               | 20     | 24     | 25     | 41     |
| Retention Time at Maximum Production Rate | min               | 18     | 21     | 22     | 37     |

**Excess Gas Burner**

|                              |                   |     |     |     |     |
|------------------------------|-------------------|-----|-----|-----|-----|
| Maximum Gas Production Rate  | m <sup>3</sup> /h | 215 | 182 | 175 | 106 |
| Gas Burner Oversizing Margin | %                 | 25  | 25  | 25  | 25  |
| Gas Burner Capacity Required | m <sup>3</sup> /h | 268 | 228 | 219 | 133 |

**Digester Pressure/Vacuum Relief Valve - Pressure Relief Condition**

|                               |                   |     |     |     |    |  |
|-------------------------------|-------------------|-----|-----|-----|----|--|
| Maximum Gas Production Rate   | m <sup>3</sup> /h | 107 | 91  | 87  | 53 |  |
| Mixing Compressor Flowrate    | m <sup>3</sup> /h | 0   | 0   | 0   | 0  | Mechanical Mixing                      |
| Digester Feed Volume          | m <sup>3</sup> /h | 15  | 15  | 15  | 15 | Ref: Pasteurisation design sheets 8420 |
| Pressure Relief Rate Required | m <sup>3</sup> /h | 122 | 106 | 102 | 68 |  |

**Digester Pressure/Vacuum Relief Valve - Vacuum Relief Condition**

|   |    |        |        |        |        |
|---|----|--------|--------|--------|--------|
| Digester Height (Centre of Cone to TWL) | m  | 13.173 | 13.173 | 13.173 | 13.173 |
| Drain Pipe Diameter (ID)                | m  | 0.20   | 0.20   | 0.20   | 0.20   |
| Drain Pipe Length                       | m  | 0.0    | 15.0   | 18.0   | 20.0   |
| Roughness                               | mm | 0.5    | 0.5    | 0.5    | 0.5    |
| Fittings K <sub>T</sub>                 |    | 2      | 2      | 2      | 2      |


Maximum vacuum relief rate will occur when the friction loss in the outlet line is equal to the static head above the outlet. To evaluate this, the flowrate at which the static head is equal to the friction loss must be determined. Note that the friction factor and hence the friction loss is dependent on the flowrate so the equations must be solved by iteration.

To solve, use the following procedure :

From "Tools" menu choose "Goal Seek"  
 In "Set cell" box enter "C64", "D64", "E64", "F64"  
 In "To value" box enter number contained in cell C39, D39, E39, F39  
 In "By changing cell" box enter "C56", "D56", "E56", "F56"

|                                 |                    |         |         |         |         |
|---------------------------------|--------------------|---------|---------|---------|---------|
| Maximum Flowrate                | m <sup>3</sup> /h  | 882     | 824     | 794     | 776     |
| Water Temperature for Design    | °C                 | 35.0    | 35.0    | 35.0    | 35.0    |
| Water Density                   | kg/m <sup>3</sup>  | 994     | 994     | 994     | 994     |
| Water Viscosity                 | mNs/m <sup>2</sup> | 0.7204  | 0.7204  | 0.7204  | 0.7204  |
| Velocity                        | m/s                | 7.80    | 7.28    | 7.02    | 6.86    |
| Reynolds Number                 |                    | 2152745 | 2010124 | 1937033 | 1892508 |
| Friction Factor                 | f <sub>us</sub>    | 0.02495 | 0.02495 | 0.02496 | 0.02496 |
| Dynamic Head Loss               | m H <sub>2</sub> O | 13.17   | 13.17   | 13.17   | 13.17   |
| Vacuum Relief Flowrate Required | m <sup>3</sup> /h  | 882     | 824     | 794     | 776     |

DO NOT SCALE - IF IN DOUBT ASK

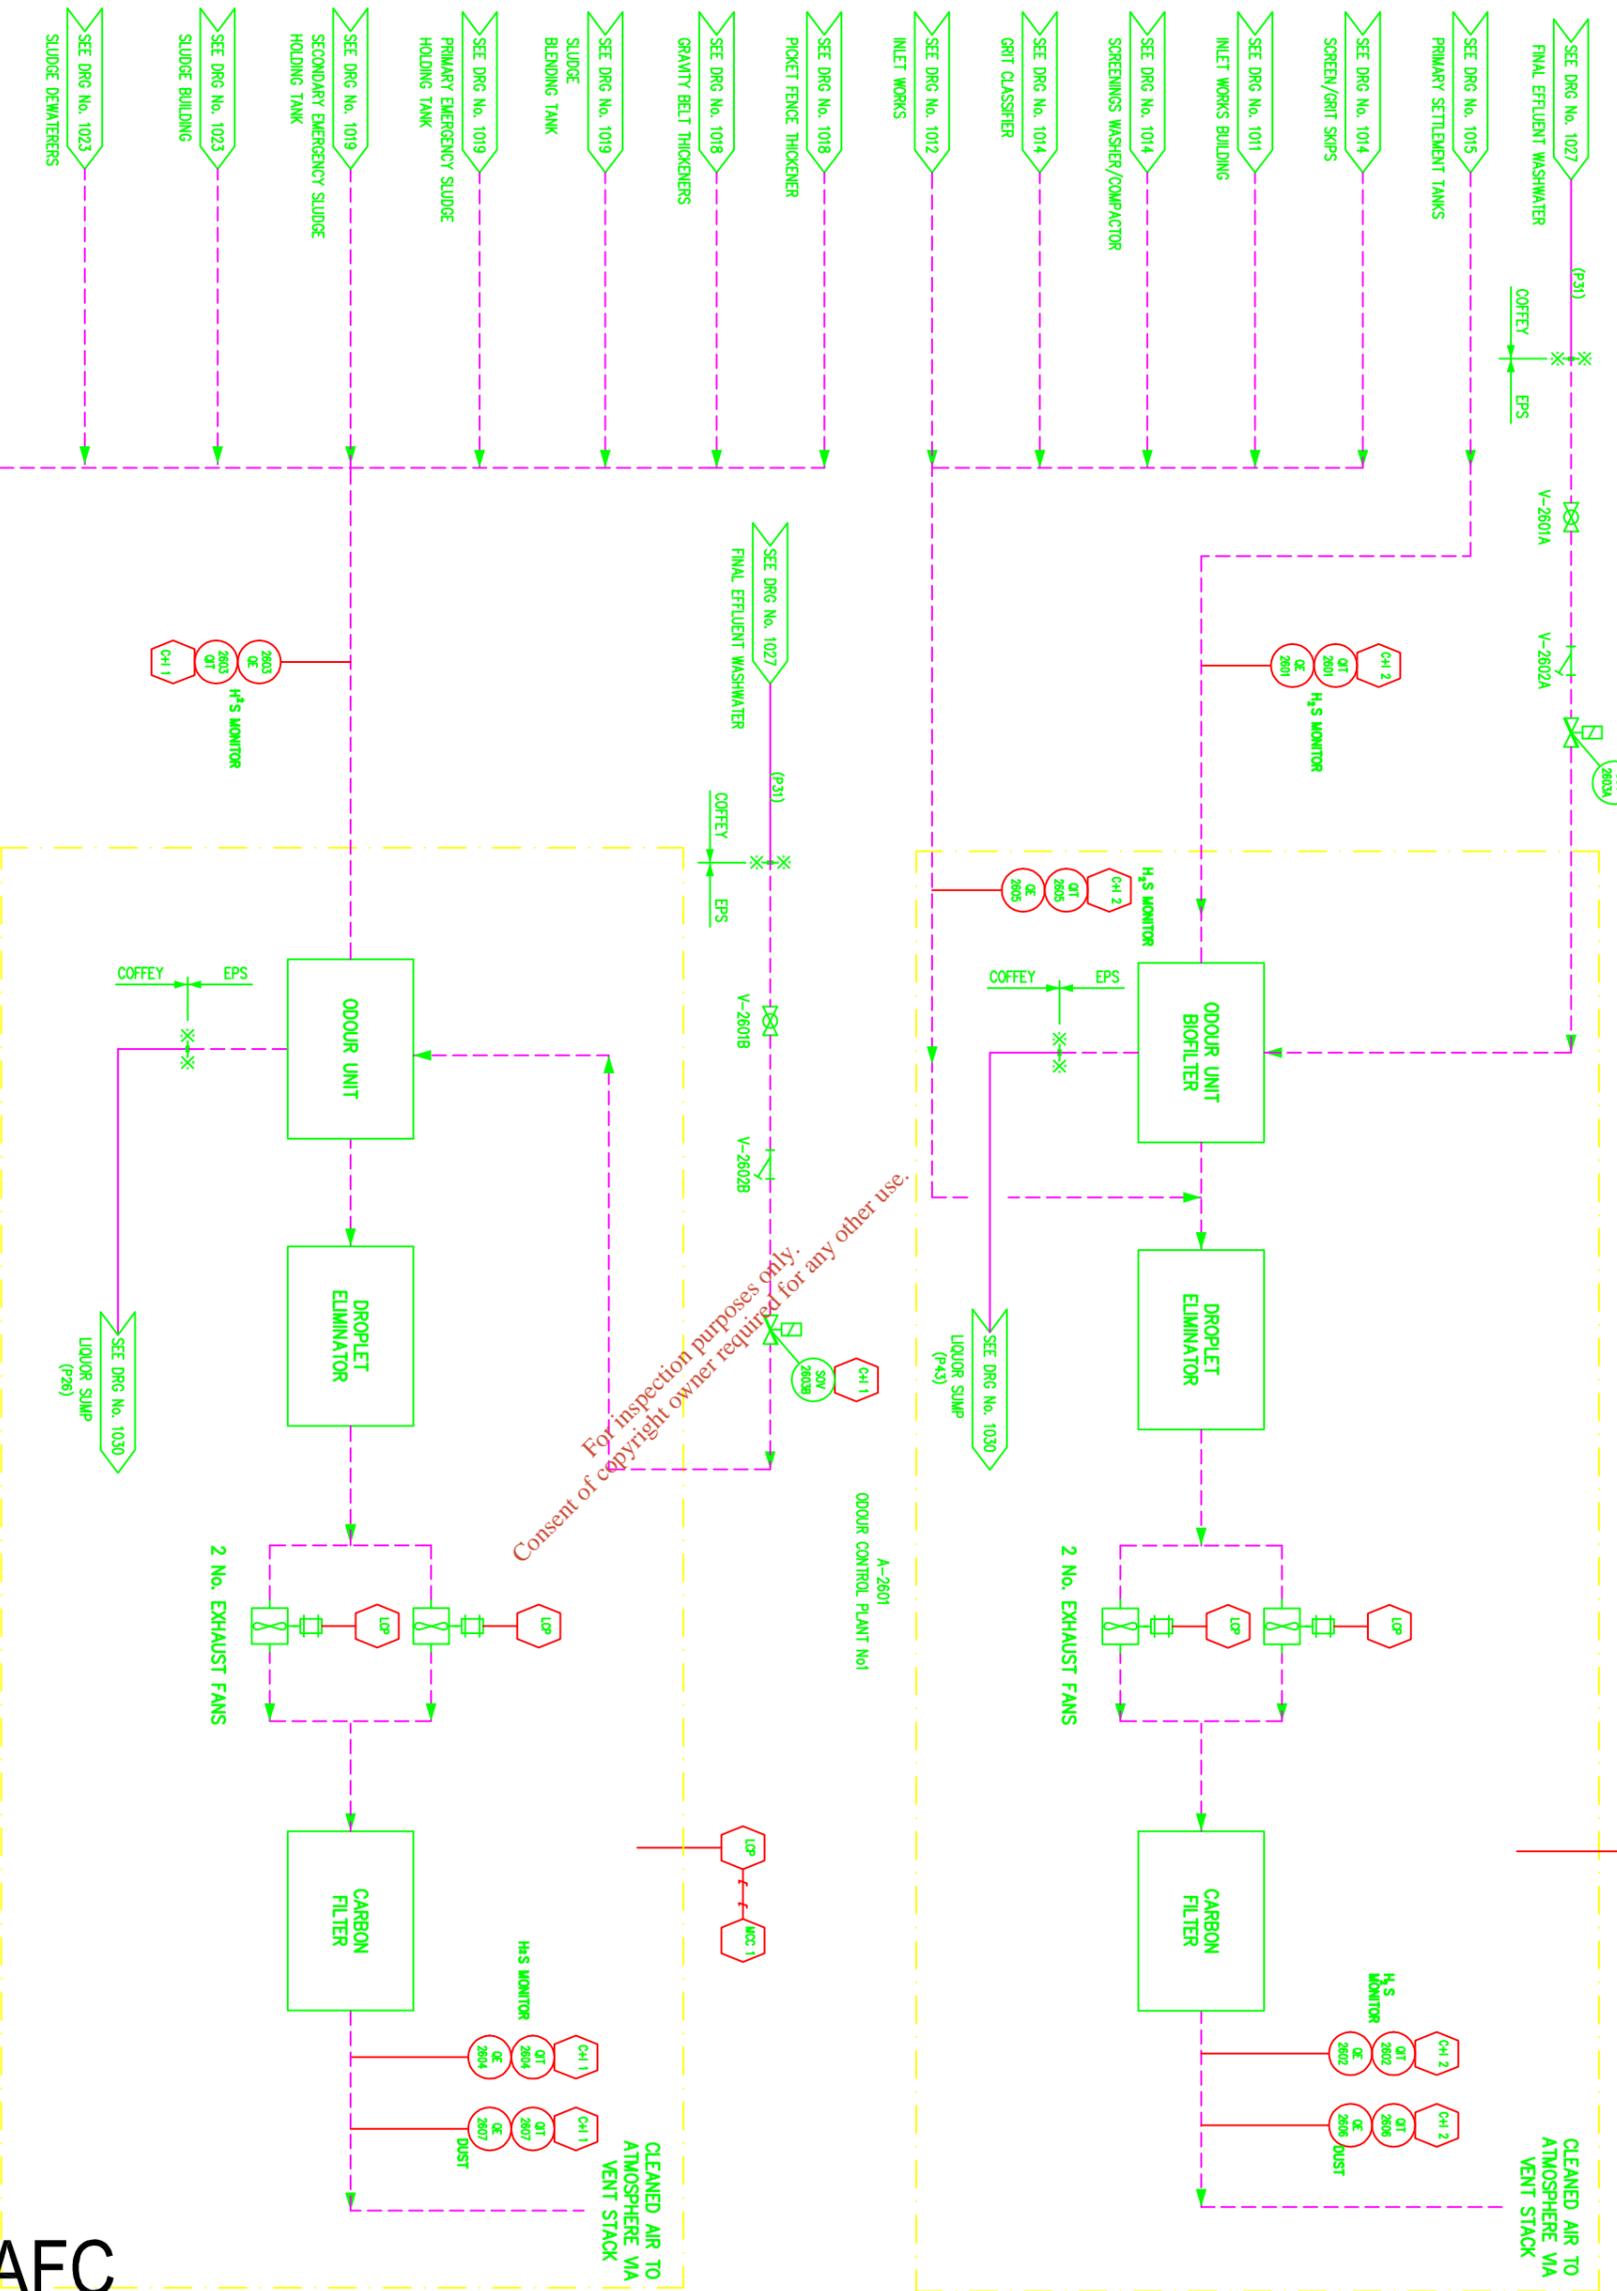

For inspection purposes only.  
Consent of copyright owner required for any other use.

See Previous Issues For Past Revision Details

| Rev | Date       | Description                      | Drawn |
|-----|------------|----------------------------------|-------|
| 1   | 27/06/2008 | UPDATED TO SUPPLIERS INFORMATION |       |

NOTES  
1. REMOVED

**LEGEND:**  
NEW PIPEWORK / CHANNEL BY CIVIS CONTRACTOR.  
NEW PIPEWORK BY MBE CONTRACTOR.

|                    |                  |                            |                  |
|--------------------|------------------|----------------------------|------------------|
| CHECKED            |                  | APPROVED                   |                  |
| PROCESS ENG. DGH   | PROJECT MAN. JMN | PROCESS ENG SPECIALIST DGG | PROJECT MAN. CGP |
| LEAD MECH ENG. JAM |                  | MECH ENG MAN. BM           |                  |
| LEAD ELEC ENG. AMT |                  | ELEC ENG MAN. JL           |                  |

A.W.I. CONTRACT No 1002



Empure Limited  
Empire House,  
Birmingham Road,  
Kidderminster, DY10 2SH,  
UK  
Tel: +44 (0)1562 820 010  
Fax: +44 (0)1562 820 008  
Internet: www.empure.co.uk

Customer  
WATERFORD CITY COUNCIL

Title  
ODOUR CONTROL  
P & I DIAGRAM  
WATERFORD WWTTW

|              |            |            |                |
|--------------|------------|------------|----------------|
| Drawn        | Checked    | Approved   | Original Size  |
| DJLittlesley | RJMiller   | RLMearns   | A1             |
| Date         | Date       | Date       | Original Scale |
| 20/10/2006   | 26/06/2008 | 27/06/2008 | NTS            |

**ISSUED AFC**

Drg. No. C1197-1026



|                           |                       |
|---------------------------|-----------------------|
| <b>PURAC Contract No.</b> | <b>C:1197</b>         |
| <b>Contract Title</b>     | <b>Waterford WwTW</b> |
| <b>PURAC Document No.</b> | <b>8419</b>           |
| <b>Date</b>               | <b>09/02/07</b>       |
| <b>Revision</b>           | <b>2</b>              |

| List/Odour Control Unit Names | P&ID no.   | Tag No. | Ave Odour concentration (OU <sub>E</sub> /m <sup>3</sup> ) | Max Odour concentration (OU <sub>E</sub> /m <sup>3</sup> ) | Ave H <sub>2</sub> S conc (ppm) | Peak H <sub>2</sub> S conc (ppm) | Air flowrate (m <sup>3</sup> /hr) |
|-------------------------------|------------|---------|--|--|---------------------------------|----------------------------------|-----------------------------------|
| Combined Treatment OCU        | C1197-1026 | TBC     | 0  | 0  | 0.0                             | 0.0                              | 0                                 |
| Inlet Treatment OCU           | C1197-1026 | TBC     | 63533  | 63533  | 0.0                             | 0.0                              | 0                                 |
| Sludge Treatment OCU          | C1197-1026 | TBC     | 97976  | 97976  | 19.2                            | 19.2                             | 13815                             |
|                               |            |         | 0  | 0  | 49.0                            | 49.0                             | 5042                              |
| Other discharges              |            |         | 0  | 0  | 0.0                             | 0.0                              | 0                                 |
|                               |            |         | 72743  | 72743  | 27.1                            | 27.1                             | 18857                             |

Check calc integrity OK OK OK OK

Orange cells require input

Areas to be odour controlled

| Process Area                      | Process Fluid    | P&ID no. & GA no.   | No. | Tag No(s)            | Air extracted to:    | Ave Odour concentration (OU <sub>E</sub> /m <sup>3</sup> ) | Max Odour concentration (OU <sub>E</sub> /m <sup>3</sup> ) | Converted average H <sub>2</sub> S conc. (ppm) | Converted peak H <sub>2</sub> S conc. (ppm) | Air flowrate (m <sup>3</sup> /hr) |
|-----------------------------------|------------------|---------------------|-----|----------------------|----------------------|--|--|--|---|-----------------------------------|
| Pre-screen and post-grit channels | Raw Sewage       | C1197-1012 & 2000/1 | 1   | T-1201               | Inlet Treatment OCU  | 131243   | 131243   | 39   | 39  | 388                               |
| Fine Screens including bypass     | Raw Sewage       | C1197-1012 & 2000/1 | 4   | A-1201A/B/C & A-1202 | Inlet Treatment OCU  | 81000  | 81000  | 24   | 24  | 704                               |
| Screenings Compactors             | Raw Sewage       | C1197-1014 & 2000/1 | 1   | A-1401               | Inlet Treatment OCU  | 80000  | 80000  | 40   | 40  | 32                                |
| Grit Classifier                   | Grit             | C1197-1014 & 2000/1 | 1   | A-1402               | Inlet Treatment OCU  | 160000   | 160000   | 80   | 80  | 32                                |
| Grit Channel                      | Raw Sewage       | C1197-1012 & 2000/1 | 2   | T-1202A/B            | Inlet Treatment OCU  | 65833  | 65833  | 20   | 20  | 1004                              |
| Preliminary Treatment Building    | N/A              | C1197-1012 & 2000/1 | 1   |                      | Inlet Treatment OCU  | 150  | 150  | 0  | 0   | 7247                              |
| Primary Sedimentation Tank        | Screened Sewage  | C1197-1015 & 2004   | 2   | T-1501A/B            | Inlet Treatment OCU  | 157664   | 157664   | 47   | 47  | 4407                              |
| Pasteuriser                       | Sludge           | C1197-1020          | 3   | T-2001A/B/C          | Sludge Treatment OCU | 630000   | 630000   | 315  | 315   | 246                               |
| Picket Fence Thickener            | Primary Sludge   | C1197-1018          | 1   | T-1801               | Sludge Treatment OCU | 420000   | 420000   | 210  | 210   | 178                               |
| Secondary Sludge Thickener        | Secondary Sludge | C1197-1018 & 2011   | 2   | A-1802A/B            | Sludge Treatment OCU | 280000   | 280000   | 140  | 140   | 60                                |
| Sludge Building                   | N/A              | C1197-1018 & 2011   | 1   |                      | Sludge Treatment OCU | 800  | 800  | 0  | 0   | 3580                              |
| Emergency Primary Sludge Tank     | Primary Sludge   | C1197-1019          | 1   | T-1903               | Sludge Treatment OCU | 315000   | 315000   | 158  | 158   | 276                               |
| Emergency Secondary Sludge Tank   | Secondary Sludge | C1197-1019          | 1   | T-1902               | Sludge Treatment OCU | 315000   | 315000   | 158  | 158   | 329                               |
| Sludge Blending Tank              | Sludge           | C1197-1019          | 1   | T-1901               | Sludge Treatment OCU | 630000   | 630000   | 315  | 315   | 41                                |
| Sludge Dewaterer                  | Sludge           | C1197-1023 & 2011   | 2   | A-2301A/B            | Sludge Treatment OCU | 96000  | 96000  | 48   | 48  | 90                                |
| Liquor Return PS                  | Sludge Liquors   | C1197-1030          | 1   | C-3001               | Sludge Treatment OCU | 78750  | 78750  | 39   | 39  | 240                               |

**C1197 - Waterford WwTW  
Ventilation, Odour Control and Declassification of Zoned Areas Calculations**

PURAC Document No. 8419

Date 09/02/2007

Revision 2

Orange cells require input

| Process Area                     | Process fluid    | No. | Vessel Shape | Working Dimensions / Details |             |              |               |             |              | Headspace / Gross Vessel Dimensions / Details |             |              |               |             |              | Process volume / Gross volume (per unit) m <sup>3</sup> | Headspace / Gross volume m <sup>3</sup> | Tank Perimeter (per unit) m | Cover Perimeter m | Actual Perimeter | Max fill rate or specified (per unit) m <sup>3</sup> /hr |
|----------------------------------|------------------|-----|--------------|------------------------------|-------------|--------------|---------------|-------------|--------------|---|-------------|--------------|---------------|-------------|--------------|---|---|-----------------------------|-------------------|------------------|--|
|                                  |                  |     |              | 52.4 m length                | 1.8 m deep  | 1.5 m width  | 52.4 m length | 0.5 m deep  | 1.5 m width  | 10 m length                                   | 1 m deep    | 2.2 m width  | 10 m length   | 1 m deep    | 2.2 m width  |   |   |                             |                   |                  |  |
| Pre-screen and post-grit channel | Raw Sewage       | 1   | Rectangular  | 52.4 m length                | 1.8 m deep  | 1.5 m width  | 52.4 m length | 0.5 m deep  | 1.5 m width  | 10 m length                                   | 1 m deep    | 2.2 m width  | 10 m length   | 1 m deep    | 2.2 m width  | 141.5   | 39.3                                    | 107.8                       | Perimeter         |                  |  |
| Fine Screens including bypass    | Raw Sewage       | 4   | Rectangular  | 10 m length                  | 2.2 m deep  | 2.2 m width  | 10 m length   | 1 m deep    | 2.2 m width  | 10 m length                                   | 1 m deep    | 2.2 m width  | 10 m length   | 1 m deep    | 2.2 m width  | 48.4  | 22.0                                    | 24.4                        | Perimeter         |                  |  |
| Screenings Compactors            | Raw Sewage       | 1   | Other        | 4 m <sup>3</sup> volume      |             |              |               |             |              |   |             |              |               |             |              | 4.0   | 4.0                                     | N/A                         | N/A               |                  |  |
| Grit Classifier                  | Grit             | 1   | Other        | 4 m <sup>3</sup> volume      |             |              |               |             |              |   |             |              |               |             |              | 4.0   | 4.0                                     | N/A                         | N/A               |                  |  |
| Grit Channel                     | Raw Sewage       | 2   | Rectangular  | 10 m length                  | 2.2 m deep  | 5.1 m width  | 10 m length   | 0.5 m deep  | 5.1 m width  | 10 m length                                   | 0.5 m deep  | 5.1 m width  | 10 m length   | 0.5 m deep  | 5.1 m width  | 112.2   | 25.5                                    | 30.2                        | Perimeter         | 400              |  |
| Preliminary Treatment Building   | N/A              | 1   | Rectangular  | 29.3 m length                | 6.38 m deep | 19.4 m width | 29.3 m length | 6.38 m deep | 19.4 m width | 29.3 m length                                 | 6.38 m deep | 19.4 m width | 29.3 m length | 6.38 m deep | 19.4 m width | 3623.7  | 3623.7                                  | 97.4                        | N/A               |                  |  |
| Primary Sedimentation Tank       | Screened Sewage  | 2   | Circular     | 32 m diam                    | 3 m deep    |              | 32 m diam     | 3 m deep    |              | 32 m diam                                     | 3 m deep    |              | 32 m diam     | 3 m deep    |              | 2412.7  | 1101.8                                  | 100.5                       | Perimeter         |                  |  |
| Pasteuriser                      | Sludge           | 3   | Other        | 41 m <sup>3</sup> volume     |             |              |               |             |              |   |             |              |               |             |              | 41.0  | 41.0                                    | N/A                         | N/A               |                  |  |
| Picket Fence Thickener           | Primary Sludge   | 1   | Circular     | 8.7 m diam                   | 4.5 m deep  |              | 8.7 m diam    | 4.5 m deep  |              | 8.7 m diam                                    | 4.5 m deep  |              | 8.7 m diam    | 4.5 m deep  |              | 267.5   | 29.7                                    | 27.3                        | Perimeter         | 8                |  |
| Secondary Sludge Thickener       | Secondary Sludge | 2   | Rectangular  | 5.6 m length                 | 0.75 m deep | 1.2 m width  | 5.6 m length  | 0.75 m deep | 1.2 m width  | 5.6 m length                                  | 0.75 m deep | 1.2 m width  | 5.6 m length  | 0.75 m deep | 1.2 m width  | 5.0   | 5.0                                     | 13.6                        | Cover             |                  |  |
| Sludge Building                  | N/A              | 1   | Rectangular  | 19.5 m length                | 6.38 m deep | 14.4 m width | 19.5 m length | 6.38 m deep | 14.4 m width | 19.5 m length                                 | 6.38 m deep | 14.4 m width | 19.5 m length | 6.38 m deep | 14.4 m width | 1790.1  | 1790.1                                  | 67.8                        | N/A               | 2                |  |
| Emergency Primary Sludge Tank    | Primary Sludge   | 1   | Circular     | 9.38 m diam                  | 5.6 m deep  |              | 9.38 m diam   | 5.6 m deep  |              | 9.38 m diam                                   | 5.6 m deep  |              | 9.38 m diam   | 5.6 m deep  |              | 387.0   | 138.2                                   | 29.5                        | Cover             |                  |  |
| Emergency Secondary Sludge Tank  | Secondary Sludge | 1   | Circular     | 10.2 m diam                  | 5.6 m deep  |              | 10.2 m diam   | 5.6 m deep  |              | 10.2 m diam                                   | 5.6 m deep  |              | 10.2 m diam   | 5.6 m deep  |              | 461.2   | 164.7                                   | 32.2                        | Cover             |                  |  |
| Sludge Blending Tank             | Sludge           | 1   | Circular     | 5.12 m diam                  | 2.9 m deep  | 2 m width    | 5.12 m diam   | 2.9 m deep  | 2 m width    | 5.12 m diam                                   | 2.9 m deep  | 2 m width    | 5.12 m diam   | 2.9 m deep  | 2 m width    | 59.7  | 20.6                                    | 16.1                        | Cover             |                  |  |
| Sludge Dewaterer                 | Sludge           | 2   | Rectangular  | 5 m length                   | 0.75 m deep | 2 m width    | 5 m length    | 0.75 m deep | 2 m width    | 5 m length                                    | 0.75 m deep | 2 m width    | 5 m length    | 0.75 m deep | 2 m width    | 7.5   | 7.5                                     | 14.0                        | Cover             |                  |  |
| Liquor Return PS                 | Sludge Liquors   | 1   | Rectangular  | 3 m length                   | 4 m deep    | 5 m width    | 3 m length    | 4 m deep    | 5 m width    | 3 m length                                    | 4 m deep    | 5 m width    | 3 m length    | 4 m deep    | 5 m width    | 60.0  | 60.0                                    | 16.0                        | Perimeter         | 240              |  |

**C1197 - Waterford WwTW**  
**Ventilation, Odour Control and Declassification of Zoned Areas Calculations**  
**PURAC Document No. 8419**

Date **09/02/2007**  
 Revision **2**

| Process Area                     | CH <sub>4</sub> rate of emission<br>m <sup>3</sup> m <sup>-3</sup> sec <sup>-1</sup> x 10 <sup>-6</sup> | Air changes per hour | Temp °C | LEL % | Density kg / m <sup>3</sup> | Grade of release | BS safety factor k | Gas production rate kg/s | Temperature corrected rate kg/s | Actual gas production rate kg/s | Calculations for zoning declassification ventilation rate |        |        |        | Safety Factor | Final rate per unit (Max X SF) m <sup>3</sup> /hr | Choose flowrate per unit | Actual flowrate per unit m <sup>3</sup> /hr | Actual air changes per hour (based on headspace) |
|----------------------------------|---|----------------------|---------|-------|-----------------------------|------------------|--------------------|--------------------------|---------------------------------|---------------------------------|---|--------|--------|--------|---------------|---|--------------------------|---|--|
|                                  |   |                      |         |       |                             |                  |                    |                          |                                 |                                 | Rate 1  | Rate 2 | Rate 3 | Rate 4 |               |   |                          |   |  |
| Pre-screen and post-grit channel | 6.9   | 8.0                  | 20      | 5.3   | 0.72                        | Secondary        | 0.5                | 7.03E-06                 | 5.35E-06                        | Corrected                       | 388.1   | 1.1    | N/A    | 314.4  | 0%            | 388.1   | Max xSF                  | 388.1                                       | 9.9  |
| Fine Screens including bypass    | 6.9   | 8.0                  | 20      | 5.3   | 0.72                        | Secondary        | 0.5                | 2.40E-06                 | 1.83E-06                        | Corrected                       | 87.8  | 0.4    | N/A    | 176.0  | 0%            | 176.0   | Max xSF                  | 176.0                                       | 8.0  |
| Screenings Compactors            | 0.0   | 8.0                  | 20      | 5.3   | 0.72                        | Secondary        | 0.5                | 0.00E+00                 | 0.00E+00                        | Corrected                       | N/A   | 0.0    | N/A    | 32.0   | 0%            | 32.0  | Max xSF                  | 32.0  | 8.0  |
| Grit Classifier                  | 0.0   | 8.0                  | 20      | 5.3   | 0.72                        | Secondary        | 0.5                | 0.00E+00                 | 0.00E+00                        | Corrected                       | N/A   | 0.0    | N/A    | 32.0   | 0%            | 32.0  | Max xSF                  | 32.0  | 8.0  |
| Grit Channel                     | 6.9   | 4.0                  | 20      | 5.3   | 0.72                        | Secondary        | 0.5                | 5.57E-06                 | 4.25E-06                        | Corrected                       | 108.7   | 0.9    | 400.0  | 102.0  | 26%           | 502.0   | Max xSF                  | 502.0                                       | 19.7   |
| Preliminary Treatment Building   | 0.0   | 2.0                  | 20      | 5.3   | 0.72                        | Secondary        | 0.5                | 0.00E+00                 | 0.00E+00                        | Corrected                       | N/A   | 0.0    | N/A    | 7247.4 | 0%            | 7247.4  | Max xSF                  | 7247.4                                      | 2.0  |
| Primary Sedimentation Tank       | 6.9   | 2.0                  | 20      | 5.3   | 0.72                        | Secondary        | 0.5                | 1.20E-04                 | 9.13E-05                        | Corrected                       | 361.9   | 18.6   | N/A    | 2203.6 | 0%            | 2203.6  | Max xSF                  | 2203.6                                      | 2.0  |
| Pasteuriser                      | 163.0   | 2.0                  | 55      | 5.3   | 0.72                        | Secondary        | 0.5                | 4.81E-05                 | 6.07E-05                        | Corrected                       | N/A   | 13.9   | N/A    | 82.0   | 0%            | 82.0  | Max xSF                  | 82.0  | 2.0  |
| Picket Fence Thickener           | 289.0   | 6.0                  | 20      | 5.3   | 0.72                        | Secondary        | 0.5                | 5.57E-04                 | 4.24E-04                        | Corrected                       | 98.4  | 86.5   | 8.0    | 178.3  | 0%            | 178.3   | Max xSF                  | 178.3                                       | 6.0  |
| Secondary Sludge Thickener       | 163.0   | 6.0                  | 20      | 5.3   | 0.72                        | Secondary        | 0.5                | 5.91E-06                 | 4.50E-06                        | Corrected                       | 0.0   | 0.9    | N/A    | 30.2   | 0%            | 30.2  | Max xSF                  | 30.2  | 6.0  |
| Sludge Building                  | 0.0   | 2.0                  | 20      | 5.3   | 0.72                        | Secondary        | 0.5                | 0.00E+00                 | 0.00E+00                        | Corrected                       | N/A   | 0.0    | 2.0    | 3580.2 | 0%            | 3580.2  | Max xSF                  | 3580.2                                      | 2.0  |
| Emergency Primary Sludge Tank    | 289.0   | 2.0                  | 20      | 5.3   | 0.72                        | Secondary        | 0.5                | 8.08E-04                 | 6.13E-04                        | Corrected                       | 0.0   | 125.2  | N/A    | 276.4  | 0%            | 276.4   | Max xSF                  | 276.4                                       | 2.0  |
| Emergency Secondary Sludge Tank  | 163.0   | 2.0                  | 20      | 5.3   | 0.72                        | Secondary        | 0.5                | 5.41E-04                 | 4.12E-04                        | Corrected                       | 0.0   | 84.1   | N/A    | 329.4  | 0%            | 329.4   | Max xSF                  | 329.4                                       | 2.0  |
| Sludge Blending Tank             | 289.0   | 2.0                  | 20      | 5.3   | 0.72                        | Secondary        | 0.5                | 1.24E-04                 | 9.46E-05                        | Corrected                       | 0.0   | 19.3   | N/A    | 41.2   | 0%            | 41.2  | Max xSF                  | 41.2  | 2.0  |
| Sludge Dewaterer                 | 110.0   | 6.0                  | 20      | 5.3   | 0.72                        | Secondary        | 0.5                | 5.94E-06                 | 4.52E-06                        | Corrected                       | 0.0   | 0.9    | N/A    | 45.0   | 0%            | 45.0  | Max xSF                  | 45.0  | 6.0  |
| 0                                | 0.0   | 2.0                  | 20      | 5.3   | 0.72                        | Secondary        | 0.5                | 0.00E+00                 | 0.00E+00                        | Corrected                       | N/A   | 0.0    | N/A    | 0.0    | 0%            | 0.0   | Max xSF                  | 0.0   | #DIV/0!  |
| Liquor Return PS                 | 110.0   | 2.0                  | 20      | 5.3   | 0.72                        | Secondary        | 0.5                | 4.75E-05                 | 3.62E-05                        | Corrected                       | 57.6  | 7.4    | 240.0  | 120.0  | 0%            | 240.0   | Max xSF                  | 240.0                                       | 4.0  |

**C1197 - Waterford WwTW  
Ventilation, Odour Control and Declassification of Zoned Areas Calculations**

PURAC Document No. 8419

Date 09/02/2007

Revision 2

| Process Area                      | OU concentration calculation                              |   |  |   |  |  | Final Calculated Odour, H <sub>2</sub> S and airflow rates                 |   |  |   |  |   |   |                                  |
|-----------------------------------|---|---|--|---|--|--|--|---|--|---|--|---|---|----------------------------------|
|                                   | Frechen data<br>E <sub>f</sub> (OU / s / m <sup>2</sup> ) | North data<br>E <sub>n</sub> (OU / s / m <sup>2</sup> ) | UKWIR value<br>OU <sub>E</sub> ·s <sup>-1</sup> ·m <sup>-2</sup> | Surface area<br>per tank<br>A (m <sup>2</sup> ) | Superficial air<br>velocity<br>V (m / s) | Emission rate<br>E <sub>tot</sub> (OU / s) | Specified<br>Odour<br>concentration<br>(OU <sub>E</sub> / m <sup>3</sup> ) | Odour<br>concentration<br>(OU <sub>E</sub> / m <sup>3</sup> ) | Chosen H <sub>2</sub> S<br>correlation<br>factor<br>ppb H <sub>2</sub> S/OU <sub>E</sub> | Direct H <sub>2</sub> S<br>correlation<br>(ppm) | Factor of<br>safety<br>(peaking<br>factor) | Odour<br>concentration<br>using SF<br>(OU <sub>E</sub> / m <sup>3</sup> ) | Estimated H <sub>2</sub> S conc.<br>using SF<br>(ppm) | Total flow<br>m <sup>3</sup> /hr |
| Pre-screen and post-grit channels |   |   | 180  | 78.6  | 0.004                                    | 14148                                      |  | 131243  | 0.3  | 39.4  | 1.0  | 131243  | 39.4  | 388                              |
| Fine Screens including bypass     |   |   | 180  | 22.0  | 0.002                                    | 3960                                       |  | 81000   | 0.3  | 24.3  | 1.0  | 81000   | 24.3  | 704                              |
| Screenings Compactors             |   |   | 180  | N/A   | N/A                                      | N/A  | 80000  | 80000   | 0.5  | 40.0  | 1.0  | 80000   | 40.0  | 32                               |
| Grit Classifier                   |   |   | 360  | N/A   | N/A                                      | N/A  | 160000   | 160000  | 0.5  | 80.0  | 1.0  | 160000  | 80.0  | 32                               |
| Grit Channel                      |   |   | 180  | 51.0  | 0.003                                    | 9180                                       |  | 65833   | 0.3  | 19.7  | 1.0  | 65833   | 19.7  | 1004                             |
| Preliminary Treatment Building    |   |   |  | 568.4   | 0.004                                    | 0  | 150  | 150   | 0.3  | 0.05  | 1.0  | 150   | 0.05  | 7247                             |
| Primary Sedimentation Tank        |   |   | 120  | 804.2   | 0.001                                    | 96510                                      |  | 157664  | 0.3  | 47.3  | 1.0  | 157664  | 47.3  | 4407                             |
| Pasteuriser                       |   |   | 480  | N/A   | N/A                                      | N/A  | 630000   | 630000  | 0.5  | 315.0   | 1.0  | 630000  | 315.0   | 246                              |
| Picket Fence Thickener            |   |   | 350  | 59.4  | 0.001                                    | 20806                                      |  | 420000  | 0.5  | 210.0   | 1.0  | 420000  | 210.0   | 178                              |
| Secondary Sludge Thickener        |   |   | 350  | 6.7   | 0.001                                    | 2352                                       |  | 280000  | 0.5  | 140.0   | 1.0  | 280000  | 140.0   | 60                               |
| Sludge Building                   |   |   |  | 280.8   | 0.004                                    | 0  | 800  | 800   | 0.5  | 0.4   | 1.0  | 800   | 0.4   | 3580                             |
| Emergency Primary Sludge Tank     |   |   | 350  | 69.1  | 0.001                                    | 24186                                      |  | 315000  | 0.5  | 157.5   | 1.0  | 315000  | 157.5   | 276                              |
| Emergency Secondary Sludge Tank   |   |   | 350  | 82.4  | 0.001                                    | 28824                                      |  | 315000  | 0.5  | 157.5   | 1.0  | 315000  | 157.5   | 329                              |
| Sludge Blending Tank              |   |   | 350  | 20.6  | 0.001                                    | 7206                                       |  | 630000  | 0.5  | 315.0   | 1.0  | 630000  | 315.0   | 41                               |
| Sludge Dewaterer                  |   |   | 120  | 10.0  | 0.001                                    | 1200                                       |  | 96000   | 0.5  | 48.0  | 1.0  | 96000   | 48.0  | 90                               |
| 0.0                               |   |   |  | 0.0   | 0.000                                    | 0  | 0  | 0   | 0.2  | 0.0   | 1.0  | 0   | 0.0   | 0                                |
| Liquor Return PS                  |   |   | 350  | 15.0  | 0.004                                    | 5250                                       |  | 78750   | 0.5  | 39.4  | 1.0  | 78750   | 39.4  | 240                              |
|                                   |   |   |  |   |  |  |  | 72742.7   |  | 27.1  |  | 72742.7   | 27.1  | 18857                            |